

CONSTRUCTION SUMMARY
Palmetto - Zadorra Estates Corp.

PURCHASER: INVENTORY LOT_57 TEL:

LOT / PHASE 57 / 1	REG. PLAN # 40M-2763	HOUSE TYPE Rose 3 Elev 3		
-----------------------	-------------------------	-----------------------------	--	--


ELECTRICAL

1 - DELETE STANDARD CEILING LIGHTS IN MAIN HALL AND SIDE HALL TO ACCOMODATE POTLIGHTS 20Jan25 Note:	
1 - PLUG - ELECTRICAL PLUG - TO BE INSTALLED OVER FIREPLACE 20Jan25 Note:	
1 - ABOVE KITCHEN ISLAND - ADD LIGHT AND SWITCH - NO FIXTURE INCLUDED 20Jan25 Note:	
1 - RELOCATE STANDARD KITCHEN LIGHT TO BE CENTERED OVER ISLAND 20Jan25 Note:	
1 - POT LIGHT - LED - FIRST FLOOR INSTALLATION MIAN HALL X5 OFFICE X4 KITCHEN X6 DINING ROOM X4 FAMILY ROOM X4 BREAKFAST X4 20Jan25 Note:	

This Document is Extremely Time Sensitive - Printed 20 Jan 25 at 11:45

up grade electrical

RECEIVED
JAN 20 2025

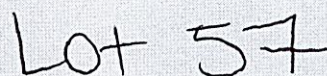

Orientation of home may be reversed and purchaser agrees to accept the same.