

CONSTRUCTION SUMMARY - PARTIAL ONLY

Legacy Hill - Trinigroup Development Inc.

PURCHASERS: Chun Hon PAK and Hiu Pui LAM

RECEIVED

APR 23 2025

TEL:

LOT NUMBER	PHASE	HOUSE TYPE	REG. PLAN #		
73	1	Villa 6 Elev 3	65M-4818		

INV#	QTY	EXTRA / CHANGE
------	-----	----------------

CABINETRY

30,248 04Mar25	1 - KITCHEN - SHIFT FRIDGE TO ACCOMODATE BUILT INS Note:
30,326 23Apr25	1 - KITCHEN CABINETRY - RELOCATE BANK OF DRAWERS TO ISLAND NEXT TO RECYCLE PULL OUT Note: SEE SKETCH NEW 
30,185 28Feb25	1 - CABINETRY - KITCHEN - UPGRADE 6 Note:
30,185 28Feb25	1 - KITCHEN CABINETRY HARDWARE - DELETE HARDWARE NO HOLES DRILLED Note:
30,185 28Feb25	1 - KITCHEN ISLAND - ADD APPROX. 2 FEET OF BASE CABINETS TO ISLAND AS PER SKETCH NoteINCLUDES UPGRADE 6 CABINETRY AND QUARTZ COUNTERTOP
30,185 28Feb25	2 - CABINETRY PROVISION - PROVISION FOR PLUG ON ISLAND (PLUG EXTRA ORDERED SEPARATELY) NotePLUG TO BE INSTALLED ON DUMMY DOORS SIDE OF ISLAND INSTALLED HORIZONTALLY AS HIGH AS POSSIBLE TO KITCHEN COUNTERTOP (IF CONSTRUCTION PERMITS)
30,185 28Feb25	1 - KITCHEN - FLUSH INSTALL FOR FRIDGES & FREEZER Note:


CABINETRY ACCESSORIES

30,185 28Feb25	1 - KITCHEN CABINETRY UPPER - FULL DEPTH ABOVE FRIDGE UPPER WITH GABLES - 650MM DEEP - PRICE IS EACH NoteX2 FRIDGE X1 FREEZER SIDE BY SIDE SEE SKETCH AND SPECS
30,185 28Feb25	1 - KITCHEN CABINETRY - BUILT-IN FRIDGE/FREEZER FEE - PRICE IS EACH Note:
30,185 28Feb25	1 - KITCHEN CABINETRY - APPLIANCE DOOR PANELS - FRIDGE & FREEZER DOOR PANELS - SUPPLY ONLY, INSTALLATION NOT INCLUDED, HARDWARE NOT INCLUDED - UPGRADE 6 Note:
30,185 28Feb25	1 - KITCHEN CABINETRY - BUILT-IN MICROWAVE/OVEN COMBO WITH ONE POT DRAWER - UPGRADE 6 Note:
30,185 28Feb25	1 - KITCHEN CABINETRY BASE - COOKTOP CABINET WITH POT DRAWERS (2 DRAWERS) - UPGRADE 6 Note:
30,185 28Feb25	1 - KITCHEN CABINETRY - APPLIANCE DOOR PANELS - 24" DISHWASHER DOOR PANEL (SUPPLY ONLY, INSTALLATION NOT INCLUDED, HARDWARE NOT INCLUDED) - UPGRADE 6 Note:
30,185 28Feb25	1 - CABINETRY FEE FOR FLUSH CUTOUT ON WALL OVEN/MICROWAVE COMBO CABINET ONLY Note:

FILE NAME: TRINIGROUP LOT 73-APR 1 25

MAR 6 25
PAULINE
REV APR 1 25 PB

PROTOTYPE FOR EXTRAS

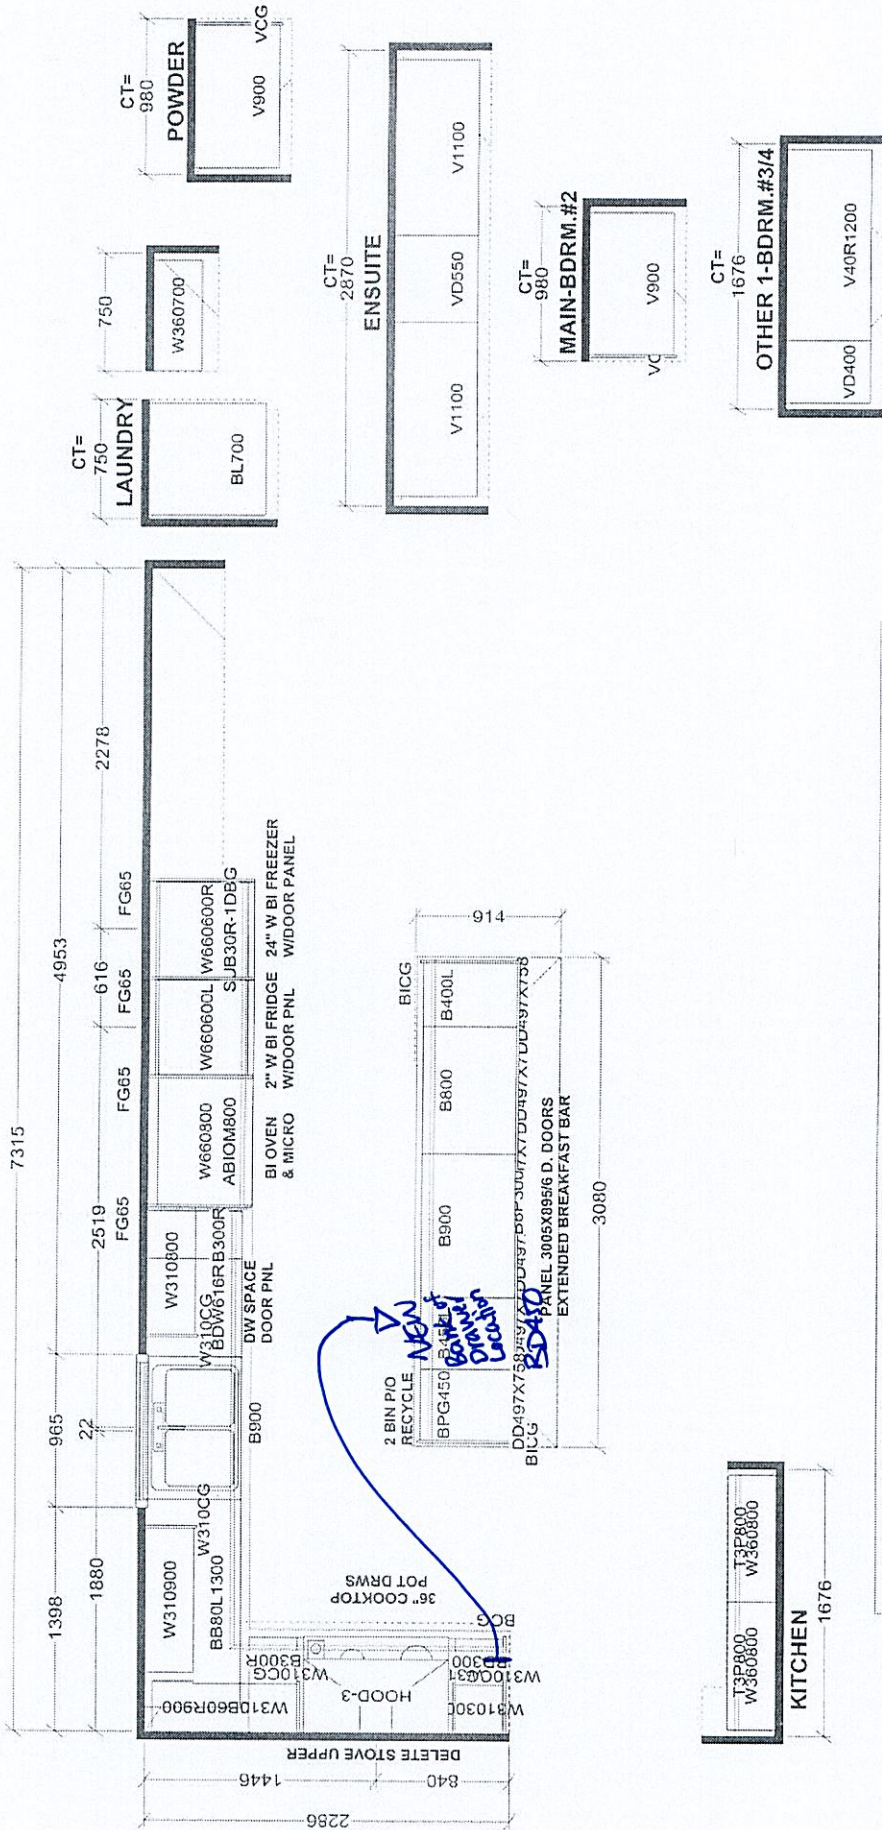

S e l b a I n d u s t r i e s					J #
W W D T H	W H G H T	W C N T	This drawing is the intellectual property of _____ an original design which must not be released or copied unless applicable fee has been paid or job order placed.		
FLOOR H G H T	DOOR H G H T		JOB NUMBER: _____ BUILDER: GREENPARK HOMES		
ST C E N T	2 X 4	V E N T B O X C O V E R		SITE: TRINI GROUP, Richmond Hill	
		DESIGNER: K S		MODEL: VILLA 6X EL 1,2,3	
		DATE: OCT 19 23		LOT #:	



New Bank
of Drawer
Location

This drawing is the intellectual property of SELBA INDUSTRIES INC. and is an artistic interpretation of the general appearance of the design. It is not meant to be an exact rendition.		 Kitchen + Bath Design	Designed: 4/1/2025 Printed: 4/1/2025
TRINIGROUP LOT 73-APR 1 25		LAYOUT	INSIDE ISLAND VIEW Drawing #: 1

April 23/25