

LOT 73  
TRINIGROUP  
LEGACY HILL  
CITY OF RICHMOND HILL

VILLA 6  
ELEVATION 3


REVISIONS:

- FAMILY ROOM – WAFFLE CEILING INSTEAD OF COFFERED CEILING AS PER SKETCH
- HOME OFFICE: ADD WAFFLE CEILING AS PER SKETCH

Standard light locations for Family + Home Office

RECEIVED

JUL 04 2025

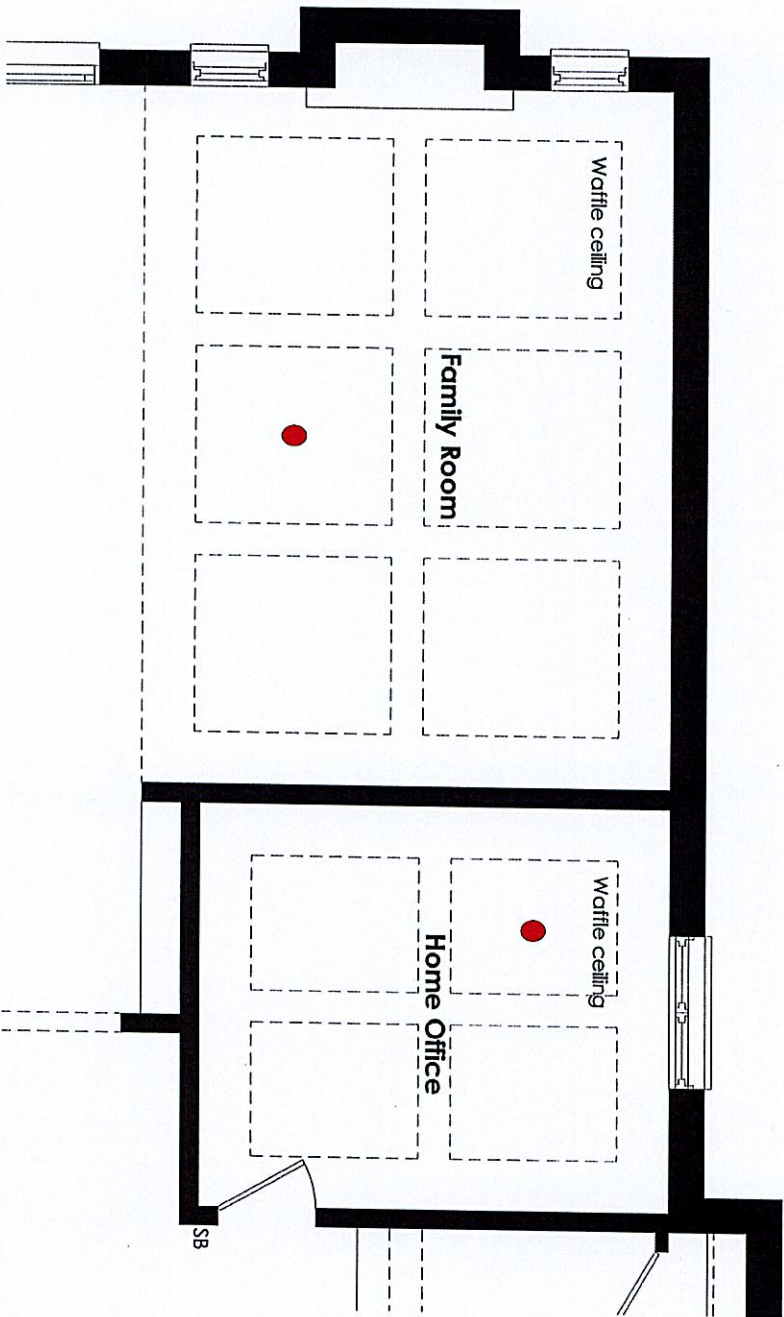

MAIN LEVEL

DISCLAIMERS: SKETCH NOT TO SCALE. DIMENSIONS, SPECIFICATIONS AND ARCHITECTURAL DETAILS SUBJECT TO MODIFICATION BY THE VENDOR. SKETCH IS ONLY FOR THE PURPOSE OF ILLUSTRATING REVISIONS REQUESTED BY THE PURCHASER AND ALL REVISIONS ARE SUBJECT TO VENDOR'S FINAL APPROVAL. ONLY REVISIONS ACCEPTED IN WRITING BY THE PURCHASER AND VENDOR ON A PURCHASER'S EXTRA SHEET WILL BE INCORPORATED INTO THE PLANS FILED WITH THE MUNICIPALITY. E. & O.E.

REGION  
DESIGN  
INC.

SCALE  
BY  
VG  
PAGE No.  
1 OF 1

