

CONSTRUCTION SUMMARY - PARTIAL ONLY

Legacy Hill - Trinigroup Development Inc.

RECEIVED

JUL 24 2025

PURCHASER: XIUDAN WANG

TEL:

LOT NUMBER	PHASE	HOUSE TYPE	REG. PLAN #		
88	1	Villa 12 Elev 2	65M-4818		
INV#	QTY	EXTRA / CHANGE			

REVISED KITCHEN
URGENT NEW - SELBA

Offer	Note:
-------	-------


CABINETRY

30,404 23Jul25	1 - DELETE DOUBLE HEADER CROWN MOLDING CM11 AS PER SELBA DOES NOT FIT INSERT 868 MINI UPPERS WITH MODIFIED CROWN & HEADER Note: See Sketch attached
29,908 16Jul24	1 - CABINETRY PROVISION - PROVISION FOR PLUG ON ISLAND (PLUG EXTRA ORDERED SEPARATELY) Note:
30,273 25Mar25	1 - CABINETRY - KITCHEN - UPGRADE 2 Note:
30,273 25Mar25	1 - KITCHEN CABINETRY - MINI STACKED UPPER CABINETS - UPGRADE 2 - KITCHEN (BASED ON STANDARD PLAN) Note:
30,273 25Mar25	1 - CABINETRY - KITCHEN - CROWN MOULDING WITH HEADER - CM11 Note:
30,273 25Mar25	1 - CABINETRY - MASTER ENSUITE VANITY - UPGRADE 1 Note:

This Document is Extremely Time Sensitive - Printed 24 Jul 25 at 8:57


TRINI Group Lot 88

cut

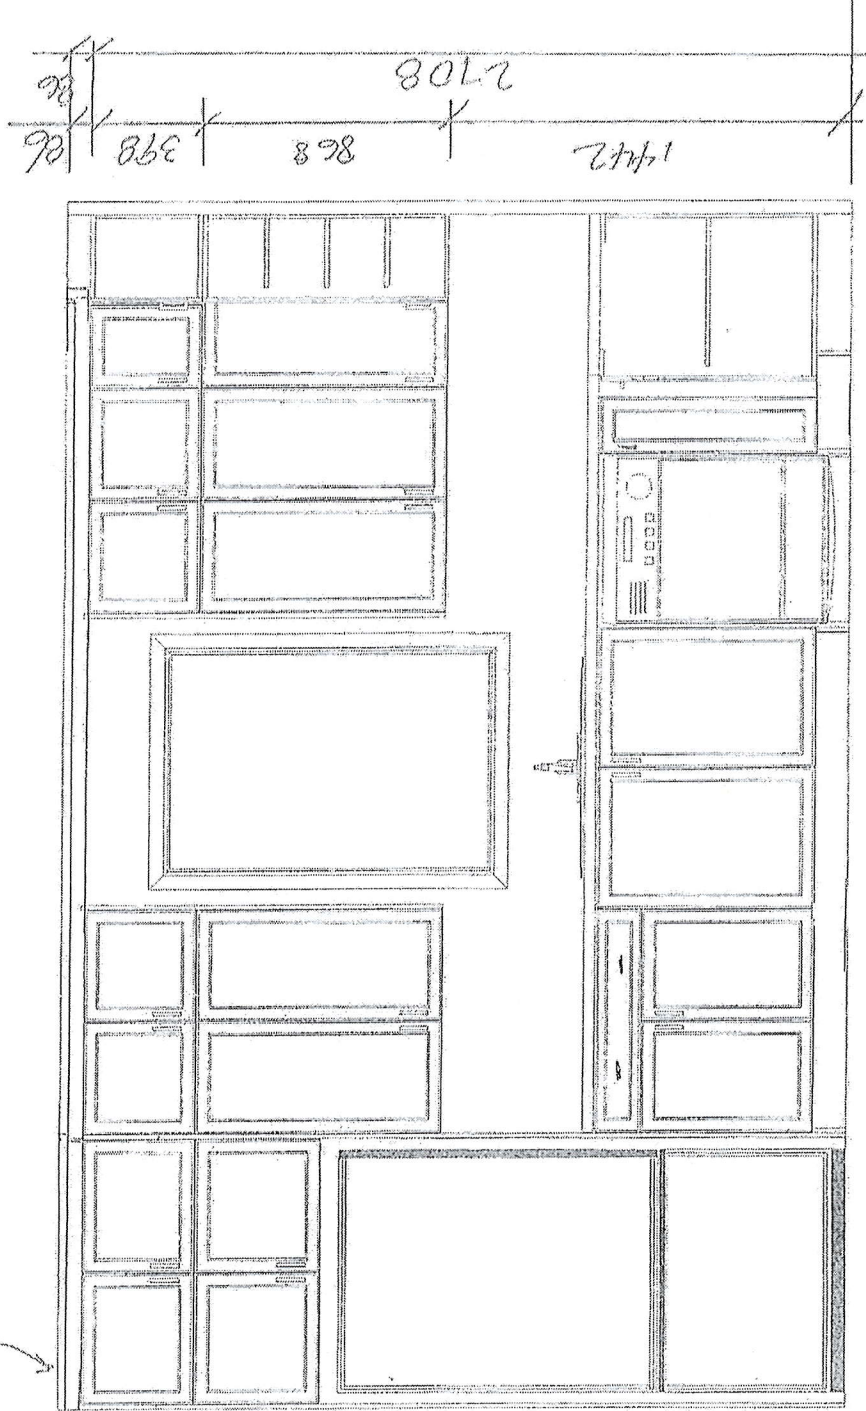

This drawing is the intellectual property of SELBA INDUSTRIES INC. , and is an artistic interpretation of the general appearance of the design. It is not meant to be an exact rendition.	 Kitchen + Bath Designs	Designed: 7/14/2025 Printed: 7/14/2025
	2	
2504026	LAYOUT	Drawing #: 1

TRINI GLOWP
Lot 88

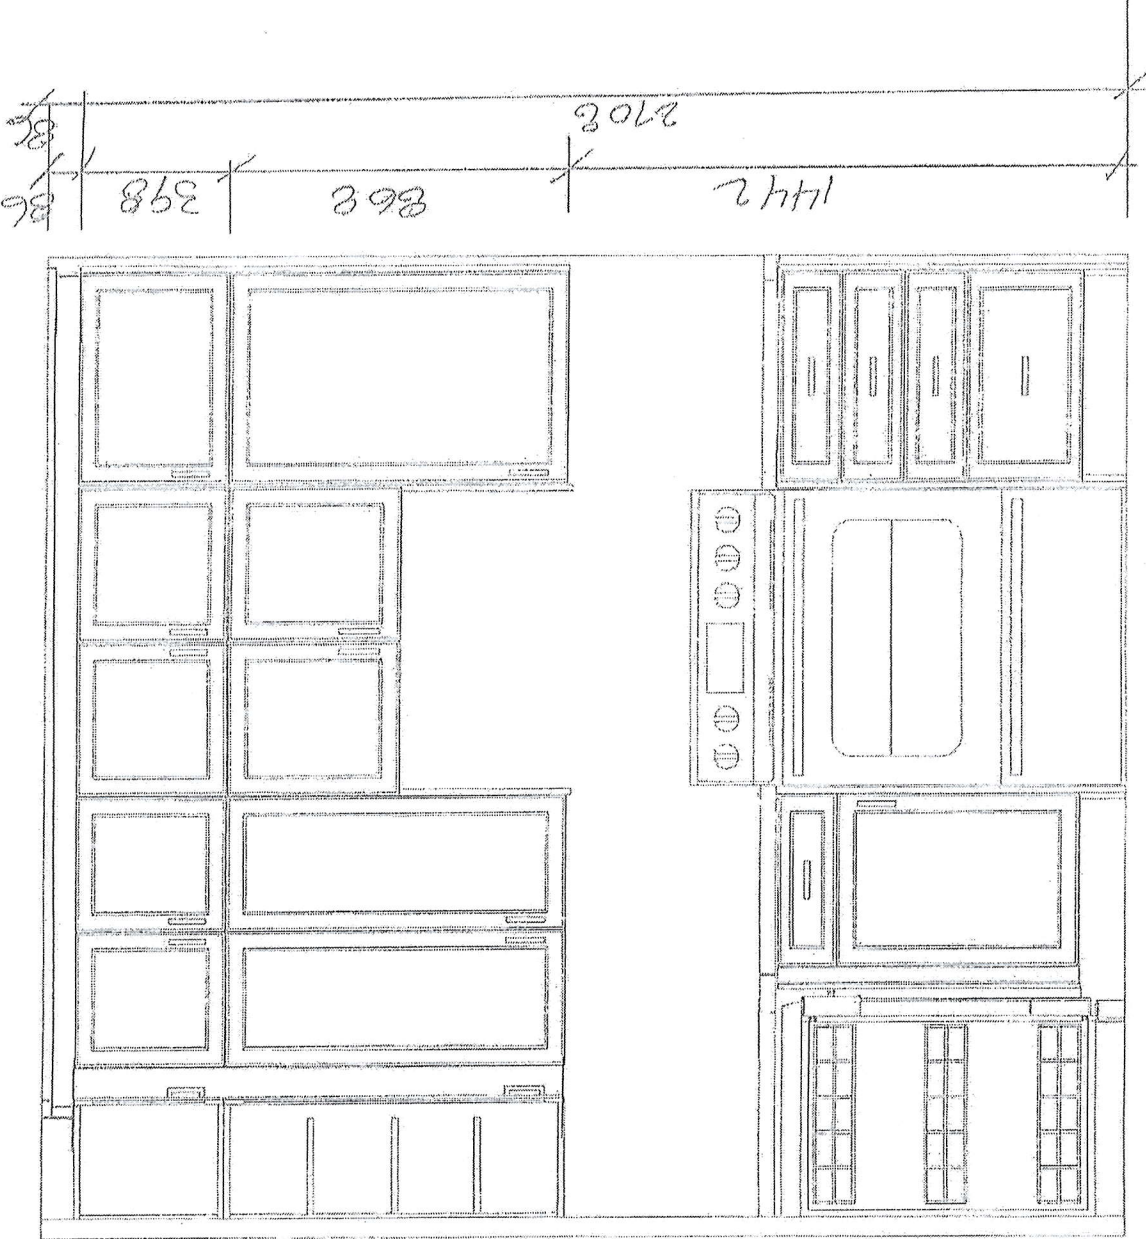

This drawing is the intellectual property of
SELBA INDUSTRIES INC. and is an
artistic
interpretation of the general
appearance of the design. It is
not meant to be an exact rendition.



Designed: 7/14/2025
Printed: 7/14/2025

2


2504026

LAYOUT

Drawing #: 1

16111 Group
Lot 48

2708

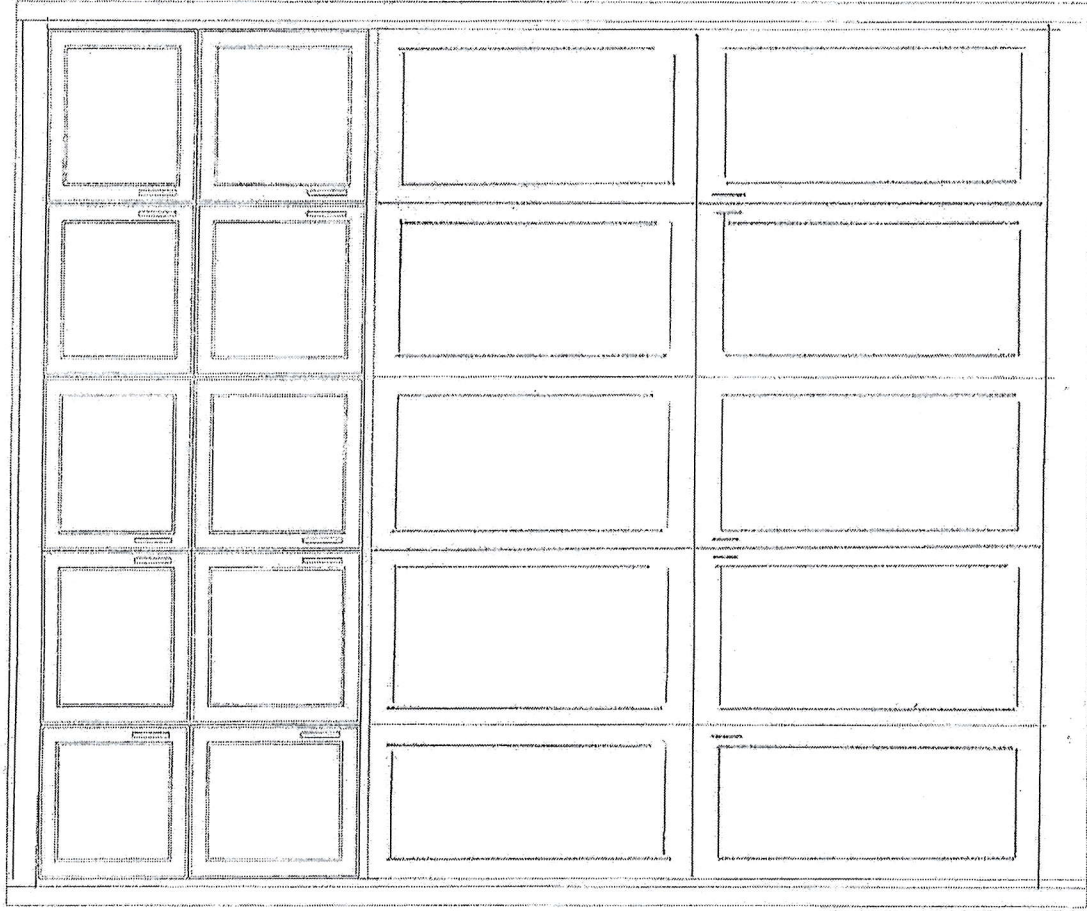

2708

This drawing is the intellectual property of
SELBA INDUSTRIES INC. and is an
artistic
interpretation of the general
appearance of the design. It is
not meant to be an exact rendition.



Kitchen + Bath Designs

Designed: 7/14/2025
Printed: 7/14/2025

2

2504026

LAYOUT

Drawing #: 1