


It is the builder's complete responsibility to ensure that all plans submitted for approval fully comply with the Architectural Guidelines and all applicable regulations and requirements including zoning provisions and any provisions in the subdivision agreement. The Control Architect is not responsible in any way for examining or approving site (lotting) plans or working drawings with respect to any zoning or building code or permit matter or that any house can be properly built or located on its lot.

This is to certify that these plans comply with the applicable Architectural Design Guidelines approved by the City of BRAMPTON.

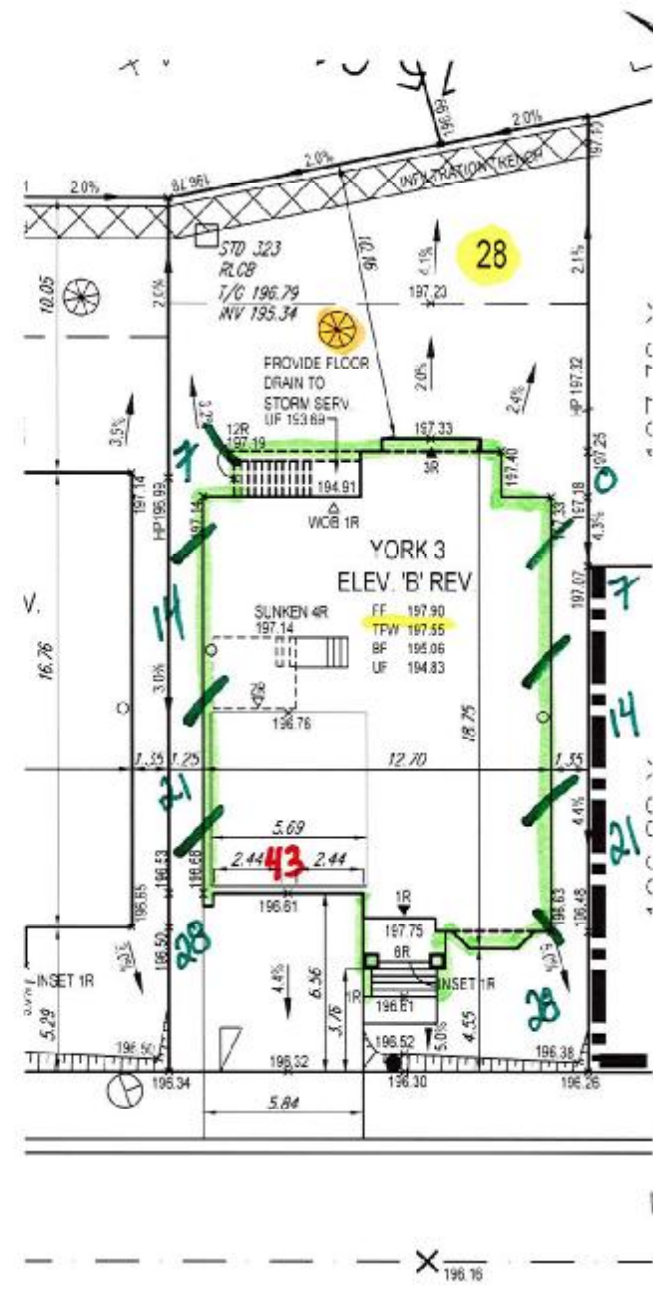

SITE PLAN REVIEW

LOT NO. 28 REGISTERED PLAN 43M-2013

THE PROPOSED LOT GRADING AND DRAINAGE IS APPROVED AS BEING IN CONFORMITY WITH THE OVERALL APPROVED GRADING PLANS FOR THE SUBDIVISION.

THIS REVIEW DOES NOT WARRANT THAT OTHER INFORMATION SHOWN ON THIS DRAWING IS ACCURATE OR COMPLETE. SOLE RESPONSIBILITY FOR THE DESIGN AND DETAILS SHALL REMAIN WITH THE DESIGNER.

NO COMMENT REVIEWED BY SK
COMMENTS AS NOTED DATE May 23, 2017

CANDEVCON LIMITED
CONSULTING ENGINEERS AND PLANNERS

NOTES

- THE PROPOSED ELEVATIONS AT BUILDINGS AND THE BASIC DIRECTION OF SURFACE DRAINAGE WILL BE SUBJECT TO DETAILED DESIGN WHEN HOUSE TYPES AND PLOT PLANS ARE AVAILABLE.
- REAR TO FRONT DRAINAGE CAN BE ACCOMMODATED ONLY IF THE SEPARATION BETWEEN UNITS IS 2.4M.
- THE HOUSE TYPE AND DRIVEWAY LOCATION SHALL NOT BE CHANGED WITHOUT CITY OF BRAMPTON APPROVAL.
- WHERE POSSIBLE DOWNSPOUTS SHALL DISCHARGE TO THE GROUND SURFACE VIA SPLASH PADS TO THE FRONT OF THE HOUSE.
- A MINIMUM AREA OF 5.0M SHALL BE GRADED AT 2% AT THE REAR OF THE HOUSE.
- A MINIMUM AREA OF 1.5M SHALL BE GRADED AT 2% AT THE REAR OF THE HOUSE FOR REVERSE FRONTAGE LOTS.
- A MINIMUM CLEARANCE OF 0.15M MUST BE PROVIDED BETWEEN THE BRICK LINE AND THE FINAL TOP OF GROUND ELEVATION AT THE HOUSE.
- A MINIMUM CLEARANCE OF 0.25M MUST BE PROVIDED BETWEEN THE SIDING AND THE FINAL TOP OF GROUND ELEVATION AT THE HOUSE.
- ALL LOT GRADING MUST COMPLY WITH CITY OF BRAMPTON STANDARDS 420 AND 421 UNLESS OTHERWISE NOTED.
- DRIVEWAYS SHALL BE GRADED AT MINIMUM OF 2% AND A MAXIMUM OF 8% SLOPE.
- A 0.3M SEPARATION SHALL BE PROVIDED BETWEEN DRIVEWAYS.
- ALL AREAS BEYOND THE PLAN OF SUBDIVISION WHICH ARE DISTURBED DURING CONSTRUCTION SHALL BE RESTORED TO THE SATISFACTION OF THE CITY OF BRAMPTON.
- ALL OPEN SPACE BLOCKS AND VALLEY LANDS SHALL BE MAINTAINED FREE OF GARBAGE AND CONSTRUCTION DEBRIS BY THE DEVELOPER UNTIL ASSUMPTION OF THE SUBDIVISION BY THE CITY OF BRAMPTON.

DEGREY DRIVE

SAN INV = 193.59 ✓ 1.29
STM INV = 193.79 ✓ 1.04

PROVIDE POURED IN PLACE CONC. STEPS
ALL STEPS SHALL BE POURED IN-PLACE
W/ MASONRY VENEER ON THE SIDES

1 RISER GENERAL NOTES

THE CONTRACTOR SHALL CHECK AND VERIFY ALL DIMENSIONS AND CONDITIONS ON SITE BEFORE PROCEEDING WITH CONSTRUCTION. ANY DISCREPANCIES SHALL BE REPORTED TO 1 RISER DESIGNS PRIOR TO COMMENCEMENT OF WORK.

1 RISER DESIGNS IS NOT RESPONSIBLE FOR THE ACCURACY OF SURVEY, STRUCTURAL OR ENGINEERING INFORMATION SHOWN ON THESE DRAWINGS OR FOR CONSTRUCTION STARTED PRIOR TO THE ISSUANCE OF A BUILDING PERMIT. REFER TO THE APPROPRIATE ENGINEERING DRAWINGS BEFORE PROCEEDING WITH WORK.

AS CONSTRUCTED INVERTS MUST BE VERIFIED PRIOR TO POURING FOOTINGS.

1 RISER DESIGNER HAS NOT BEEN RETAINED TO CARRY OUT GENERAL REVIEW OF THE WORK AND ASSUMES NO RESPONSIBILITY FOR THE FAILURE OF THE CONTRACTOR OR SUB CONTRACTOR TO CARRY OUT WORK IN ACCORDANCE WITH THE CONTRACT DOCUMENTS.

THIS DRAWING IS AN INSTRUMENT OF SERVICE, IS PROVIDED BY AND IS THE PROPERTY OF 1 RISER DESIGNS. THIS DRAWING IS NOT TO BE SCALED.

▽ SINGLE SERVICE CONNECTION	⊗ VALVE AND CHAMBER	2.0% PROP. SWALE	⊠ AIR-COND ON NO UNIT	FF FINISHED FLOOR ELEVATION
● DOUBLE SERVICE CONNECTION	⊗ STREET LIGHT	ENGINEERED FL. LOT	⊠ TELECOM JUNCTION BOX	TV TOP OF FOUNDATION WALL
○ WATER SERVICE CONNECTION	⊗ VALVE AND BOX	TRANSFORMER	⊠ SUMP PUMP	FS FINISHED BASEMENT S. AIR
H HYDRO CONNECTION	⊗ SANITARY WAKHOLE	CABLE TV PEDESTAL	⊠ EXTERIOR DOOR LOCATION	UF R UNDERSIDE OF FOOTING @ REAR
⊠ DOUBLE CATCH BASIN	⊗ STORM MANHOLE	BELL PEDESTAL	⊠ EXTERIOR DOOR LOCATION	REV REVERSE PLAN
⊠ CATCH BASIN	⊗ COMMUNITY MAIL BOX	HYDRO METER	⊠ EXTERIOR DOOR LOCATION	WOB WALK-OUT BASEMENT
⊠ FIRE HYDRANT	⊗ DOWNSPOUT LOCATION	GAS METER	⊠ EXTERIOR DOOR LOCATION	WOD WALK-OUT DECK
			⊠ WINDOWS PERMITTED	PROPOSED GRADE
				EXISTING GRADE

1 RISER DESIGNS
28 RIVERMEDE ROAD, UNIT 101
CONCORD, ONTARIO L9R 3H3
PHONE: (905) 884-2111
FAX: (905) 884-1953
www.1riser.com

REVISIONS	Description	Date	By	Check
1	ISSUED FOR PRELIMINARY REVIEW	APR. 26.17	MS	
2	ISSUED FOR FINAL APPROVAL	MAY. 18.17	MS	

LOT GRADING PLAN
55 DEGREY DRIVE

The undersigned has reviewed and takes responsibility for the design, and has the qualifications and meets the requirements set out in the Ontario Building Code through the work shown on the attached drawings.

QUALIFICATION REQUIREMENTS

IAN ROBERTSON 27816
REGISTERED PROFESSIONAL ENGINEER
REGISTERED IN THE PROVINCE OF ONTARIO
1 RISER DESIGNS INC. 32072

GREENYORK HOMES
DEGREY DRIVE,
CITY OF BRAMPTON

Plan # 43M-2013
Scale 1:250
Date APR 2017
Project # 17-08

LOT 28