


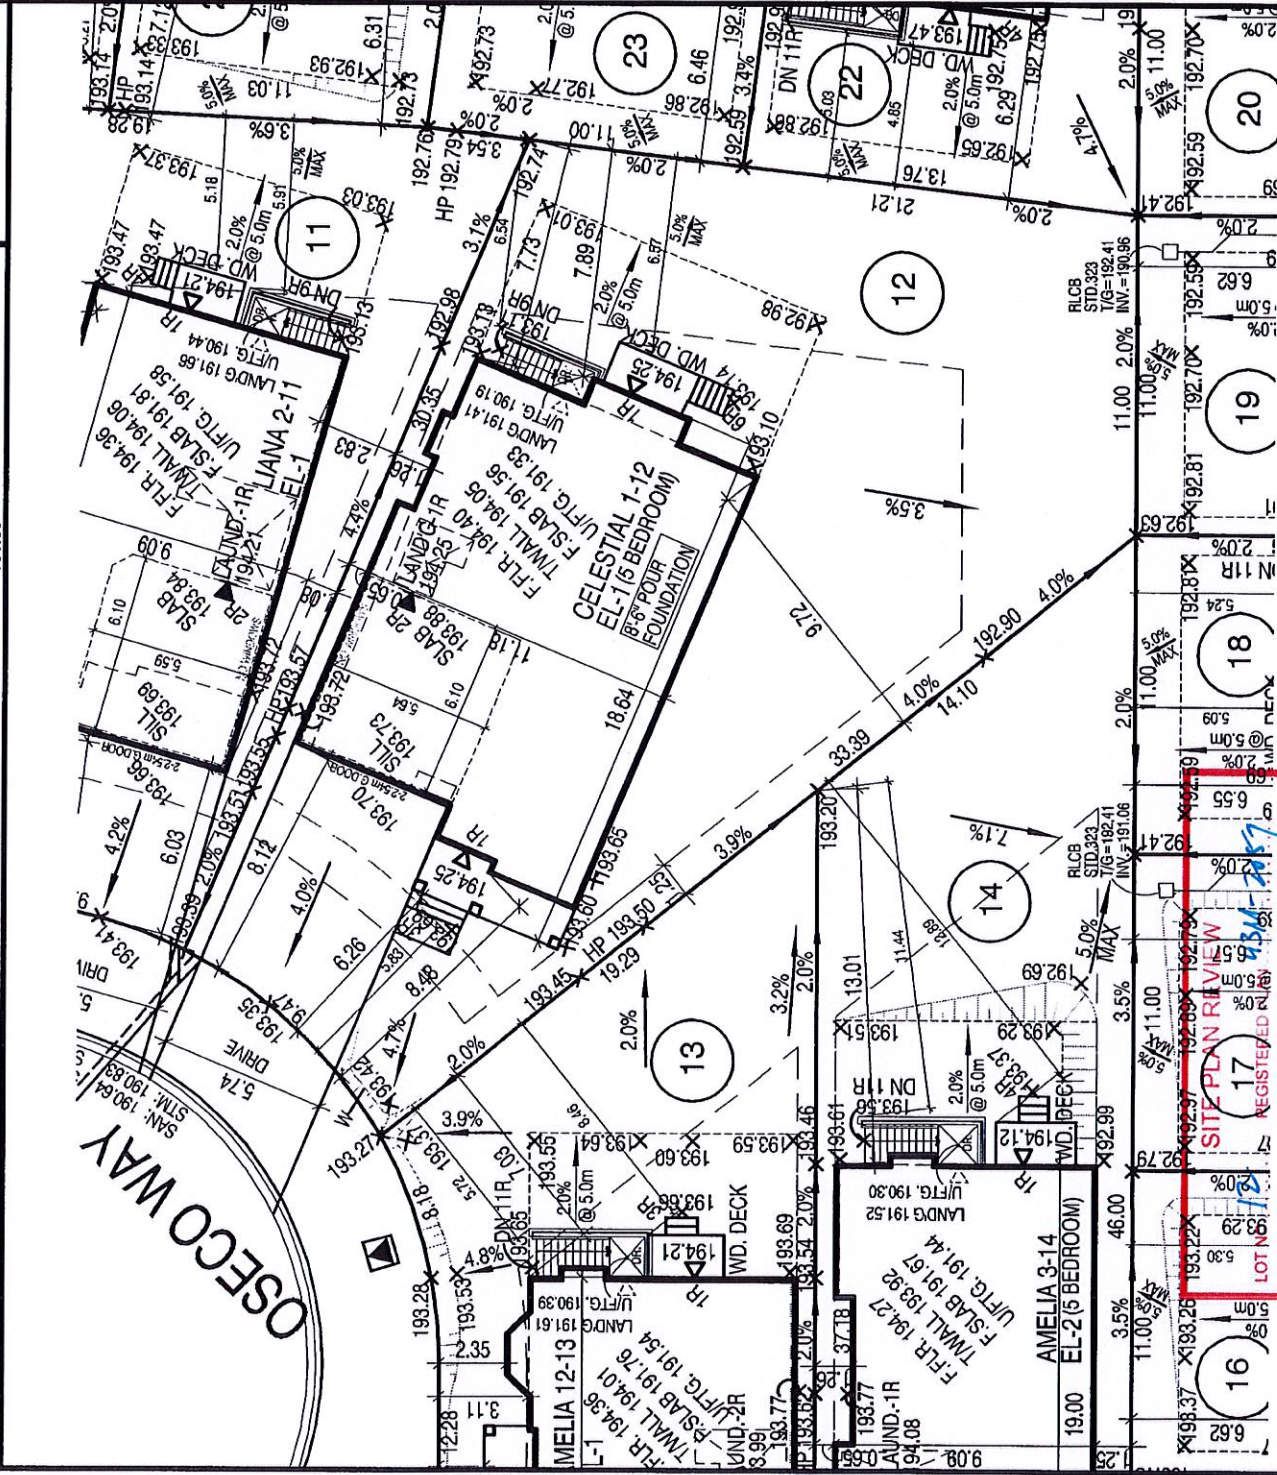

This stamp is only for the purposes of design control and carries no other professional obligations.

5		
4		
3	MAR. 13, 2019	REV. GRADES ALONG REAR PROPERTY LINE & RE-ISSUED FOR PERMIT
2	DEC. 21, 2018	ISSUED FOR PERMIT
1	NOV. 22, 2018	ISSUED FOR ENGINEERS GRADING REVIEW.

REVISIONS:

GREENYORK
— HOMES —

GRANELLI HOMES	
PROJ. No. 17-55	MUNICIPAL ADDRESS

LOT No. 12

REG. PLAN
PLAN OF SUBDIVISION OF PART OF BLOCK 203,
PLAN 43M-1677 AND PART OF BLOCK 111,
PLAN 43M-1712 CITY OF BRAMPTON
REGIONAL MUNICIPALITY OF PEEI

The undersigned has reviewed and takes responsibility for this design and has the qualifications and meets the requirements set out in the Ontario Building Code to be a designer

Required unless design exempt under Division C, Subsection 3.2.3 of the Building Code

Walter Botter 21031

NAME _____ SIGNATURE _____ BUILDING CODE _____

REGISTRATION INFORMATION

Required unless design is exempt under Division C, Subsection 1.2.4.1 of the building code.

FIRM NAME	BCIN
jardin design group inc. 27763	

AS CONSTRUCTED
TOWN DESIGN GROUP
REVIEW OF THE WORK
THE CONTRACTOR
IN ACCORDANCE WITH
THIS DRAWING IS AN
PROFESSIONAL ENGINEER

jardin
DESIGN GROUP INC.

64 JARDIN DR. SUITE 3A
VAUGHAN ONT. L4K 3P3
TEL: 905 660-3377 FAX: 905 660-3713
EMAIL: info@jardindesign.ca

AS CONSTRAINED WORKS MUST BE COMPLETED PRIOR TO POORING FOOTINGS, JAYCON DESIGN GROUP, INC. HAS NOT BEEN VETTED AS TO CARRY OUT GENERAL REVIEW OF THE WORK AND ASSUMES NO RESPONSIBILITY FOR THE FAILURE OF THE CONTRACTOR'S SUB CONTRACTOR TO COMPLY WITH THE WORK IN ACCORDANCE WITH THE CONTRACT DOCUMENTS.

THIS DRAWING IS AN INSTRUMENT OF SERVICE, IS PROVIDED BY ANJLS THE ARCHITECTURAL FIRM, DESIGN GROUP INC. IT IS DRAWING IS NOT TO BE SCALE.