


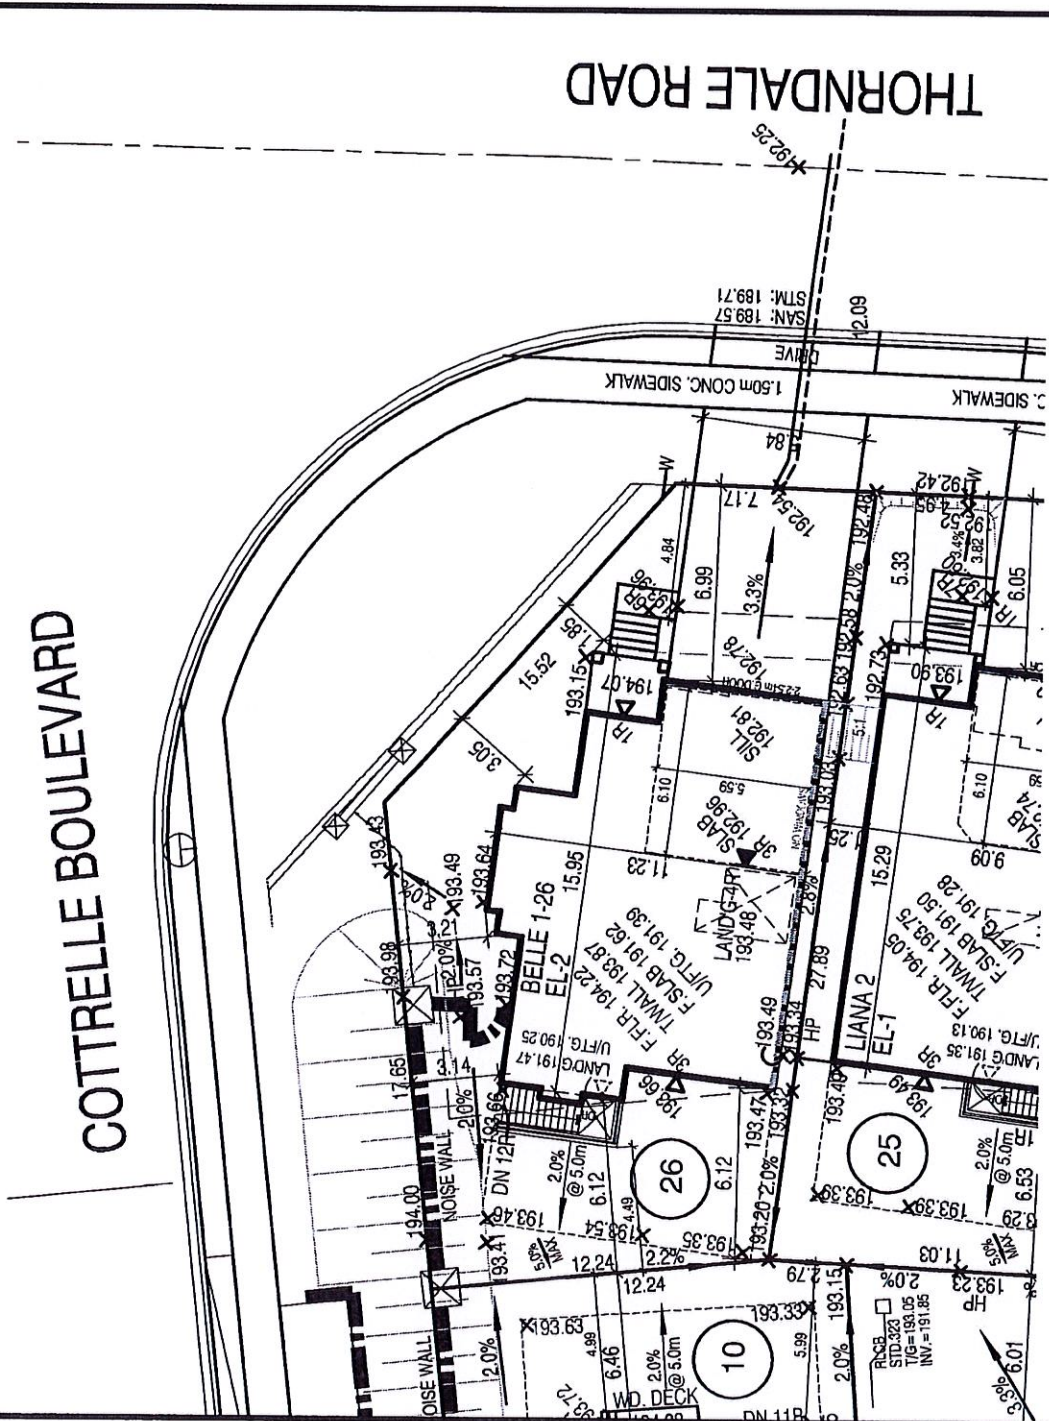

SITE PLAN REVIEW

LOT NO. 26 REGISTERED PLAN H34-2057


THE PROPOSED LOT GRADING AND DRAINAGE IS APPROVED
AS BEING IN CONFORMANCE WITH THE OVERALL APPROVED
GRADING PLANS FOR THE SUBDIVISION

THIS REVIEW DOES NOT WARRANT THAT OTHER INFORMATION
SHOWN ON THIS DRAWING IS ACCURATE OR COMPLETE. SOLE
RESPONSIBILITY FOR DESIGN AND DETAILS SHALL REMAIN
WITH THE DESIGNER.

NO COMMENT ☒ REVIEWED BY 26

COMMENTS AS NOTED ☐ DATE 30.01.2017

QDC CANDEVCON LIMITED
CONSULTING ENGINEERS AND PLANNERS

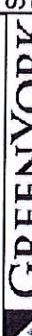	SCALE 1:250 			10m 5m 0m
	GREENYORK HOMES			
GRANELLI HOMES				10m 5m 0m
PROJ. No. 17-55	MUNICIPAL ADDRESS			
LOT No. 26	MUNICIPAL ADDRESS			10m 5m 0m
PLAN OF SUBDIVISION OF PART OF BLOCK 203, PLAN 43M-1677 AND PART OF BLOCK 111, PLAN 43W-1712 CITY OF BRAMPTON REGIONAL MUNICIPALITY OF PEEBLES				