

19-447186 000 00 RR

Energy Efficiency Design Summary: Prescriptive Method

(Building Code Part 9, Residential)

This form is used by a designer to demonstrate that the energy efficiency design of a house complies with the building code using the prescriptive method described in Subsection 3.1.1. of SB-12. This form is applicable where the ratio of gross area of windows/sidelights/skylights/glazing in doors and sliding glass doors to the gross area of peripheral walls is not more than 22%.

For use by Principal Authority	
Application No:	Model/Certification Number LIANA 1, EL-2

A. Project Information

Building number, street name		Unit number	Lot/Con 29
Municipality City of Brampton	Postal code	Reg. Plan number / other description 43M-2057	

B. Prescriptive Compliance [indicate the building code compliance package being employed in this house design]

SB-12 Prescriptive (input design package): Package: **A1** Table: _____

C. Project Design Conditions


Climatic Zone (SB-1):	Heating Equipment Efficiency	Space Heating Fuel Source
<input type="checkbox"/> Zone 1 (< 5000 degree days)	<input type="checkbox"/> ≥ 92% AFUE	<input type="checkbox"/> Gas <input type="checkbox"/> Propane <input type="checkbox"/> Solid Fuel
<input type="checkbox"/> Zone 2 (≥ 5000 degree days)	<input type="checkbox"/> ≥ 84% < 92% AFUE	<input type="checkbox"/> Oil <input type="checkbox"/> Electric <input type="checkbox"/> Earth Energy
Ratio of Windows, Skylights & Glass (W, S & G) to Wall Area		Other Building Characteristics
Area of walls = 293.62 m ² or _____ ft ²	W, S & G % = 9.42% ✓	<input type="checkbox"/> Log/Post&Beam <input type="checkbox"/> ICF Above Grade <input type="checkbox"/> ICF Basement
Area of W, S & G = 27.67 m ² or _____ ft ²	Utilize window averaging: <input type="checkbox"/> Yes <input type="checkbox"/> No	<input type="checkbox"/> Slab-on-ground <input type="checkbox"/> Walkout Basement
		<input type="checkbox"/> Air Conditioning <input type="checkbox"/> Combo Unit
		<input type="checkbox"/> Air Sourced Heat Pump (ASHP)
		<input type="checkbox"/> Ground Sourced Heat Pump (GSHP)


D. Building Specifications [provide values and ratings of the energy efficiency components proposed]

Energy Efficiency Substitutions			
<input type="checkbox"/> ICF (3.1.1.2.(5) & (6) / 3.1.1.3.(5) & (6)) <input type="checkbox"/> Combined space heating and domestic water heating systems (3.1.1.2.(7) / 3.1.1.3.(7)) <input type="checkbox"/> Airtightness substitution(s) Airtightness test required (Refer to Design Guide Attached)			
<input type="checkbox"/> Table 3.1.1.4.B Required: _____ Permitted Substitution: _____ <input type="checkbox"/> Table 3.1.1.4.C Required: _____ Permitted Substitution: _____		Required: _____ Permitted Substitution: _____	
Building Component	Minimum RSI / R values or Maximum U-Value ⁽¹⁾	Building Component	Efficiency Ratings
Thermal Insulation	Nominal Effective	Windows & Doors Provide U-Value ⁽¹⁾ or ER rating	
Ceiling with Attic Space	10.57 10.43	Windows/Sliding Glass Doors	1.6
Ceiling without Attic Space	5.46 4.87	Skylights/Glazed Roofs	2.8
Exposed Floor	5.46 5.25	Mechanicals	
Walls Above Grade	4.22 3.00	Heating Equip.(AFUE)	96%
Basement Walls	3.52 3.72	HRV Efficiency (SRE% at 0°C)	75%
Slab (all >600mm below grade)	- -	DHW Heater (EF)	0.83
Slab (edge only ≤600mm below grade)	1.76 1.76	DWHR (CSA B55.1 (min. 42% efficiency))	42 # Showers 2
Slab (all ≤600mm below grade, or heated)	1.76 1.96	Combined Heating System	N/A

(1) U value to be provided in either W/(m²·K) or Btu/(h·ft²·F) but not both.

E. Designer(s) [name(s) & BCIN(s), if applicable, of person(s) providing information herein to substantiate that design meets the building code]

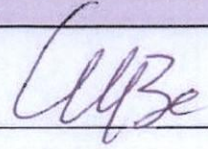Qualified Designer Declaration of designer to have reviewed and take responsibility for the design work.		
Name Walter Botter Jardin Design Group Inc.	BCIN 21031 27763	Signature 

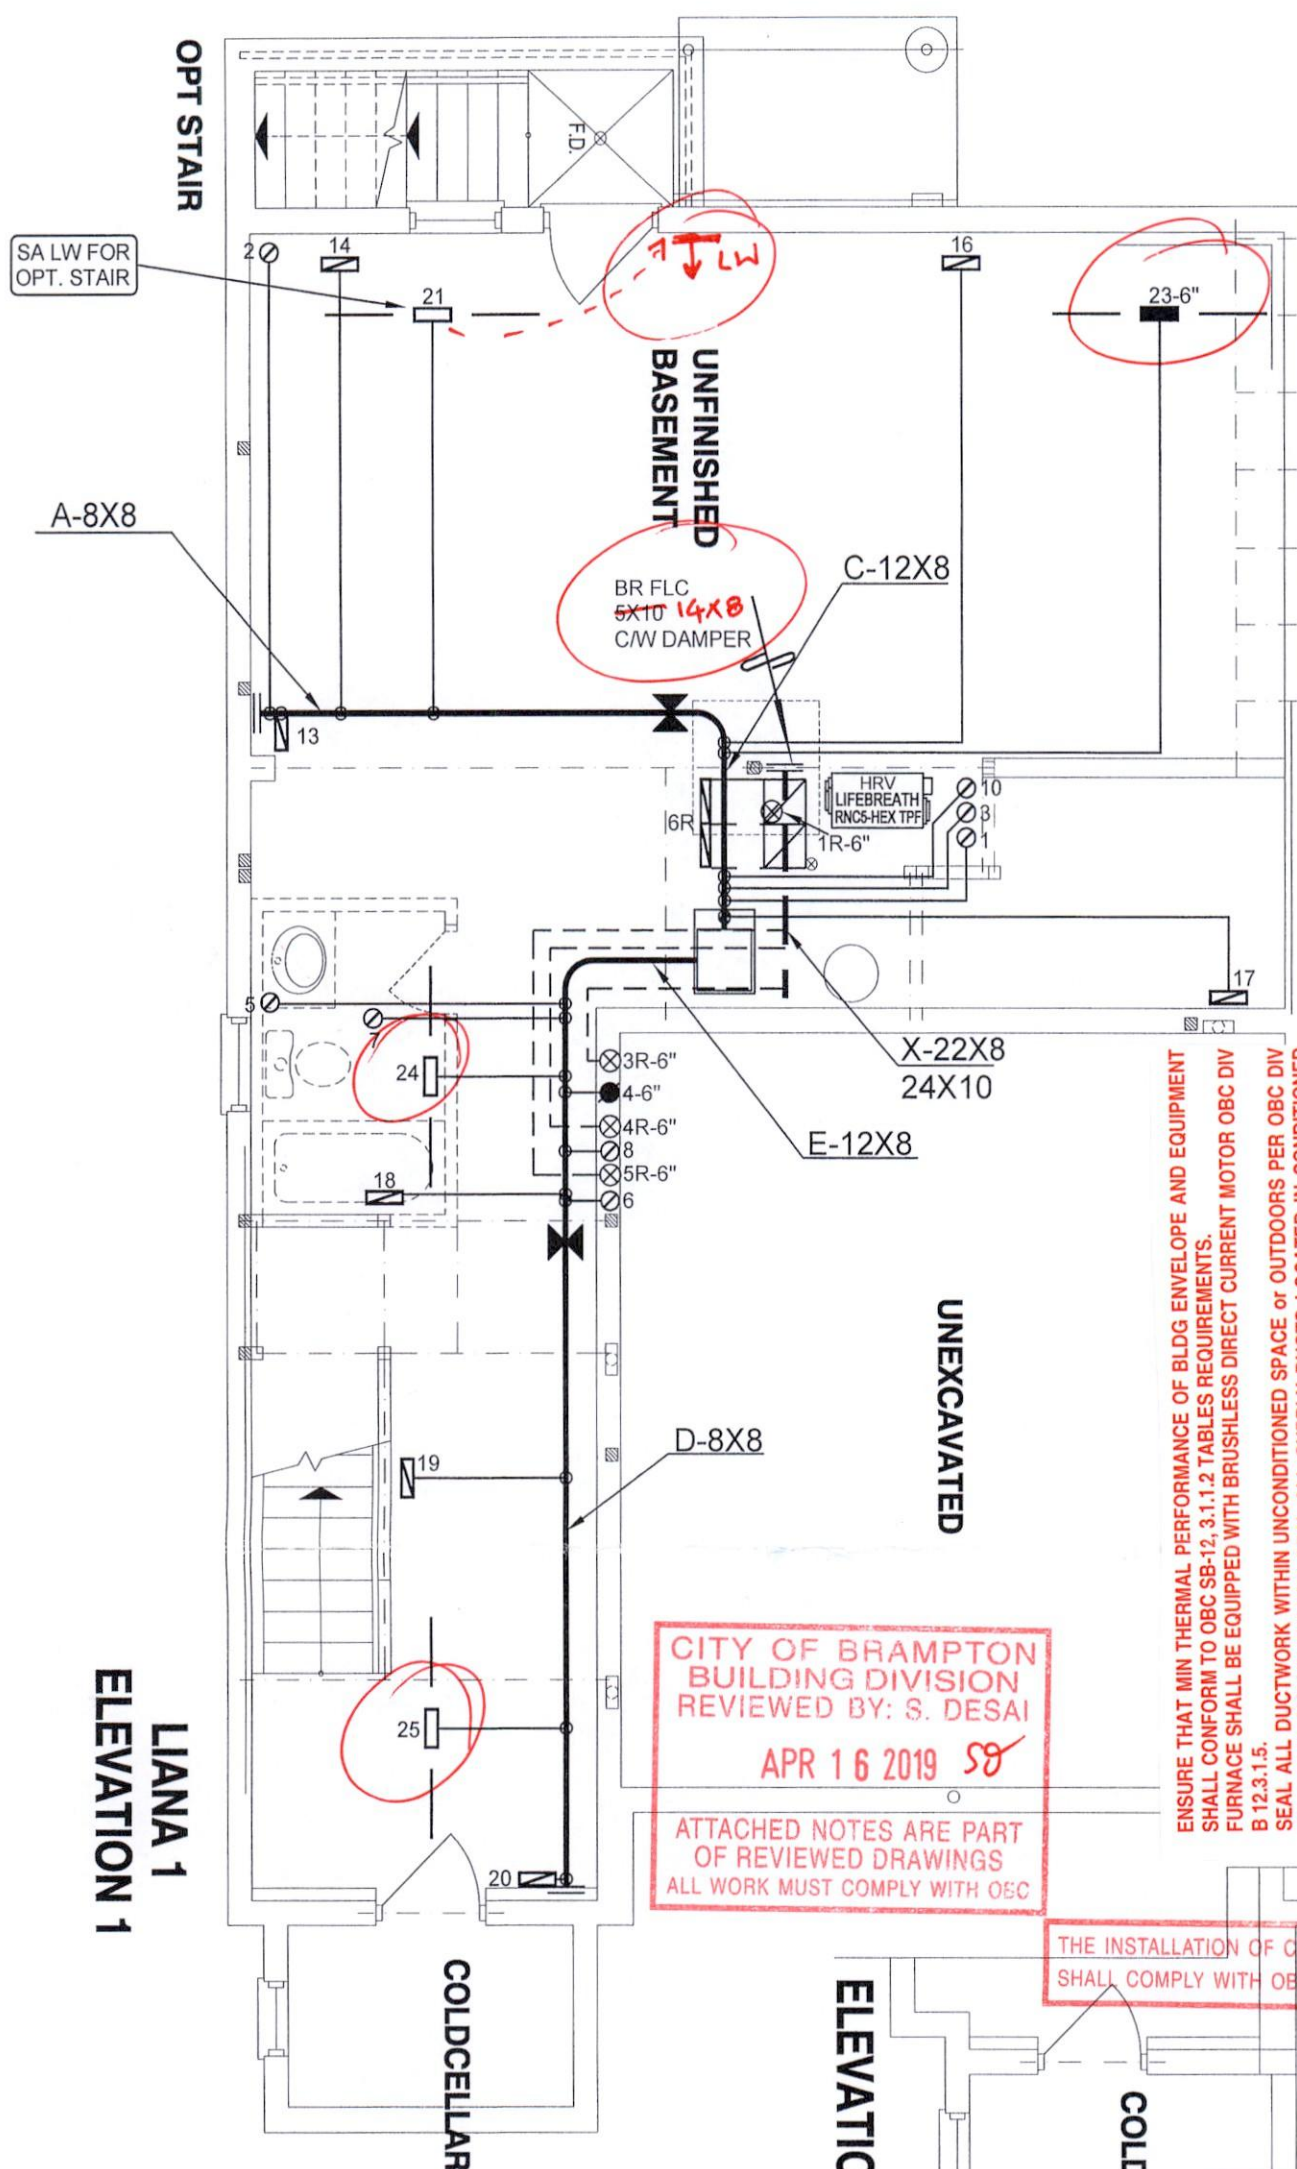

ENSURE THAT MIN THERMAL PERFORMANCE OF BLDG ENVELOPE AND EQUIPMENT SHALL CONFORM TO OBC SB-12, 3.1.1.2 TABLES REQUIREMENTS.

FURNACE SHALL BE EQUIPPED WITH BRUSHLESS DIRECT CURRENT MOTOR OBC DIV B 12.3.1.5.

SEAL ALL DUCTWORK WITHIN UNCONDITIONED SPACE or OUTDOORS PER OBC DIVISION 6.2.4.3(11) REQUIREMENTS. SEAL ALL SUPPLY DUCTS LOCATED IN CONDITIONED

SPACE IN COMPLIANCE WITH OBC DIV B6.2.4.3(12) REQUIREMENTS.
SEPARATE ANY INTAKES FROM BUILDING ENVELOPE PENETRATIONS THAT ARE

POTENTIAL SOURCES OF CONTAMINANTS (GAS VENTS, OIL FILL PIPES, etc. BY MIN 900mm (2FT 11IN) – OBC Div B 9.32.3.12.

BY APPLICATION FOR REVISION OF DESIGN PER OBC PART 6 REQUIREMENTS.

EXHAUST FAN SHALL DISCHARGE DIRECTLY TO OUTSIDE. CLOTHES DRYER EXHAUST SYSTEM SHALL COMPLY WITH OBC DIV B 9.32.1.2, 9.32.1.3 & 9.32.3 REQ'S. BALANCE THE RETURN AIRFLOW ON THE UPPER FLOOR TO MATCH THE SUPPLY

WHEN HRV IS USED AS PRINCIPAL EXHAUST FAN, THE CONTROLLER SHALL BE WIRED TO THE HRV UNIT AND INTERCONNECTED TO THE FURNACE FAN. THE FURNACE

**BLOWER MUST BE IN OPERATION WHEN THE HRV IS IN OPERATION.
INSTALL ADDITIONAL S/A REGISTER AS REQUIRED IN ORDER TO ENSURE MIN 72degF**

- OBC DIV B 9.33.3.1(1).
UNDERCUT BY MIN 1" THE DOOR TO ANY ROOM WITHOUT RETURN AIR GRILLE.
THE DOOR TO THE MAIN C/A MUST BE CONNECTED TO THE MAIN C/A DUCT AT A

ENSURE RETURN AIR INTAKE SHALL BE CONNECTED TO THE MAIN H/A DUCT AT A HORIZONTAL DISTANCE OF MIN 6FT FROM THE CASING OF THE UNIT (HRAI DIGEST).

CITY OF BRAMPTON
BUILDING DIVISION
REVIEWED BY: S. DESAI
APR 16 2019 SD

ATTACHED NOTES ARE PART
OF REVIEWED DRAWINGS
ALL WORK MUST COMPLY WITH OGC

THE INSTALLATION OF CARBON MONOXIDE DETECTOR(S)
SHALL COMPLY WITH OBC DIV. B, 9.33.4 REQUIREMENTS.













MECHANICAL VENTILATION SHALL BE PROVIDED IN CONFORMANCE WITH OBC DIV. B, 9.32.3 REQUIREMENTS.

A HEAT RECOVERY VENTILATOR SHALL BE INSTALLED IN COMPLIANCE WITH OBC DIV. B, 6.2.1.6, 9.32.3.6(3), 9.32.3.11 AND HRAI DIGEST REQUIREMENTS.

INSTALLATION OF HVAC EQUIP.
SHALL CONFORM TO MANUFACTURER'S SPECIFICATIONS
AND MANUALS


CSA-F280-12

PACKAGE A1

HVAC LEGEND								3.		
SYMBOL	DESCRIPTION	SYMBOL	DESCRIPTION	SYMBOL	DESCRIPTION	SYMBOL	DESCRIPTION	2.		
	SUPPLY AIR GRILLE		6" SUPPLY AIR BOOT ABOVE		14"x8" RETURN AIR GRILLE		RETURN AIR STACK ABOVE	1.		
	SUPPLY AIR GRILLE 6" BOOT		SUPPLY AIR STACK FROM 2nd FLOOR		30"x8" RETURN AIR GRILLE		RETURN AIR STACK 2nd FLOOR	No.	Description	Date
	SUPPLY AIR BOOT ABOVE		6" SUPPLY AIR STACK 2nd FLOOR		FRA- FLOOR RETURN AIR GRILLE		REDUCER	REVISIONS		

ALL DRAWINGS, CALCULATIONS AND SPECIFICATIONS ARE THE PROPERTY OF HVAC DESIGNS LTD.© AND MAY NOT BE REPRODUCED, MODIFIED OR ALTERED WITHOUT EXPRESSED WRITTEN CONSENT. THE DRAWINGS ARE DATED AND USE OF THESE DRAWINGS AFTER ONE YEAR FROM THE DATED NOTED IS NOT AUTHORIZED. CONTRACTOR SHALL CHECK ALL CONDITIONS BEFORE PROCEEDING WITH WORK. LATEST MUNICIPAL APPROVED DRAWINGS ONLY TO BE USED DURING INSTALLATION OF HEATING SYSTEM. HVAC DESIGNS LTD. IS NOT LIABLE FOR ANY CLAIMS ARISING FROM UNAUTHORIZED USE OF THE DRAWINGS OR FROM ANY CHANGES TO ACCEPTED STANDARDS AND/OR THE ONTARIO BUILDING CODE.

Client	<div><div><div>HVACDESIGNSLTD.</div><div>375 Finley Ave. Suite 202 - Ajax, Ontario L1S 2E2 Tel. 905.619.2300 - 905.420.5300 Fax 905.619.2375 Email: info@hvacdesigns.ca Web: www.hvacdesigns.ca Specializing in Residential Mechanical Design Services</div></div><div>Installation to comply with the latest Ontario Building Code. All supply branch outlets shall be equipped with a manual balancing damper. Ductwork which passes through the garage or unheated spaces shall be adequately insulated and be gas-proofed.</div></div>	HEAT LOSS 42790 BTU/H		# OF RUNS	S/A	R/A	FANS	Sheet Title	
GREENYORK HOMES		UNIT DATA		3RD FLOOR				BASEMENT HEATING LAYOUT	
Project Name		CARRIER		2ND FLOOR	9	4	2	Date JUNE/2018	
GRANELLI HOMES CORP BRAMPTON, ONTARIO		MODEL 59SP5A-60-12		1ST FLOOR	7	1	3	Scale 3/16" = 1'-0"	
M-2057 LOT 29 ALT 2ND FL LIANA 1		INPUT 60 MBTU/H		BASEMENT	4	1	0	BCIN# 19669	
2041 sqft	OUTPUT 58 MBTU/H		ALL S/A DIFFUSERS 4 "x10" UNLESS NOTED OTHERWISE ON LAYOUT. ALL S/A RUNS 5"Ø UNLESS NOTED OTHERWISE ON LAYOUT. UNDERCUT DOORS 1" min. FOR R/A					LO# 78999	
	COOLING 2.0 TONS								
	FAN SPEED 785 cfm @ 0.6" w.c.								

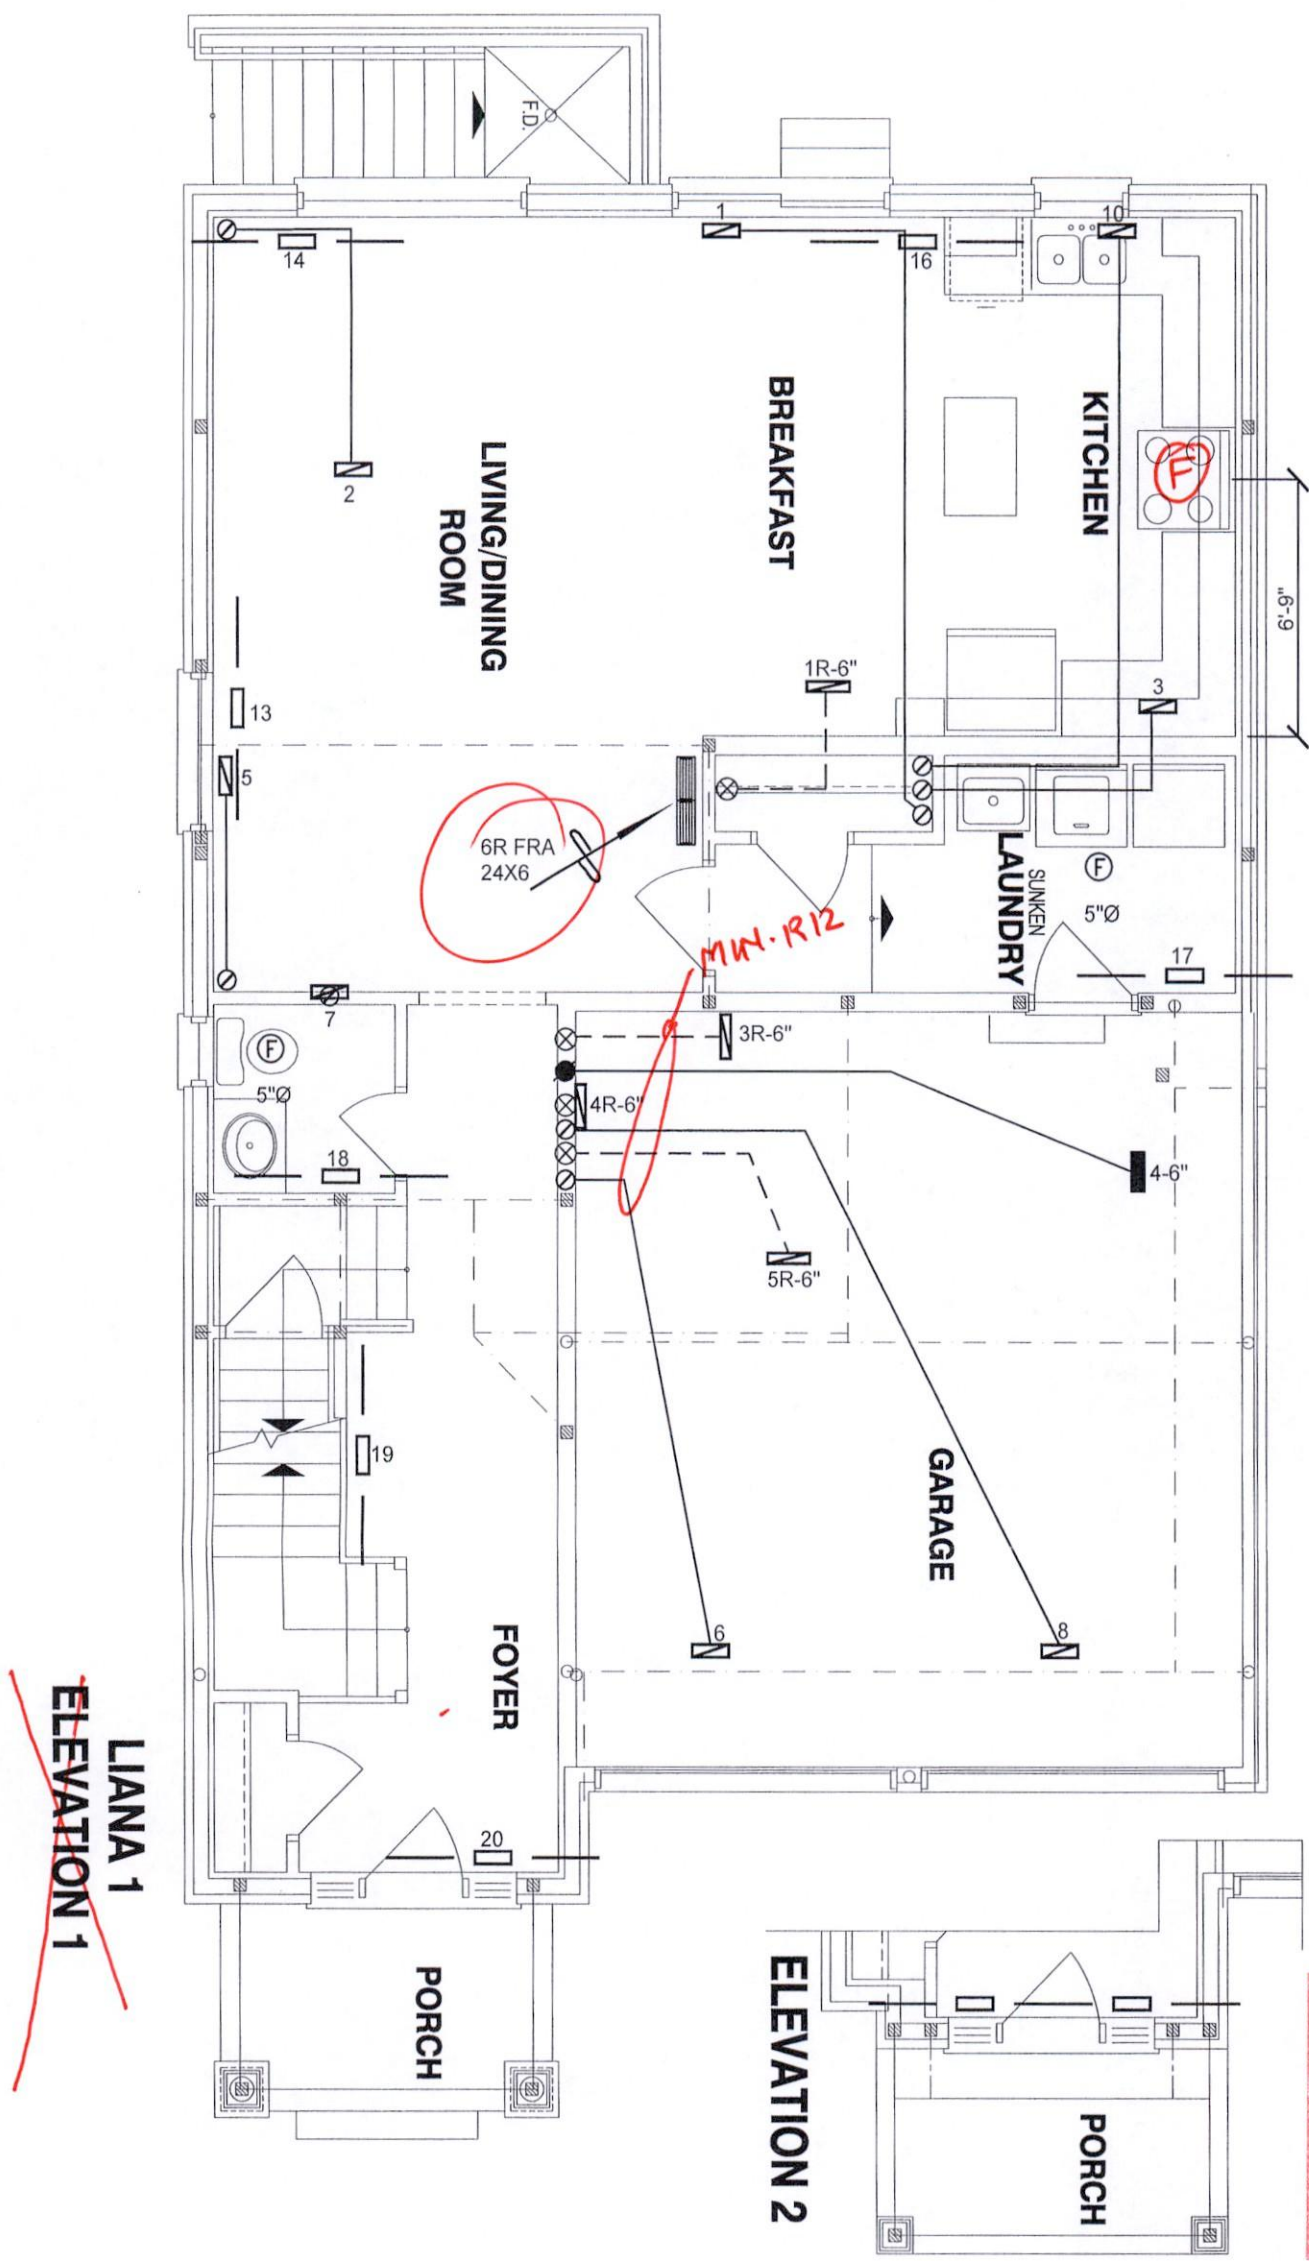

LIANA 1
ELEVATION 1

ELEVATION 2

CITY OF BRAMPTON
BUILDING DIVISION
REVIEWED BY: S. DESAI

APR 16 2019 *SD*

ATTACHED NOTES ARE PART
OF REVIEWED DRAWINGS
ALL WORK MUST COMPLY WITH OBC

MECHANICAL VENTILATION SHALL BE PROVIDED IN
CONFORMANCE WITH OBC DIV. B, 9.32.3 REQUIREMENTS.

THE INSTALLATION OF CARBON MONOXIDE DETECTOR(S)
SHALL COMPLY WITH OBC DIV. B, 9.33.4 REQUIREMENTS.

CSA-F280-12
PACKAGE A1

I MICHAEL O'ROURKE HAVE REVIEWED AND TAKE RESPONSIBILITY FOR THE DESIGN WORK AND AM QUALIFIED UNDER DIVISION C, 32.5 OF THE BUILDING CODE.

Michael O'Rourke
Michael O'Rourke, BCIN# 19669
HVAC DESIGNS LTD.


HVAC LEGEND						3.		
SYMBOL	DESCRIPTION	SYMBOL	DESCRIPTION	SYMBOL	DESCRIPTION	SYMBOL	DESCRIPTION	
	SUPPLY AIR GRILLE		6" SUPPLY AIR BOOT ABOVE		14"x8" RETURN AIR GRILLE		RETURN AIR STACK ABOVE	2.
	SUPPLY AIR GRILLE 6" BOOT		SUPPLY AIR STACK FROM 2nd FLOOR		30"x8" RETURN AIR GRILLE		RETURN AIR STACK 2nd FLOOR	1.
	SUPPLY AIR BOOT ABOVE		6" SUPPLY AIR STACK 2nd FLOOR		FRA- FLOOR RETURN AIR GRILLE		REDUCER	No.
REVISIONS								Date

ALL DRAWINGS, CALCULATIONS AND SPECIFICATIONS ARE THE PROPERTY OF HVAC DESIGNS LTD. AND MAY NOT BE REPRODUCED, MODIFIED OR ALTERED WITHOUT EXPRESSED WRITTEN CONSENT. THE DRAWINGS ARE DATED AND USE OF THESE DRAWINGS AFTER ONE YEAR FROM THE DATED NOTED IS NOT AUTHORIZED. CONTRACTOR SHALL CHECK ALL CONDITIONS BEFORE PROCEEDING WITH WORK. LATEST MUNICIPAL APPROVED DRAWINGS ONLY TO BE USED DURING INSTALLATION OF HEATING SYSTEM. HVAC DESIGNS LTD. IS NOT LIABLE FOR ANY CLAIMS ARISING FROM UNAUTHORIZED USE OF THE DRAWINGS OR FROM ANY CHANGES TO ACCEPTED STANDARDS AND/OR THE ONTARIO BUILDING CODE.

Client GREENYORK HOMES		 375 Finley Ave. Suite 202 - Ajax, Ontario L1S 2E2 Tel. 905.619.2300 - 905.420.5300 Fax 905.619.2375 Email: info@hvacdesigns.ca Web: www.hvacdesigns.ca Specializing in Residential Mechanical Design Services	Sheet Title FIRST FLOOR HEATING LAYOUT	
Project Name GRANELLI HOMES CORP BRAMPTON, ONTARIO M-2057 LOT 29 ALT 2ND FL LIANA 1			Date JUNE/2018 Scale 3/16" = 1'-0" BCIN# 19669 LO# 78999	
2041 sqft		Installation to comply with the latest Ontario Building Code. All supply branch outlets shall be equipped with a manual balancing damper. Ductwork which passes through the garage or unheated spaces shall be adequately insulated and be gas-proofed.		

~~LIANA 1~~
~~ELEVATION 1~~

OPTIONAL
4 BEDROOM

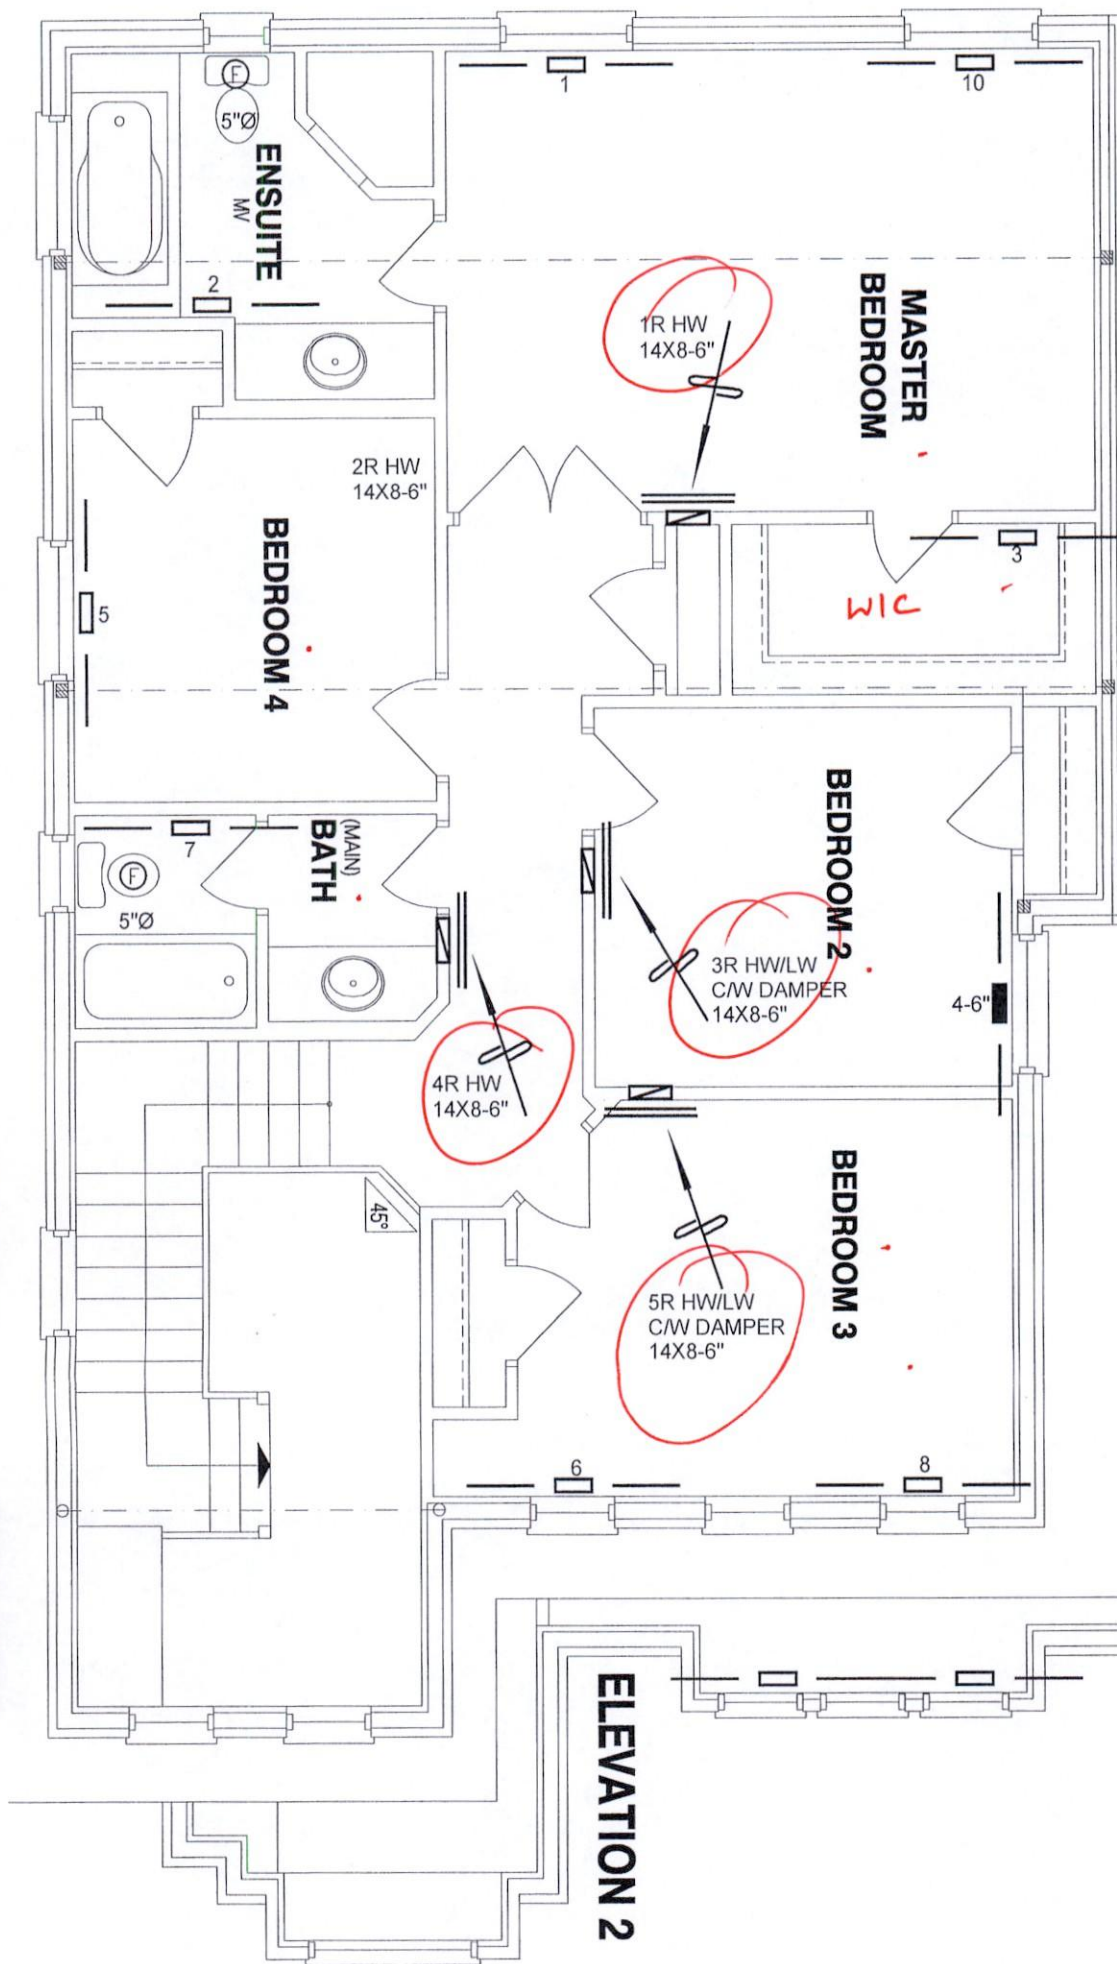

CITY OF BRAMPTON
BUILDING DIVISION
REVIEWED BY: S. DESAI

APR 16 2019 *SD*

ATTACHED NOTES ARE PART
OF REVIEWED DRAWINGS
ALL WORK MUST COMPLY WITH OBC

MECHANICAL VENTILATION SHALL BE PROVIDED IN
CONFORMANCE WITH OBC DIV. B, 9.32.3 REQUIREMENTS.

THE INSTALLATION OF CARBON MONOXIDE DETECTOR(S)
SHALL COMPLY WITH OBC DIV. B, 9.33.4 REQUIREMENTS.

CSA-F280-12
PACKAGE A1

I MICHAEL O'ROURKE HAVE REVIEW
AND TAKE RESPONSIBILITY FOR THE
DESIGN WORK AND AM QUALIFIED
UNDER DIVISION C, 3.2.5 OF THE
BUILDING CODE.

Michael O'Rourke
Michael O'Rourke, BCIN# 19669
HVAC DESIGNS LTD.

HVAC LEGEND								3.		
— □ —	SUPPLY AIR GRILLE	— ■ —	6" SUPPLY AIR BOOT ABOVE	— ▤ —	14"x8" RETURN AIR GRILLE	— ▤ —	RETURN AIR STACK ABOVE	2.		
— ■ —	SUPPLY AIR GRILLE 6" BOOT	○	SUPPLY AIR STACK FROM 2nd FLOOR	— ▤ —	30"x8" RETURN AIR GRILLE	— ▤ —	RETURN AIR STACK 2nd FLOOR	1.		
— ▤ —	SUPPLY AIR BOOT ABOVE	●	6" SUPPLY AIR STACK 2nd FLOOR	— ▤ —	FRA- FLOOR RETURN AIR GRILLE	— ▤ —	REDUCER	No.	Description	Date
								REVISIONS		

ALL DRAWINGS, CALCULATIONS AND SPECIFICATIONS ARE THE PROPERTY OF HVAC DESIGNS LTD. © AND MAY NOT BE REPRODUCED, MODIFIED OR ALTERED WITHOUT EXPRESSED WRITTEN CONSENT. THE DRAWINGS ARE DATED AND USE OF THESE DRAWINGS AFTER ONE YEAR FROM THE DATE NOTED IS NOT AUTHORIZED. CONTRACTOR SHALL CHECK ALL CONDITIONS BEFORE PROCEEDING WITH WORK. LATEST MUNICIPAL APPROVED DRAWINGS ONLY TO BE USED DURING INSTALLATION OF HEATING SYSTEM. HVAC DESIGNS LTD. IS NOT LIABLE FOR ANY CLAIMS ARISING FROM UNAUTHORIZED USE OF THE DRAWINGS OR FROM ANY CHANGES TO ACCEPTED STANDARDS AND/OR THE ONTARIO BUILDING CODE.

Client GREENYORK HOMES		HVAC DESIGNS LTD. 375 Finley Ave. Suite 202 - Ajax, Ontario L1S 2E2 Tel. 905.619.2300 - 905.420.5300 Fax 905.619.2375 Email: info@hvacdsgns.ca Web: www.hvacdsgns.ca Specializing in Residential Mechanical Design Services	Installation to comply with the latest Ontario Building Code. All supply branch outlets shall be equipped with a manual balancing damper. Ductwork which passes through the garage or unheated spaces shall be adequately insulated and be gas-proofed.	Sheet Title HEATING LAYOUT Date JUNE/2018 Scale 3/16" = 1'-0" BCIN# 19669 LO# 78999
Project Name GRANELLI HOMES CORP BRAMPTON, ONTARIO M-2057 LOT 29 ALT 2ND FL LIANA 1	2041 sqft			

SITE NAME: GRANELLI HOMES CORP

ALT 2ND FL

DATE: Jun-18

WINTER NATURAL AIR CHANGE RATE 0.325

HEAT LOSS AT °F. 74

CSA-F280-12*

BUILDER: GREENYORK HOMES

TYPE: LIANA 1

GFA: 2041

LO# 78999

SUMMER NATURAL AIR CHANGE RATE 0.106

HEAT GAIN AT °F. 11

SB-12 PACKAGE A1

ROOM USE	EXP. WALL	CLG. HT.	FACTORS	MBR	ENS	WIC	BED-2	BED-3	BED-4	BATH
				32	21	5	12	10	30	10
				9	9	9	9	9	9	9
GRS.WALL AREA	LOSS	GAIN		288	189	45	108	90	270	90
GLAZING	LOSS	GAIN								
NORTH	20.8	14.6	0	0	0	0	0	0	0	0
EAST	20.8	38.3	0	0	0	0	0	0	0	0
SOUTH	20.8	22.9	0	0	0	0	0	0	0	0
WEST	20.8	38.3	30	623	1150	7	145	268	0	0
SKYLT.	36.4	100.7	0	0	0	0	0	0	0	0
DOORS	24.7	3.7	0	0	0	0	0	0	0	0
NET EXPOSED WALL	4.4	0.6	258	1124	167	169	736	109	45	196
NET EXPOSED BSMT WALL ABOVE GR	3.5	0.5	0	0	0	0	0	0	0	0
EXPOSED CLG	1.3	0.6	247	309	138	110	138	61	95	119
NO ATTIC EXPOSED CLG	2.7	1.2	0	0	0	0	0	0	0	0
EXPOSED FLOOR	2.5	0.4	0	0	0	0	0	0	0	0
BASEMENT/CRAWL HEAT LOSS										
SLAB ON GRADE HEAT LOSS										
SUBTOTAL HT LOSS				2057	1290	315	1223	776	2418	661
SUB TOTAL HT GAIN				1454	736	82	399	453	1591	297
LEVEL FACTOR / MULTIPLIER	0.20	0.28								
AIR CHANGE HEAT LOSS	577				362	88	343	218	678	185
AIR CHANGE HEAT GAIN				91	46	5	25	28	99	19
DUCT LOSS				0	0	0	157	0	310	0
DUCT GAIN				0	0	0	122	0	249	0
HEAT GAIN PEOPLE	240			2	480	0	0	1	240	0
HEAT GAIN APPLIANCES/LIGHTS					555	0	0	555	555	0
TOTAL HT LOSS BTU/H				2634	1651	403	1723	994	3406	847
TOTAL HT GAIN x 1.3 BTU/H				3354	1017	113	1742	1659	3555	411

CITY OF BRAMPTON
BUILDING DIVISION
REVIEWED BY: S. DESAI
APR 16 2019 *SD*
ATTACHED NOTES ARE PART
OF REVIEWED DRAWINGS
ALL WORK MUST COMPLY WITH OBC

ROOM USE	EXP. WALL	CLG. HT.	FACTORS	K/L/D	LAUN	W/R	FOY	WUB	BAS
				65	26	9	81	15	137
				10	12	10	10	9	9
GRS.WALL AREA	LOSS	GAIN		650	312	90	810	135	822
GLAZING	LOSS	GAIN							
NORTH	20.8	14.6	0	0	0	0	0	0	0
EAST	20.8	38.3	0	0	0	0	0	0	0
SOUTH	20.8	22.9	22	457	503	0	0	0	0
WEST	20.8	38.3	87	1808	3335	7	145	160	11
SKYLT.	36.4	100.7	0	0	0	0	0	0	0
DOORS	24.7	3.7	0	0	0	0	0	0	0
NET EXPOSED WALL	4.4	0.6	541	2357	349	20	493	73	20
NET EXPOSED BSMT WALL ABOVE GR	3.5	0.5	0	0	0	0	0	0	0
EXPOSED CLG	1.3	0.6	0	0	0	0	0	0	0
NO ATTIC EXPOSED CLG	2.7	1.2	0	0	0	0	0	0	0
EXPOSED FLOOR	2.5	0.4	0	0	0	0	0	0	0
BASEMENT/CRAWL HEAT LOSS									
SLAB ON GRADE HEAT LOSS									
SUBTOTAL HT LOSS				4622	1765	507	5111	108	6607
SUB TOTAL HT GAIN				4188	262	214	2729	1184	356
LEVEL FACTOR / MULTIPLIER	0.30	0.31							
AIR CHANGE HEAT LOSS	1416				541	155	1566	0.50	0.79
AIR CHANGE HEAT GAIN				261	16	13	170	6129	43
DUCT LOSS				0	0	0	0	0	0
DUCT GAIN				0	0	0	0	0	0
HEAT GAIN PEOPLE	240			0	0	0	0	0	0
HEAT GAIN APPLIANCES/LIGHTS				555	555	0	0	0	0
TOTAL HT LOSS BTU/H				6038	2306	662	6676	1184	12736
TOTAL HT GAIN x 1.3 BTU/H				6505	1083	295	3769	437	1240

TOTAL HEAT GAIN BTU/H:

25406

TONS: 2.12

LOSS DUE TO VENTILATION LOAD BTU/H: 1529

STRUCTURAL HEAT LOSS: 41261

TOTAL COMBINED HEAT LOSS BTU/H: 42790

Michael O'Rourke

SITE NAME: GRANELLI HOMES CORP

BUILDER: GREENYORK HOMES

ALT 2ND FL

TYPE: LIANA 1

DATE: Jun-18

GFA: 2041

LO# 78999

 HEATING CFM 785
 TOTAL HEAT LOSS 41,261
 AIR FLOW RATE CFM 19.03

 COOLING CFM 785
 TOTAL HEAT GAIN 25,180
 AIR FLOW RATE CFM 31.18

 furnace pressure 0.6
 furnace filter 0.05
 a/c coil pressure 0.2
 available pressure for s/a & r/a 0.35

 #CARRIER
 59SP5A-60-12 60
 FAN SPEED
 LOW 0
 MEDLOW 785
 MEDIUM 845
 MEDIUM HIGH 970
 HIGH 1030

 AFUE = 96 %
 INPUT (BTU/H) = 60,000
 OUTPUT (BTU/H) = 58,000

 DESIGN CFM = 785
 CFM @ .6" E.S.P.

TEMPERATURE RISE 68 °F

RUN COUNT	4th	3rd	2nd	1st	Bas
S/A	0	0	9	7	4
R/A	0	0	4	1	1

All S/A diffusers 4"x10" unless noted otherwise on layout.

All S/A runs 5"Ø unless noted otherwise on layout.

RUN #	1	2	3	4	5	6	7	8	10	13	14	16	17	18	19	20	21	23	24
ROOM NAME	MBR	ENS	WIC	BED-2	BED-3	BED-4	BATH	BED-4	MBR	K/L/D	K/L/D	K/L/D	LAUN	W/R	FOY	FOY	BAS	BAS	BAS
RM LOSS MBH	1.32	1.65	0.40	1.72	0.99	1.70	0.85	1.70	1.32	2.01	2.01	2.01	2.31	0.66	3.34	3.34	3.48	3.48	3.48
CFM PER RUN HEAT	25	31	8	33	19	32	16	32	25	38	38	38	44	13	64	64	66	66	66
RM GAIN MBH	1.68	1.02	0.11	1.74	1.66	1.78	0.41	1.78	1.68	2.17	2.17	2.17	1.08	0.30	1.88	1.88	0.42	0.42	0.42
CFM PER RUN COOLING	52	32	4	54	52	55	13	55	52	68	68	68	34	9	59	59	13	13	13
ADJUSTED PRESSURE	0.17	0.17	0.17	0.17	0.17	0.17	0.17	0.17	0.17	0.17	0.17	0.17	0.17	0.17	0.17	0.17	0.17	0.17	0.17
ACTUAL DUCT LGH	29	52	29	38	31	37	20	45	40	20	30	25	18	15	28	30	25	29	12
EQUIVALENT LENGTH	165	170	150	155	205	125	170	145	145	120	130	150	130	130	140	120	120	160	140
TOTAL EFFECTIVE LENGTH	194	222	179	193	236	162	190	190	185	140	160	175	148	145	168	150	145	189	152
ADJUSTED PRESSURE	0.09	0.08	0.1	0.09	0.07	0.11	0.09	0.09	0.09	0.12	0.11	0.1	0.12	0.12	0.1	0.11	0.12	0.09	0.11
ROUND DUCT SIZE	4	4	4	6	5	5	4	5	4	5	5	5	4	4	5	5	5	6	6
HEATING VELOCITY (ft/min)	287	356	92	168	140	235	184	235	287	279	279	279	505	149	470	470	485	337	485
COOLING VELOCITY (ft/min)	597	367	46	275	382	404	149	404	597	499	499	499	390	103	433	433	95	66	95
OUTLET GRILL SIZE	3X10	3X10	3X10	4X10	3X10	3X10	3X10	3X10	3X10	3X10	3X10	3X10	3X10	3X10	3X10	3X10	3X10	4X10	3X10
TRUNK	C	A	C	E	E	E	E	E	C	A	A	C	C	E	D	D	A	C	E

RUN #	25
ROOM NAME	BAS
RM LOSS MBH	3.48
CFM PER RUN HEAT	66
RM GAIN MBH	0.42
CFM PER RUN COOLING	13
ADJUSTED PRESSURE	0.17
ACTUAL DUCT LGH	30
EQUIVALENT LENGTH	120
TOTAL EFFECTIVE LENGTH	150
ADJUSTED PRESSURE	0.11
ROUND DUCT SIZE	5-6
HEATING VELOCITY (ft/min)	485
COOLING VELOCITY (ft/min)	95
OUTLET GRILL SIZE	3X10
TRUNK	D

CITY OF BRAMPTON
 BUILDING DIVISION
 REVIEWED BY: S. DESAI
 APR 16 2019 *SD*
 ATTACHED NOTES ARE PART
 OF REVIEWED DRAWINGS
 ALL WORK MUST COMPLY WITH OBC

SUPPLY AIR TRUNK SIZE

	TRUNK CFM	STATIC PRESS.	ROUND DUCT	RECT DUCT		VELOCITY (ft/min)
TRUNK A	173	0.08	7.3	8	X	8
TRUNK B	0	0.00	0	0	X	8
TRUNK C	379	0.08	9.7	12	X	8
TRUNK D	194	0.10	7.2	8	X	8
TRUNK E	405	0.07	10.3	12	X	8
TRUNK F	0	0.00	0	0	X	8

RETURN AIR TRUNK SIZE

	TRUNK CFM	STATIC PRESS.	ROUND DUCT	RECT DUCT		VELOCITY (ft/min)
TRUNK O	0	0.06	0	0	X	8
TRUNK P	0	0.06	0	0	X	8
TRUNK Q	0	0.06	0	0	X	8
TRUNK R	0	0.06	0	0	X	8
TRUNK S	0	0.06	0	0	X	8
TRUNK T	0	0.06	0	0	X	8
TRUNK U	0	0.06	0	0	X	8
TRUNK V	0	0.06	0	0	X	8
TRUNK W	0	0.06	0	0	X	8
TRUNK X	785	0.06	13.8	22	X	8
TRUNK Y	0	0.06	0	0	X	8
TRUNK Z	0	0.06	0	0	X	8
DROP	785	0.06	13.8	24	X	10

RETURN AIR #	1	3	4	5	6	0	0	0	0	0	0	0	0	0	0	BR
AIR VOLUME	95	0	95	95	85	315	0	0	0	0	0	0	0	0	0	100
PLENUM PRESSURE	0.15	0.15	0.15	0.15	0.15	0.15	0.15	0.15	0.15	0.15	0.15	0.15	0.15	0.15	0.15	0.15
ACTUAL DUCT LGH	34	1	38	40	48	12	1	1	1	1	1	1	1	1	1	18
EQUIVALENT LENGTH	185	165	185	165	185	120	0	0	0	0	0	0	0	0	0	190
TOTAL EFFECTIVE LH	219	166	223	205	233	132	1	1	1	1	1	1	1	1	1	208
ADJUSTED PRESSURE	0.07	0.09	0.07	0.07	0.06	0.11	14.80	14.80	14.80	14.80	14.80	14.80	14.80	14.80	14.80	0.07
ROUND DUCT SIZE	6	0	6	6	6	8.4	0	0	0	0	0	0	0	0	0	6.1
INLET GRILL SIZE	8	0	8	8	8	8	0	0	0	0	0	0	0	0	0	8
INLET GRILL SIZE	X	X	X	X	X	X	X	X	X	X	X	X	X	X	X	X
INLET GRILL SIZE	14	0	14	14	14	24	0	0	0	0	0	0	0	0	0	14

TYPE: LIANA 1
SITE NAME: GRANELLI HOMES CORP

LO # 78999
ALT 2ND FL

RESIDENTIAL MECHANICAL VENTILATION DESIGN SUMMARY
COMBUSTION APPLIANCES 9.32.3.1(1)
a) ☒ Direct vent (sealed combustion) only
b) ☐ Positive venting induced draft (except fireplaces)
c) ☐ Natural draft, B-vent or induced draft gas fireplace
d) ☐ Solid Fuel (including fireplaces)
e) ☐ No Combustion Appliances

HEATING SYSTEM
☒ Forced Air ☐ Non Forced Air
☐ Electric Space Heat

HOUSE TYPE 9.32.1(2)
☒ I Type a) or b) appliance only, no solid fuel
☐ II Type I except with solid fuel (including fireplaces)
☐ III Any Type c) appliance
☐ IV Type I, or II with electric space heat
☐ Other: Type I, II or IV no forced air

SYSTEM DESIGN OPTIONS O.N.H.W.P.
☐ 1 Exhaust only/Forced Air System
☐ 2 HRV with Ducting/Forced Air System
☒ 3 HRV Simplified/connected to forced air system
☐ 4 HRV with Ducting/non forced air system
☐ Part 6 Design

TOTAL VENTILATION CAPACITY 9.32.3.3(1)

Basement + Master Bedroom	2 *	@ 21.2 cfm	42.4	cfm
Other Bedrooms	3	@ 10.6 cfm	31.8	cfm
Kitchen & Bathrooms	4	@ 10.6 cfm	42.4	cfm
Other Rooms	4	@ 10.6 cfm	42.4	cfm
Table 9.32.3.A.	TOTAL		159.0	cfm

PRINCIPAL VENTILATION CAPACITY REQUIRED 9.32.3.4.(1)

1 Bedroom	31.8	cfm
2 Bedroom	47.7	cfm
3 Bedroom	63.6	cfm
4 Bedroom	79.5	cfm
5 Bedroom	95.4	cfm
TOTAL		79.5 cfm

SUPPLEMENTAL VENTILATION CAPACITY 9.32.3.5.

Total Ventilation Capacity	159	cfm
Less Principal Ventil. Capacity	79.5	cfm
Required Supplemental Capacity	79.5	cfm

PRINCIPAL EXHAUST FAN CAPACITY
Model: LIFE BREATH RNC5-HEX Location: BSMT
79.5 cfm 3.0 sones ☒ HVI Approved

PRINCIPAL EXHAUST HEAT LOSS CALCULATION

CFM	ΔT °F	FACTOR	% LOSS
79.5 CFM	74 F	1.08	0.24

SUPPLEMENTAL FANS NUTONE

Location	Model	cfm	HVI	Sones
ENS	QTXEN050C	50	<input checked="" type="checkbox"/>	0.3
BATH	QTXEN050C	50	<input checked="" type="checkbox"/>	0.3
LAUN	QTXEN050C	50	<input checked="" type="checkbox"/>	0.3
W/R	QTXEN050C	50	<input checked="" type="checkbox"/>	0.3

HEAT RECOVERY VENTILATOR 9.32.3.11.
Model: LIFE BREATH RNC5-HEX
108 cfm high 59 cfm low
76 % Sensible Efficiency @ 32 deg F (0 deg C) ☒ HVI Approved

LOCATION OF INSTALLATION
Lot: Concession
Township: Plan:
Address:
Roll #: Building Permit #
BUILDER: GREENYORK HOMES
Name:
Address:
City:
Telephone #: Fax #:
INSTALLING CONTRACTOR
Name:
Address:
City:
Telephone #: Fax #:
DESIGNER CERTIFICATION
I hereby certify that this ventilation system has been designed in accordance with the Ontario Building Code.
Name: HVAC Designs Ltd.
Signature: *Michael O'Rourke*
HRAI #: 001820
Date: June-18

I REVIEW AND TAKE RESPONSIBILITY FOR THE DESIGN WORK AND AM QUALIFIED IN THE APPROPRIATE CATEGORY AS AN "OTHER DESIGNER" UNDER DIVISION C, 3.2.5 OF THE BUILDING CODE.
INDIVIDUAL BCIN: 19669 *Michael O'Rourke* MICHAEL O'ROURKE

HEAT LOSS AND GAIN SUMMARY SHEET

MODEL: LIANA 1

ALT 2ND FL

BUILDER: GREENYORK HOMES

SFQT: 2041

LO# 78999

SITE: GRANELLI HOMES CORP

DESIGN ASSUMPTIONS

HEATING	°F	COOLING	°F
OUTDOOR DESIGN TEMP.	-2	OUTDOOR DESIGN TEMP.	86
INDOOR DESIGN TEMP.	72	INDOOR DESIGN TEMP. (MAX 75°F)	75

BUILDING DATA

ATTACHMENT:	DETACHED	# OF STORIES (+BASEMENT):	3
FRONT FACES:	EAST	ASSUMED (Y/N):	Y
AIR CHANGES PER HOUR:	3.57	ASSUMED (Y/N):	Y
AIR TIGHTNESS CATEGORY:	AVERAGE	ASSUMED (Y/N):	Y
WIND EXPOSURE:	SHELTERED	ASSUMED (Y/N):	Y
HOUSE VOLUME (ft³):	28440.0	ASSUMED (Y/N):	Y
INTERNAL SHADING:	BLINDS/CURTAINS	ASSUMED OCCUPANTS:	5
INTERIOR LIGHTING LOAD (Btu/h/ft²):	1.27	DC BRUSHLESS MOTOR (Y/N):	Y
FOUNDATION CONFIGURATION	BCIN_1	DEPTH BELOW GRADE:	6.0 ft
LENGTH: 46.0 ft	WIDTH: 30.0 ft	EXPOSED PERIMETER:	137.0 ft

2012 OBC - COMPLIANCE PACKAGE**Component**

Ceiling with Attic Space Minimum RSI (R)-Value
Ceiling Without Attic Space Minimum RSI (R)-Value
Exposed Floor Minimum RSI (R)-Value
Walls Above Grade Minimum RSI (R)-Value
Basement Walls Minimum RSI (R)-Value
Below Grade Slab Entire surface > 600 mm below grade Minimum RSI (R)-Value
Edge of Below Grade Slab ≤ 600 mm Below Grade Minimum RSI (R)-Value
Heated Slab or Slab ≤ 600 mm below grade Minimum RSI (R)-Value
Windows and Sliding Glass Doors Maximum U-Value
Skylights Maximum U-Value
Space Heating Equipment Minimum AFUE
HRV Minimum Efficiency
Domestic Hot Water Heater Minimum EF

**Compliance Package
A1**

Nominal	Min. Eff.
60	59.22
31	27.65
31	29.80
22	17.03
20 ci	21.12
-	-
10	10
10	11.13
0.28	-
0.49	-
0.96	-
75%	-
0.8	-


INDIVIDUAL BCIN: 19669

MICHAEL O'ROURKE

Michael O'Rourke


Residential Foundation Thermal Load Calculator

Supplemental tool for CAN/CSA-F280

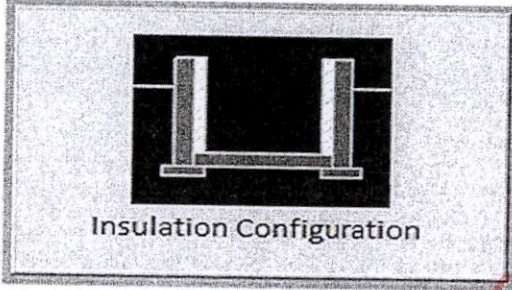Weather Station Description		
Province:	Ontario	
Region:	Brampton	
Site Description		
Soil Conductivity:	Normal conductivity: dry sand, loam, clay	
Water Table:	Normal (7-10 m, 23-33 ft)	
Foundation Dimensions		
Floor Length (m):	14.0	 Insulation Configuration
Floor Width (m):	9.1	
Exposed Perimeter (m):	41.8	
Wall Height (m):	2.7	
Depth Below Grade (m):	1.83	
Window Area (m ²):	0.7	
Door Area (m ²):	3.7	
Radiant Slab		
Heated Fraction of the Slab:	0	
Fluid Temperature (°C):	33	
Design Months		
Heating Month	1	
Foundation Loads		
Heating Load (Watts):		1350

TYPE: LIANA 1
LO# 78999

ALT 2ND FL

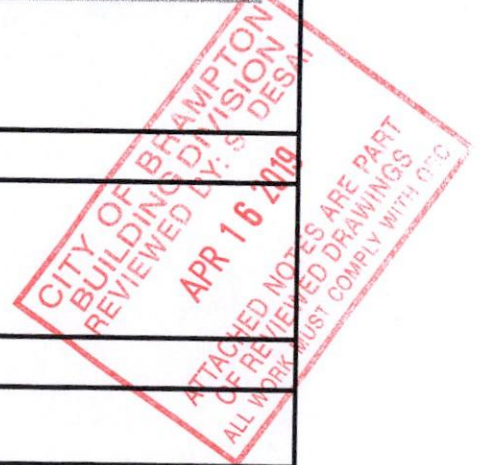

Air Infiltration Residential Load Calculator

Supplemental tool for CAN/CSA-F280

Weather Station Description			
Province:	Ontario		
Region:	Brampton		
Weather Station Location:	Open flat terrain, grass		
Anemometer height (m):	10		
Local Shielding			
Building Site:	Suburban, forest		
Walls:	Heavy		
Flue:	Heavy		
Highest Ceiling Height (m):	6.71		
Building Configuration			
Type:	Detached		
Number of Stories:	Two		
Foundation:	Full		
House Volume (m ³):	805.3		
Air Leakage/Ventilation			
Air Tightness Type:	Present (1961-) (3.57 ACH)		
Custom BDT Data:	ELA @ 10 Pa.	1073.5 cm ²	
	3.57	ACH @ 50 Pa	
Mechanical Ventilation (L/s):	Total Supply	Total Exhaust	
	37.5	37.5	
Flue Size			
Flue #:	#1	#2	#3
Diameter (mm):	0	0	0
Natural Infiltration Rates			
Heating Air Leakage Rate (ACH/H):	0.325		
Cooling Air Leakage Rate (ACH/H):	0.106		

TYPE: LIANA 1
LO# 78999

ALT 2ND FL

CSA F280-12 Residential Heat Loss and Heat Gain Calculations
Formula Sheet (For Air Leakage / Ventilation Calculation)

LO#: 78999

Model: LIANA 1

Builder: GREENYORK HOMES

Date: 6/19/2018

Volume Calculation
House Volume

Level	Floor Area (ft²)	Floor Height (ft)	Volume (ft³)
Bsmt	909	9	8181
First	909	10	9090
Second	1241	9	11169
Third	0	9	0
Fourth	0	9	0
Total:			28,440.0 ft³
Total:			805.3 m³

Air Change & Delta T Data

WINTER NATURAL AIR CHANGE RATE	0.325
SUMMER NATURAL AIR CHANGE RATE	0.106

Design Temperature Difference				
	Tin °C	Tout °C	ΔT °C	ΔT °F
Winter DTDh	22	-19	41	74
Summer DTDc	24	30	6	11

5.2.3.1 Heat Loss due to Air Leakage

$$HL_{airb} = LR_{airh} \times \frac{V_b}{3.6} \times DTD_h \times 1.2$$

0.325 x 223.70 x 41 °C x 1.2 = 3593 W

= 12258 Btu/h

6.2.6 Sensible Gain due to Air Leakage

$$HG_{salb} = LR_{airc} \times \frac{V_b}{3.6} \times DTD_c \times 1.2$$

= 0.106 x 223.70 x 6 °C x 1.2 = 173 W

= 591 Btu/h

5.2.3.2 Heat Loss due to Mechanical Ventilation

$$HL_{vairb} = PVC \times DTD_h \times 1.08 \times (1 - E)$$

80 CFM x 74 °F x 1.08 x 0.24 = 1529 Btu/h

6.2.7 Sensible heat Gain due to Ventilation

$$HL_{vairb} = PVC \times DTD_h \times 1.08 \times (1 - E)$$

80 CFM x 11 °F x 1.08 x 0.24 = 227 Btu/h


5.2.3.3 Calculation of Air Change Heat Loss for Each Room (Floor Multiplier Section)

$$HL_{airr} = \text{Level Factor} \times HL_{airbv} \times \{(HL_{agcr} + HL_{bgcr}) \div (HL_{agclevel} + HL_{bgclevel})\}$$

Level	Level Factor (LF)	HLairve Air Leakage + Ventilation Heat Loss (Btu/h)	Level Conductive Heat Loss: (HL _{clevel})	Air Leakage Heat Loss Multiplier (LF x HLairbv / HLlevel)
1	0.5	12,258	7,791	0.787
2	0.3		12,005	0.306
3	0.2		8,741	0.280
4	0		0	0.000
5	0		0	0.000

*HLairbv = Air leakage heat loss + ventilation heat loss

*For a balanced or supply only ventilation system HLairve = 0

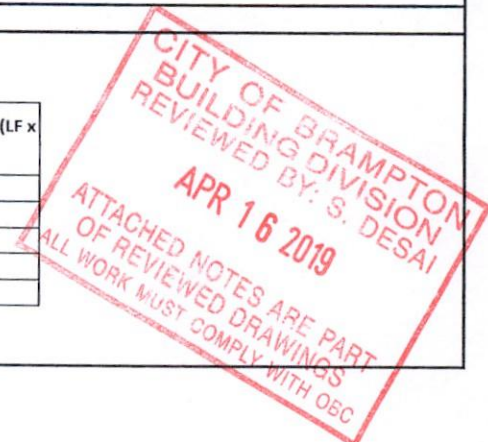

RECEIVED


APR 17 2019

Building Division

HVAC Designs Ltd.
375 Finley Ave, Suite 202
Ajax ON, L1S 2E2
905-619-2300

Residential Foundation Thermal Load Calculator

Supplemental tool for CAN/CSA-F280

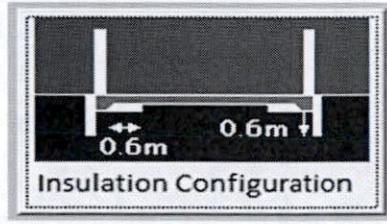Weather Station Description		
Province:	Ontario	
Region:	Brampton	
Site Description		
Soil Conductivity:	Normal conductivity: dry sand, loam, clay	
Water Table:	Normal (7-10 m, 23-33 ft)	
Foundation Dimensions		
Length (m):	0.3	
Width (m):	4.0	
Exposed Perimeter (m):	4.6	
Radiant Slab		
Heated Fraction of the Slab:	0	RECEIVED APR 17 2019 Building Division
Fluid Temperature (°C):	33	
Design Months		
Heating Month	1	
Results		
Heating Load (Watts):	32	

TYPE: LIANA 1
LO# 78998

CITY OF BRAMPTON
BUILDING DIVISION
REVIEWED BY: S. DESAI
APR 18 2019
ATTACHED NOTES ARE PART
OF REVIEWED DRAWINGS
ALL WORK MUST COMPLY WITH OBC

Schedule 1: Designer Information

Use one form for each individual who reviews and takes responsibility for design activities with respect to the project.

A. Project Information

Building number, street name 5 PENLEA GATE	Unit no.	Lot/con. 29
Municipality BRAMPTON	Postal code	Plan number/ other description 43M-2057

B. Individual who reviews and takes responsibility for design activities

Name SANDY WHITE, P.Eng.	Firm ANDA ENGINEERING LTD.
Street address 5125 ARDOCH ROAD	Unit no. / Lot/con.
Municipality ARDOCH	Postal code K0H-1C0 Province ONTARIO E-mail design@andaengineering.com
Telephone number (613) 479-0161	Fax number () N/A Cell number (416) 476-1105

C. Design activities undertaken by individual identified in Section B. [Building Code Table 3.5.2.1. of Division C]

- | | | |
|--|--|--|
| <input type="checkbox"/> House | <input type="checkbox"/> HVAC – House | <input type="checkbox"/> Building Structural |
| <input type="checkbox"/> Small Buildings | <input type="checkbox"/> Building Services | <input checked="" type="checkbox"/> Plumbing – House |
| <input type="checkbox"/> Large Buildings | <input type="checkbox"/> Detection, Lighting and Power | <input type="checkbox"/> Plumbing – II Buildings |
| <input type="checkbox"/> Complex Buildings | <input type="checkbox"/> Fire Protection | <input type="checkbox"/> On-site Sewage Systems |

Description of designer's work

LIANA 1 - ELEV. 2 (4 BEDROOM)

GRANELLI HOMES CORP.

D. Declaration of Designer

I **SANDY WHITE,** declare that (choose one as appropriate):
(print name)

- ☐ I review and take responsibility for the design work on behalf of a firm registered under subsection 3.2.4. of Division C, of the Building Code. I am qualified, and the firm is registered, in the appropriate classes/categories.

Individual BCIN: _____

Firm BCIN: _____

- ☐ I review and take responsibility for the design and am qualified in the appropriate category as an "other designer" under subsection 3.2.5. of Division C, of the Building Code.

Individual BCIN: _____

Basis for exemption from registration: _____

- ☒ The design work is exempt from the registration and qualification requirements of the Building Code.
Basis for exemption from registration and qualification: **P.Eng. exempt, note 2**

I certify that:

- The information contained in this schedule is true to the best of my knowledge.
- I have submitted this application with the knowledge and consent of the firm.

2019/24/01

Date

SANDY
WHITE

Signature of Designer

NOTE:

- For the purposes of this form, "individual" means the "person" referred to in Clause 3.2.4.7(1) (c) of Division C, Article 3.2.5.1. of Division C, and all other persons who are exempt from qualification under Subsections 3.2.4. and 3.2.5. of Division C.
- Schedule 1 is not required to be completed by a holder of a license, temporary license, or a certificate of practice, issued by the Ontario Association of Architects. Schedule 1 is also not required to be completed by a holder of a license to practise, a limited license to practise, or a certificate of authorization, issued by the Association of Professional Engineers of Ontario.




Planning and Development Services
Building Division
8850 McLaughlin Road, Unit 1
Brampton, ON L6Y 5T1

WATER PIPE SIZING AND PLUMBING DATA SHEET

CERTIFIED MODEL WITH ONE DWELLING UNIT

THIS TABLE IS APPLICABLE FOR A HOUSE AFTER DECEMBER 31, 2017

Builder Name: Greenyork Homes
Certified Model Name: LIANA 1 OPT 2ND FLOOR (LO78999-P)
Optional Floor Layout:
Application No.:

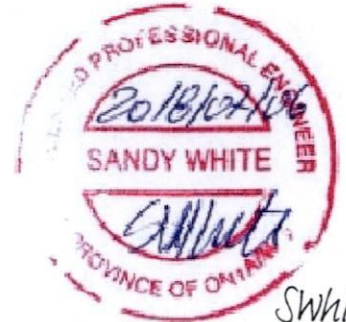

The Ontario Building Code Div. B, 7.6.3 regulates size and capacity of pipes for a new house. Please enter the number of individual fixtures as listed and bathroom groups⁽⁶⁾ or powder room groups⁽⁷⁾ per floor. The fixture units and required minimum size of water service will automatically be calculated.

Description	Basement Floor	First Floor	Second Floor	Third Floor
	Qty.	Qty.	Qty.	Qty.
Bathroom group ⁽⁶⁾	1		2	
Bidet				
Extra Shower			1	
Lav				
Bar Sink				
Powder room ⁽⁷⁾		1		
Kitchen Sink		1		
Dishwasher		1		
Laundry Tub		1		
Washing Machine		1		
Hose Bib		2		

Total Fixture Units 25.7

Minimum Diametre of Water Service Pipe

Required from the Property Line to the House (Inch) 3/4

Notes:

- (1) A potable water system shall be designed, constructed and installed to conform to good engineering practice appropriate to the circumstances, such as that described in the ASHRAE Handbooks and ASPE Data Books.
- (2) No water system between the point of connection with the water service pipe or the water meter and the first branch that supplies a water heater that serves more than one fixture shall be less than 3/4 in. in size.
- (3) The minimum water pressure at the entry to the building is 200 kPa, and the total maximum length of the water system is 90 m.
- (4) In a hot water distribution system of a developed length of more than 30 m from the HWT to the farthest fixture or supplying more than 4 storeys, the water temperature shall be maintained by, (a) recirculation, or (b) a self-regulating heat tracing system.

(5) Where piping may be exposed to freezing conditions, it shall be protected from the effects of freezing.

(6) A bathroom group consists of 1 water closet, 1 lavatory, and 1 bathtub (with or without showerhead).

(7) A powder room group consists of 1 water closet and 1 lavatory.


PLEASE SEE THE ATTACHED NOTES AS THEY FORM PART OF THE REVIEWED DOCUMENT

NOTES

1. DRAWINGS ARE TO BE PRINTED IN COLOUR
2. WHERE A 3/4"Ø TUB SPOUT/ SPIGOT CONNECTION IS USED ON THE BATHTUB FAUCET THE WATER SUPPLY PIPE SHALL BE 3/4"Ø TO THE BRANCH FOR THE BATHTUB
3. BASEMENT BATHROOM ROUGH-IN SHALL BE USED IN SIZING OF WATER PIPE
4. EXACT LOCATION OF ALL PLUMBING PIPING TO BE DETERMINED ON SITE

LEGEND

SYMBOL	DESCRIPTION (SEE PLAN FOR PIPE SIZING)
	WATER METER, PROVIDE SUPPLY PIPE SIZE/ Ø
	HOSE BIB
	PROPOSED COLD WATER LINE & RISER
	PROPOSED HOT WATER LINE & RISER
	FLOOR DRAIN

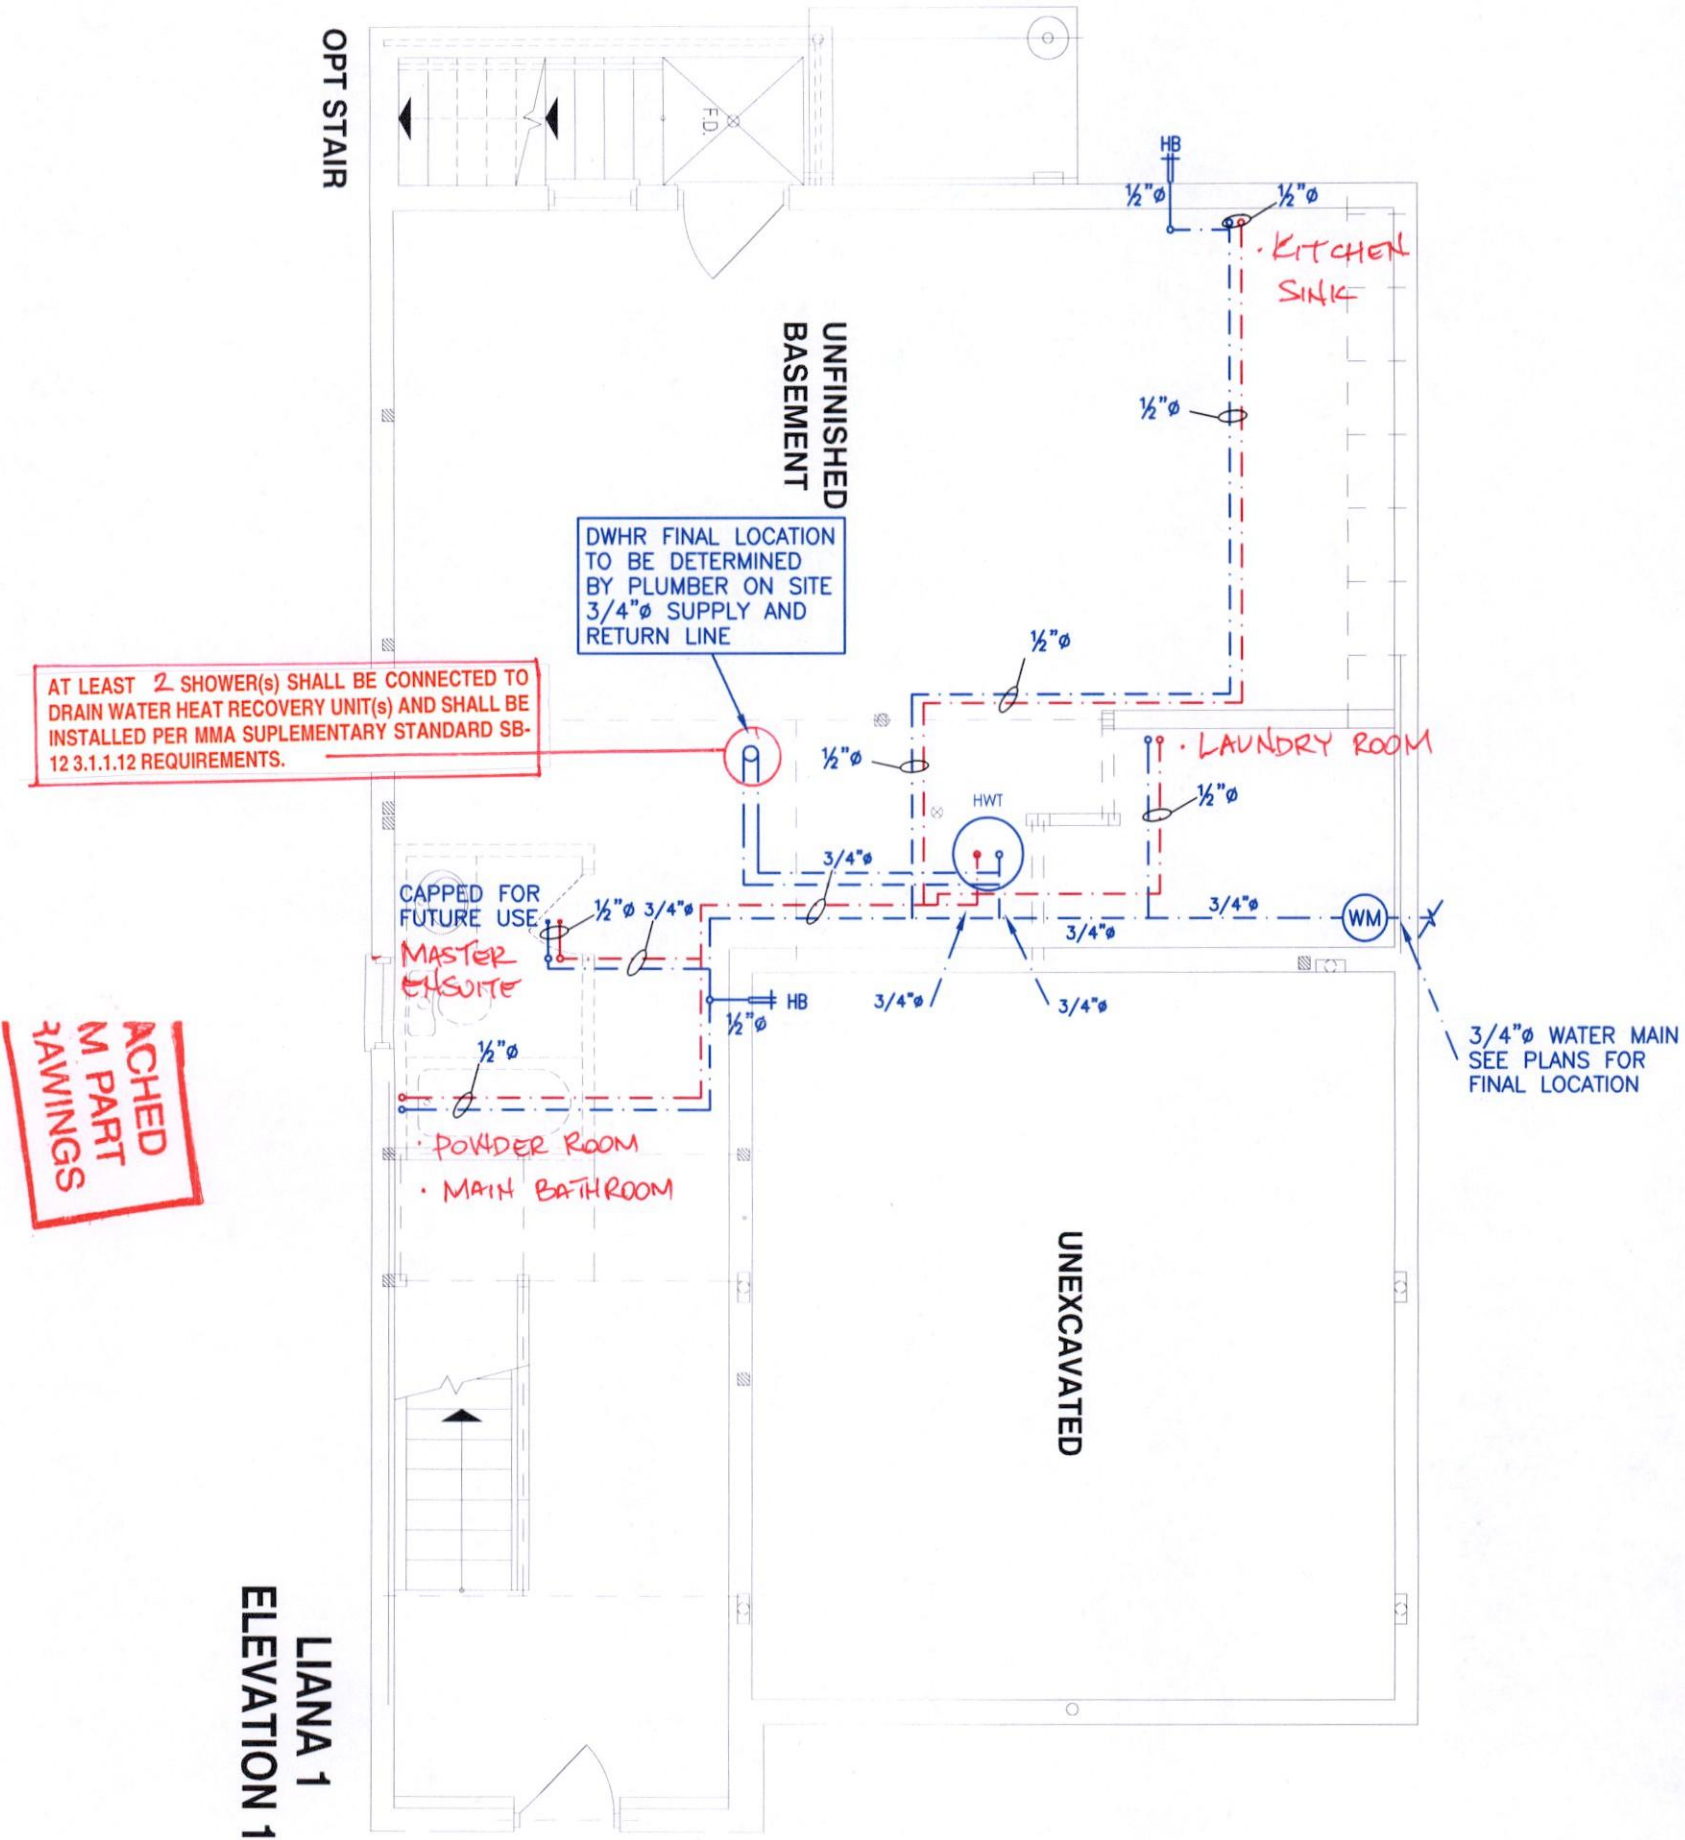

ALL PLUMBING SHALL CONFORM TO THE ONTARIO BUILDING CODE, O.B.C. 332/12, AS AMENDED, DIVISION B, PART 7.

CITY OF BRAMPTON
BUILDING DIVISION
REVIEWED
APR 03 2019
PLUMBING BY
KOFI MORIEL



Lot 29

Client
GREENYORK HOMES

Project Name
GRANELLI HOMES CORP
BRAMPTON, ONTARIO

ALT 2ND FL
LIANA 1

2041 sqft

HVACDESIGNS LTD.

375 Finley Ave. Suite 202 - Ajax, Ontario
L1S 2E2 Tel. 905.619.2300 - 905.420.5300 Fax 905.619.2375
Email: info@hvacdesigns.ca
Web: www.hvacdesigns.ca
Specializing in Residential Mechanical Design Services

Sheet Title
BASEMENT
PLUMBING
LAYOUT

Date
JULY 2018
Scale
3/16" = 1'-0"




LO# 78999-P

NOTES

1. DRAWINGS ARE TO BE PRINTED IN COLOUR
2. WHERE A 3/4"Ø TUB SPOUT/ SPIGOT CONNECTION IS USED ON THE BATHTUB FAUCET THE WATER SUPPLY PIPE SHALL BE 3/4"Ø TO THE BRANCH FOR THE BATHTUB
3. BASEMENT BATHROOM ROUGH-IN SHALL BE USED IN SIZING OF WATER PIPE
4. EXACT LOCATION OF ALL PLUMBING PIPING TO BE DETERMINED ON SITE

LEGEND

SYMBOL	DESCRIPTION (SEE PLAN FOR PIPE SIZING)
	WATER METER, PROVIDE SUPPLY PIPE SIZE/ Ø
	HOSE BIB
	PROPOSED COLD WATER LINE & RISER
	PROPOSED HOT WATER LINE & RISER
	FLOOR DRAIN

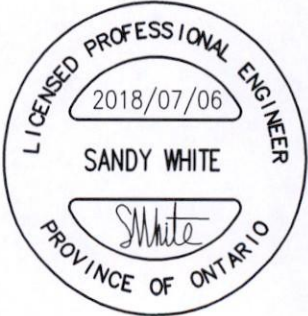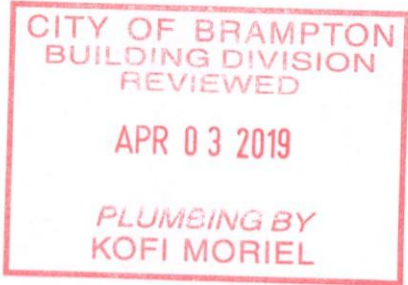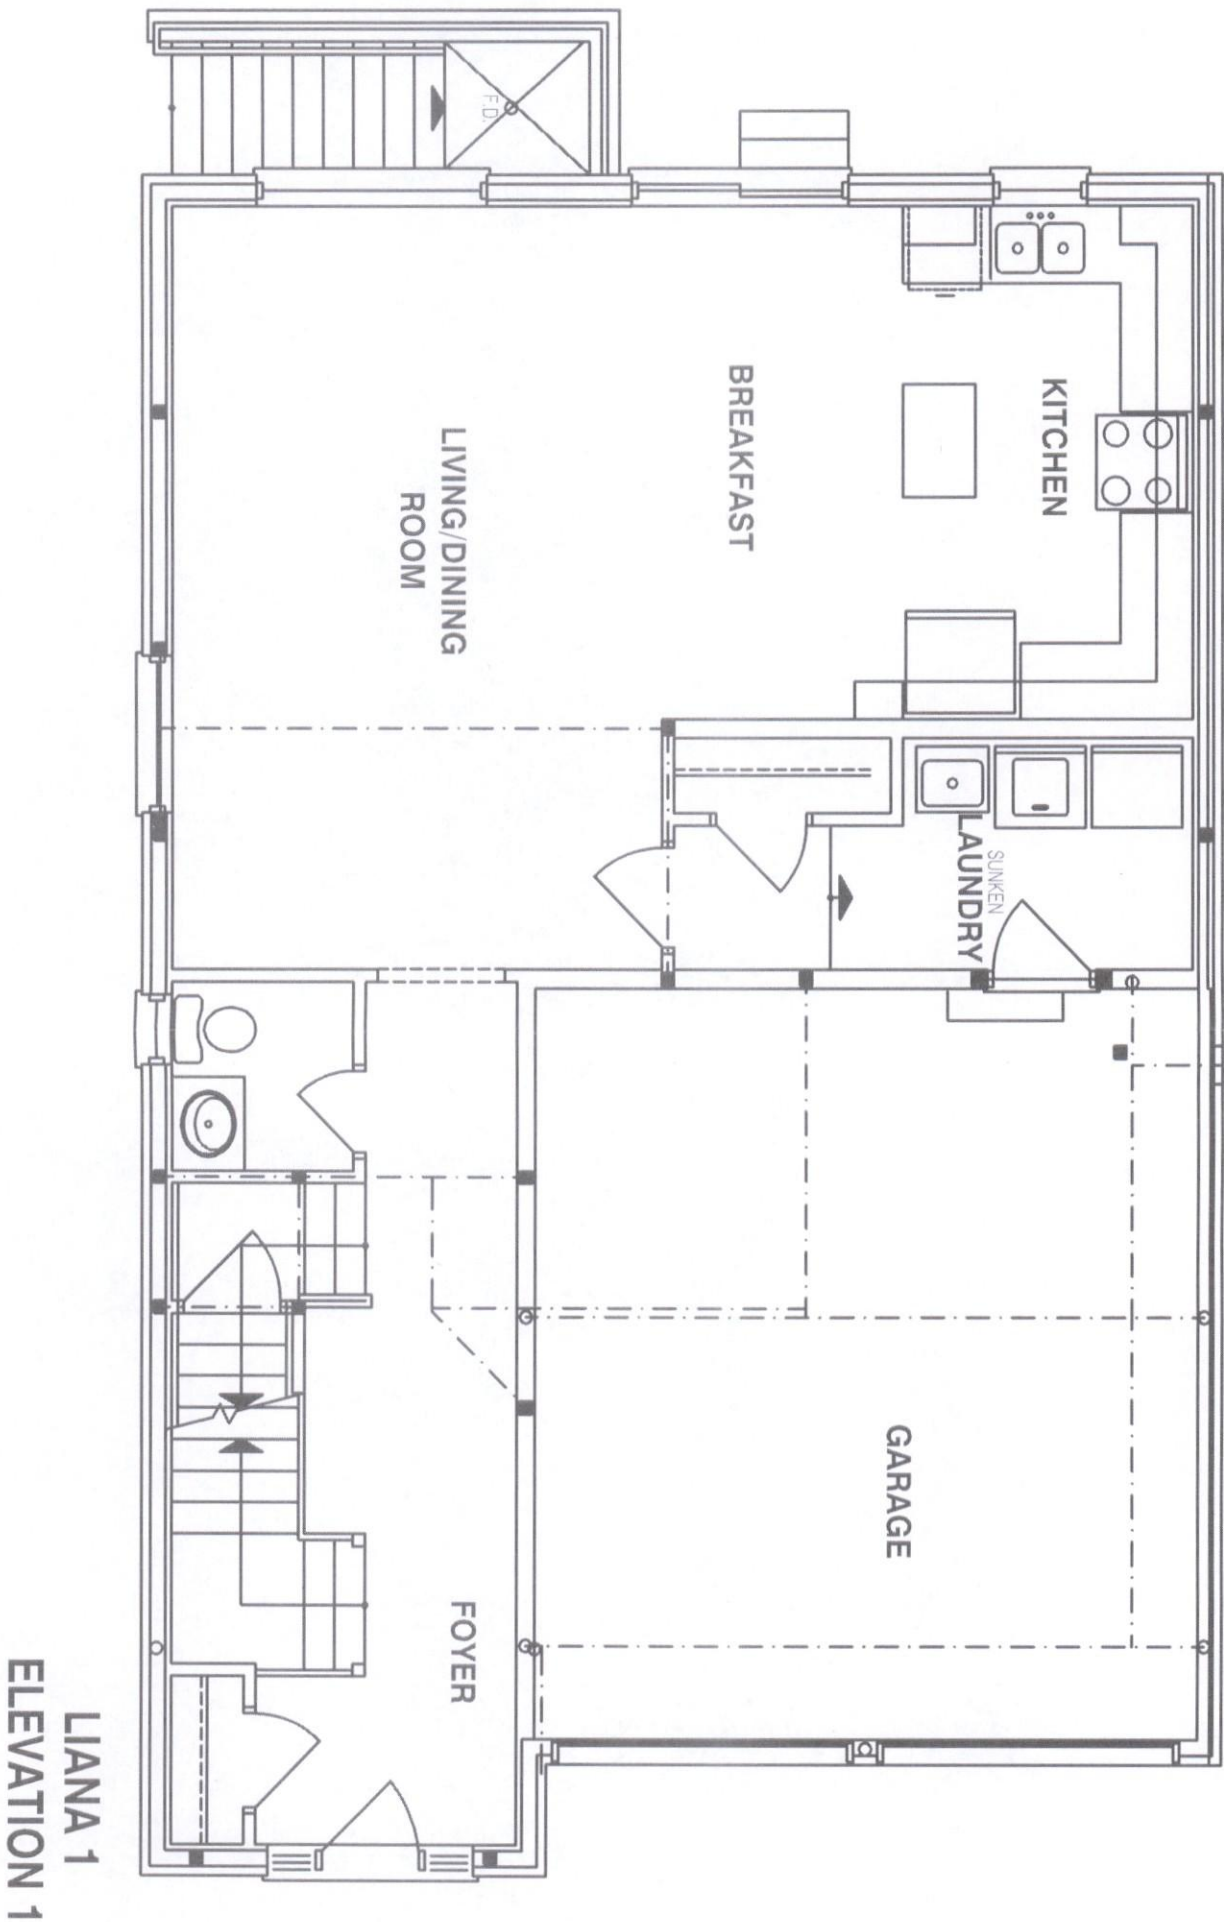

Client
GREENYORK HOMES

Project Name
GRANELLI HOMES CORP
BRAMPTON, ONTARIO
M-2057 LOT29
ALT 2ND FL
LIANA 1 2041 sqft

HVACDESIGNS LTD.
375 Finley Ave. Suite 202 - Ajax, Ontario
L1S 2E2 Tel. 905.619.2300 - 905.420.5300 Fax 905.619.2375
Email: info@hvacdesigns.ca
Web: www.hvacdesigns.ca
Specializing in Residential Mechanical Design Services

Sheet Title
FIRST FLOOR
PLUMBING
LAYOUT

Date JULY 2018
Scale 3/16" = 1'-0"



LO# 78999-P

NOTES

1. DRAWINGS ARE TO BE PRINTED IN COLOUR
2. WHERE A 3/4"Ø TUB SPOUT/ SPIGOT CONNECTION IS USED ON THE BATHTUB FAUCET THE WATER SUPPLY PIPE SHALL BE 3/4"Ø TO THE BRANCH FOR THE BATHTUB
3. BASEMENT BATHROOM ROUGH-IN SHALL BE USED IN SIZING OF WATER PIPE
4. EXACT LOCATION OF ALL PLUMBING PIPING TO BE DETERMINED ON SITE

LEGEND

SYMBOL	DESCRIPTION (SEE PLAN FOR PIPE SIZING)
	WATER METER, PROVIDE SUPPLY PIPE SIZE/ Ø
	HOSE BIB
	PROPOSED COLD WATER LINE & RISER
	PROPOSED HOT WATER LINE & RISER
	FLOOR DRAIN

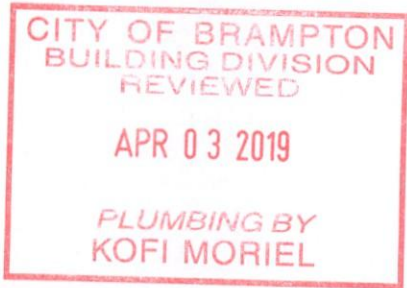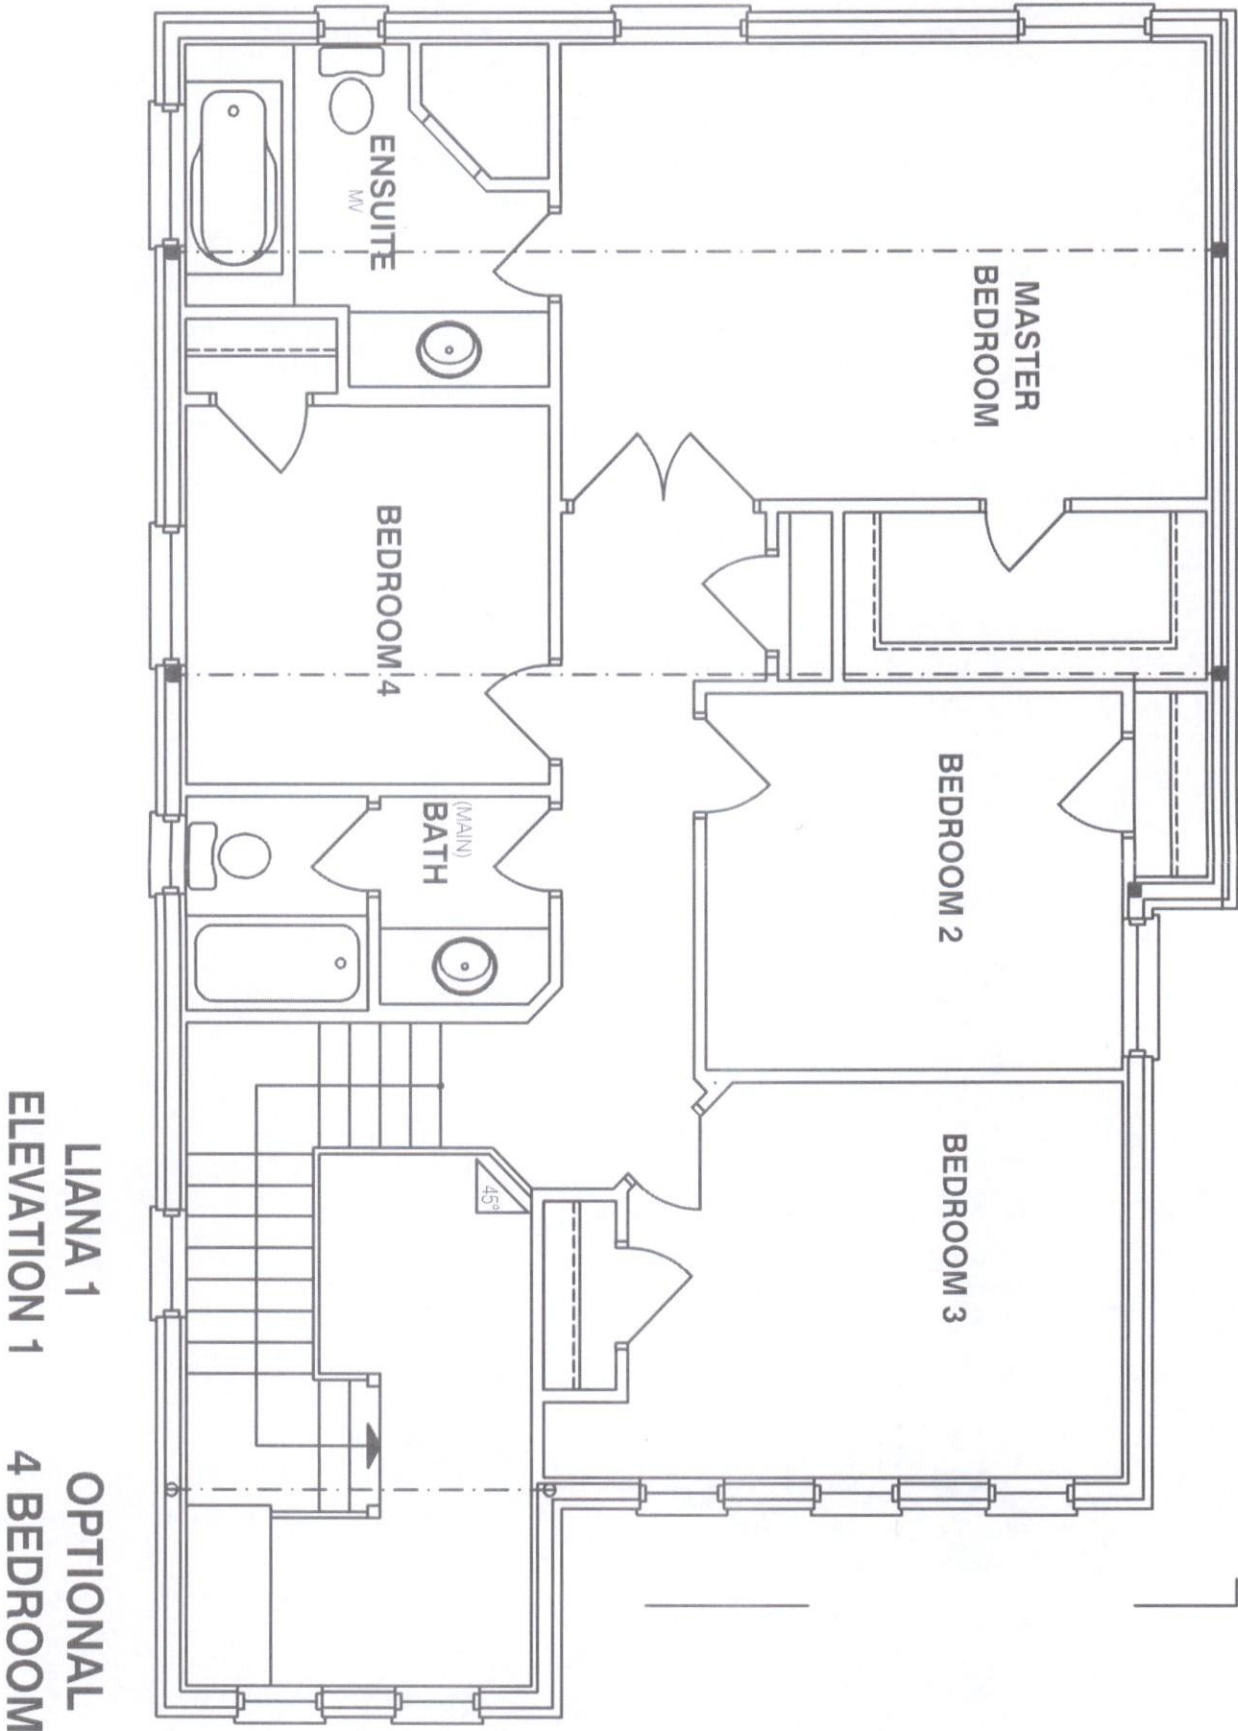

Client
GREENYORK HOMES

Project Name
GRANELLI HOMES CORP
BRAMPTON, ONTARIO

M-2057 LOT 29

ALT 2ND FL
LIANA 1

2041 sqft



375 Finley Ave. Suite 202 - Ajax, Ontario
L1S 2E2 Tel. 905.619.2300 - 905.420.5300 Fax 905.619.2375
Email: info@hvacdesigns.ca
Web: www.hvacdesigns.ca
Specializing in Residential Mechanical Design Services

Sheet Title
SECOND FLOOR
PLUMBING
LAYOUT

Date
JULY 2018

Scale
3/16" = 1'-0"

LO# 78999-P