

SITE PLAN REVIEW

LOT NO. 4 REGISTERED PLAN

THE PROPOSED LOT GRADING AND DRAINAGE IS APPROVED AS BEING IN CONFORMITY WITH THE OVERALL APPROVED GRADING PLANS FOR THE SUBDIVISION.

THIS REVIEW DOES NOT WARRANT THAT OTHER INFORMATION SHOWN ON THIS DRAWING IS ACCURATE OR COMPLETE. SOLE RESPONSIBILITY FOR THE DESIGN AND DETAILS SHALL REMAIN WITH THE DESIGNER.

NO COMMENT ☒ REVIEWED BY DL
COMMENTS AS NOTED ☐ DATE Jun. 20, 16

CDG CANDEVCON LIMITED
CONSULTING ENGINEERS AND PLANNERS




NOTE: BUILDER TO VERIFY LOCATION OF ALL HYDRANTS, STREET LIGHTS, TRANSFORMERS AND OTHER SERVICES. IF MIN. DIMENSIONS ARE NOT MAINTAINED BUILDER IS TO RELOCATE AT HIS OWN EXPENSE.

CLIENT
HIGHCASTLE HOMES
PROJECT/LOCATION
**RIVERWALK, PHASE 2
BRAMPTON, ON**
DRAWING
SITE PLAN

BUILDING STATISTICS	
REG. PLAN No.	
ZONE	R1E-19.0-2155
LOT NUMBER	4
LOT AREA(m ²)	643.50
BLDG AREA(m ²)	N/A
LOT COVERAGE(%)	N/A
No. OF STOREYS	2
MEAN HEIGHT(m)	10.52
INT. GARAGE DIMS(m)	8.53 X 6.71
GARAGE DOOR WIDTH(m)	3 X 2.44

LEGEND

FFE	FINISHED FLOOR ELEVATION
TFW	TOP OF FOUNDATION WALL
TBS	TOP OF BASEMENT SLAB
USF	UNDER SIDE FOOTING
USFR	UNDER SIDE FOOTING @ REAR
USFG	UNDER SIDE FOOTING @ GARAGE
TEF	TOP OF ENGINEERED FILL
R	NUMBER OF RISERS TO GRADE
WOD	WALKOUT DECK
LOB	LOOKOUT BASEMENT
WOB	WALK OUT BASEMENT
REV	REVERSE PLAN
STD	STANDARD PLAN
△	DOOR
○	WINDOW
⊠	BELL PEDISTAL
⊞	CABLE PEDISTAL
⊞	CATCH BASIN
⊞	DBL. CATCH BASIN
⊞	ENGINEERED FILL
⊞	HYDRO CONNECTION
⊞	FIRE HYDRANT
⊞	STREET LIGHT
⊞	MAIL BOX
⊞	TRANSFORMER
⊞	WATER VALVE
⊞	WATER CONNECTION
⊞	SEWER CONNECTIONS 2 LOTS
⊞	SEWER CONNECTIONS 1 LOT
⊞	AIR CONDITIONING
⊞	DOWN SPOUT TO SPLASH PAD
⊞	SWALE DIRECTION
---	CHAINLINK FENCE
---	PRIVACY FENCE
---	SOUND BARRIER
---	FOOTING TO BE EXTENDED TO 1.25 (MIN) BELOW GRADE

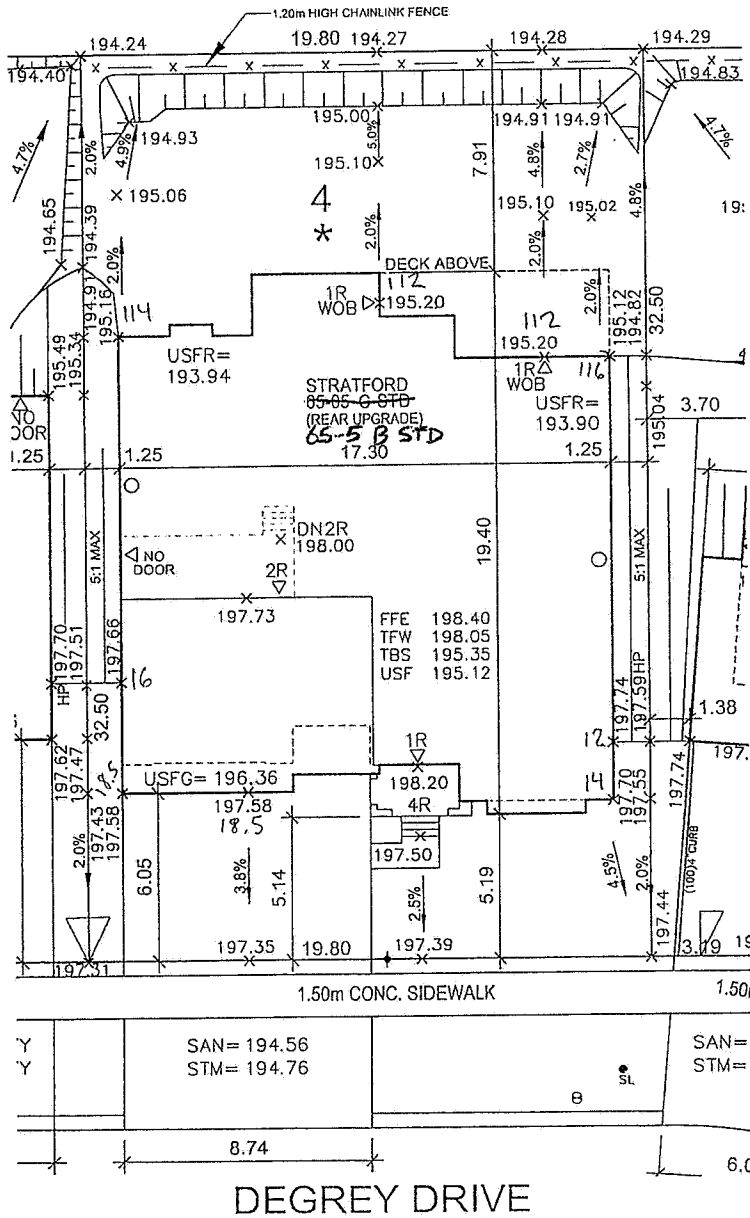

ISSUED OR REVISION COMMENTS				
NO.	DESCRIPTION	DATE	DWN	CHK
1	ISSUED FOR REVIEW	MAR. 15/16	BWS	NP
2	REV. AS PER ENG COMMENTS	APR. 07/16	DJH	DJH
3	ISSUED FOR FINAL	APR. 07/16	DJH	DJH

I, **DANIEL J. HANNINEN**, declare that I have reviewed and take design responsibility for the design work on behalf of RN Design Limited under Division C, Part 3, Subsection 3.2.4 of the Building Code. I am qualified, and the firm is registered, in the appropriate classes/categories.
QUALIFIED DESIGNER BCIN 20888
JUN 23 2016
 DATE SIGNATURE

DATE	SIGNATURE
DATE	SIGNATURE
DRAWN BY BWS	 RN design Imagine • Inspire • Create TEL: (905) 738-3177 FAX: (905) 738-5449 DWG@RNDDESIGN.COM
SCALE 1:250	
PROJECT No. 14021	
LOT NUMBER 4	

NOTES:
THE ENGINEERING PLANS HAVE NOT BEEN FINALIZED BY THE CITY AND ARE SUBJECT TO CHANGE.

SANITARY AND STORM INVERTS ARE NOT AVAILABLE AT THE TIME OF SITING; BUILDER TO VERIFY ELEVATIONS OF SANITARY AND STORM LATERALS IN RELATION TO BASEMENT USF ELEVATIONS FOR COMPLIANCE WITH MUNICIPAL STANDARDS PRIOR TO EXCAVATION.

It is the builder's complete responsibility to ensure that all plans submitted for approval fully comply with the Architectural Guidelines and all applicable regulations and requirements including zoning provisions and any provisions in the subdivision agreement. The Control Architect is not responsible in any way for examining or approving site (lotting) plans or working drawings with respect to any zoning or building code or permit matter or that any house can be properly built or located on its lot.

This is to certify that these plans comply with the applicable Architectural Design Guidelines approved by the City of BRAMPTON.