

SITE PLAN REVIEW

LOT NO 30 REGISTERED PLAN

THE PROPOSED LOT GRADING AND DRAINAGE IS APPROVED AS BEING IN CONFORMITY WITH THE OVERALL APPROVED GRADING PLANS FOR THE SUBDIVISION.

THIS REVIEW DOES NOT WARRANT THAT OTHER INFORMATION SHOWN ON THIS DRAWING IS ACCURATE OR COMPLETE. SOLE RESPONSIBILITY FOR THE DESIGN AND DETAILS SHALL REMAIN WITH THE DESIGNER.

NO COMMENT REVIEWED BY DATE April 4, 2016

CANDEVCON LIMITED CONSULTING ENGINEERS AND PLANNERS

NOTE: BUILDER TO VERIFY LOCATION OF ALL HYDRANTS, STREET LIGHTS, TRANSFORMERS AND OTHER SERVICES. IF MIN. DIMENSIONS ARE NOT MAINTAINED BUILDER IS TO RELOCATE AT HIS OWN EXPENSE.

CLIENT HIGHCASTLE HOMES PROJECT/LOCATION RIVERWALK, PHASE 2 BRAMPTON, ON DRAWING SITE PLAN


BUILDING STATISTICS	
REG. PLAN No.	
ZONE	R1E-15.0-2153
LOT NUMBER	30
LOT AREA(m ²)	642.98
BLDG AREA(m ²)	N/A
LOT COVERAGE(%)	N/A
No. OF STOREYS	2
MEAN HEIGHT(m)	9.25
INT. GARAGE DIMS(m)	6.10m x 6.10m
GARAGE DOOR WIDTH(m)	2 X 2.44m

LEGEND	
FFE	FINISHED FLOOR ELEVATION
TFW	TOP OF FOUNDATION WALL
TBS	TOP OF BASEMENT SLAB
USF	UNDER SIDE FOOTING
USFR	UNDER SIDE FOOTING @ REAR
USFG	UNDER SIDE FOOTING @ GARAGE
TEF	TOP OF ENGINEERED FILL
R	NUMBER OF RISERS TO GRADE
WOD	WALKOUT DECK
LOB	LOOKOUT BASEMENT
WOB	WALK OUT BASEMENT
REV	REVERSE PLAN
STD	STANDARD PLAN
△	DOOR
○	WINDOW
⊗	BELL PEDISTAL
⊠	CABLE PEDISTAL
□	CATCH BASIN
⊞	DBL. CATCH BASIN
✱	ENGINEERED FILL
⊕	HYDRO CONNECTION
⊙	FIRE HYDRANT
⊛	STREET LIGHT
⊞	MAIL BOX
⊞	TRANSFORMER
⊞	WATER VALVE
⊞	WATER CONNECTION
▽	SEWER CONNECTIONS 2 LOTS
▽	SEWER CONNECTIONS 1 LOT
⊞	AIR CONDITIONING
⊞	DOWN SPOUT TO SPLASH PAD
→	SWALE DIRECTION
— x —	CHAINLINK FENCE
— xx —	PRIVACY FENCE
— xxx —	SOUND BARRIER
---	FOOTING TO BE EXTENDED TO 1.25 (MIN) BELOW GRADE

ISSUED OR REVISION COMMENTS				
NO.	DESCRIPTION	DATE	DWN	CHK
1.	ISSUED FOR REVIEW	MAR. 07/16	MA	NP
2.	ISSUED FOR FINAL	MAR. 30/16	MA	NP

I, NATALIE PANDOLFI, DECLARE THAT I HAVE REVIEWED AND TAKE DESIGN RESPONSIBILITY FOR THE DESIGN WORK ON BEHALF OF RN DESIGN LIMITED, UNDER DIVISION C, PART3, SUBSECTION 3.2.4. OF THE BUILDING CODE. I AM QUALIFIED, AND THE FIRM IS REGISTERED, IN THE APPROPRIATE CLASSES/CATEGORIES. QUALIFIED DESIGNER BCIN 41549 FIRM BCIN 26995 MAR. 30/16 DATE SIGNATURE

DRAWN BY MA SCALE 1:250 PROJECT No. 14021 LOT NUMBER 30 RN design Imagine • Inspire • Create TEL.(905)738-3177 FAX.(905)738-5449 DWG@RNDESIGN.COM

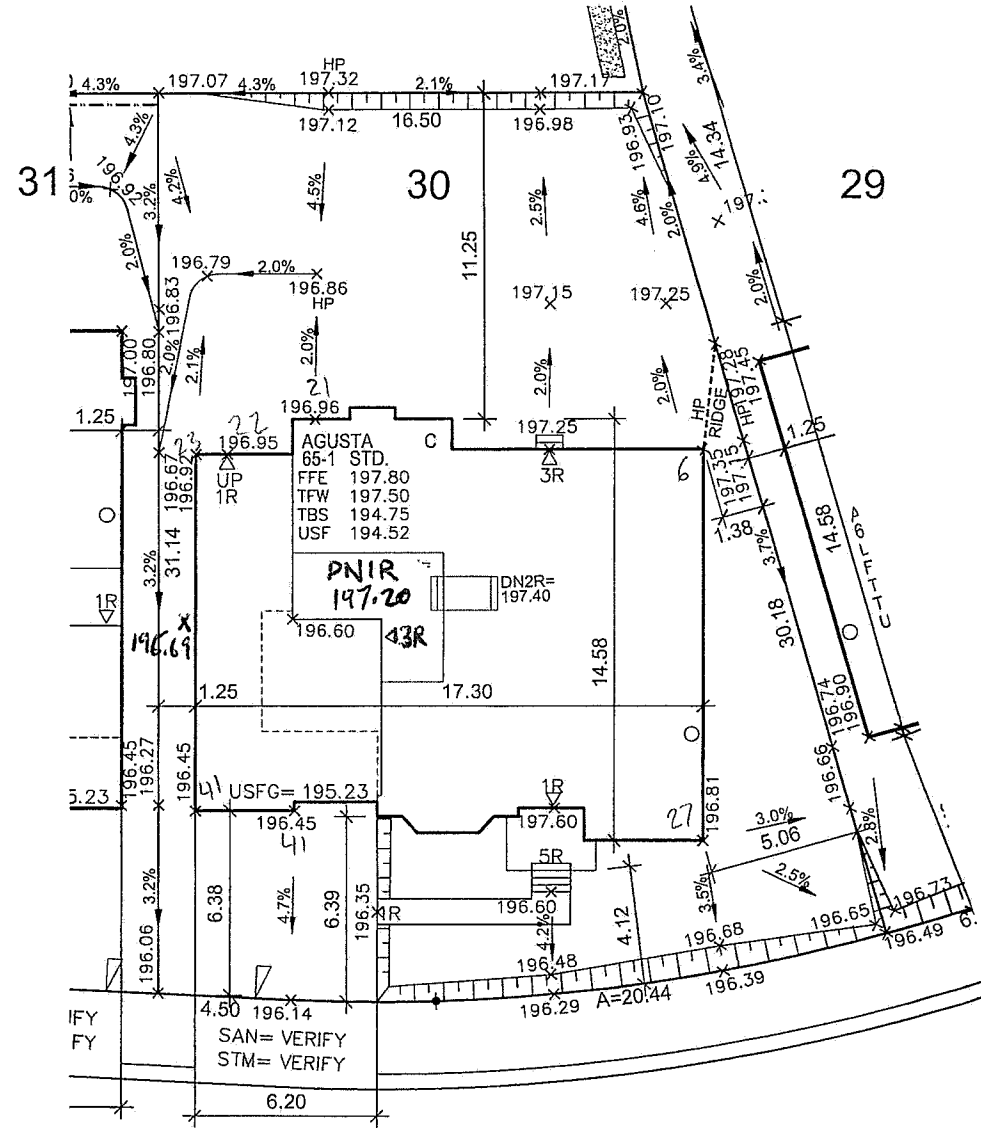

DEGREY DRIVE

NOTES: THE ENGINEERING PLANS HAVE NOT BEEN FINALIZED BY THE CITY AND ARE SUBJECT TO CHANGE.

SANITARY AND STORM INVERTS ARE NOT AVAILABLE AT THE TIME OF SITING; BUILDER TO VERIFY ELEVATIONS OF SANITARY AND STORM LATERALS IN RELATION TO BASEMENT USF ELEVATIONS FOR COMPLIANCE WITH MUNICIPAL STANDARDS PRIOR TO EXCAVATION.