



LORMEL DEVELOPMENTS (BRADFORD) LTD.
PURCHASER EXTRAS

LOT # 108 P.E #003 — Model - KIMBERLEY - 3020

Attention Trades...

The following items below are Purchaser Extras, please make sure that they are done on time and properly complete. Any outstanding items will be Back Charged. If you have any questions please call Roberto Ruiz. Make sure that you review ALL of the items on the Purchaser Extras.


Please be advised that Purchase Orders will come at a later date.

*****Also, it is very important to speak to Roberto Ruiz before starting on site ****


TRADE:		ITEMS TO BE COMPLETED	
Internazionale Electric	#1, #2, #3		
Kingswood	#1		
Medi Group	#4		

Date: Mar.-08-2021
From: Lormel Homes
Site Clerk: Jai Fitzgerald
Site Tel: 905-775-3633
Site Fax: 905-775-9083


NOTE: If more information is needed please call Roberto Ruiz cell-416-688-9324
If more information needed on quotes or changes, please call Zachary 905-832-2023 ext. 224

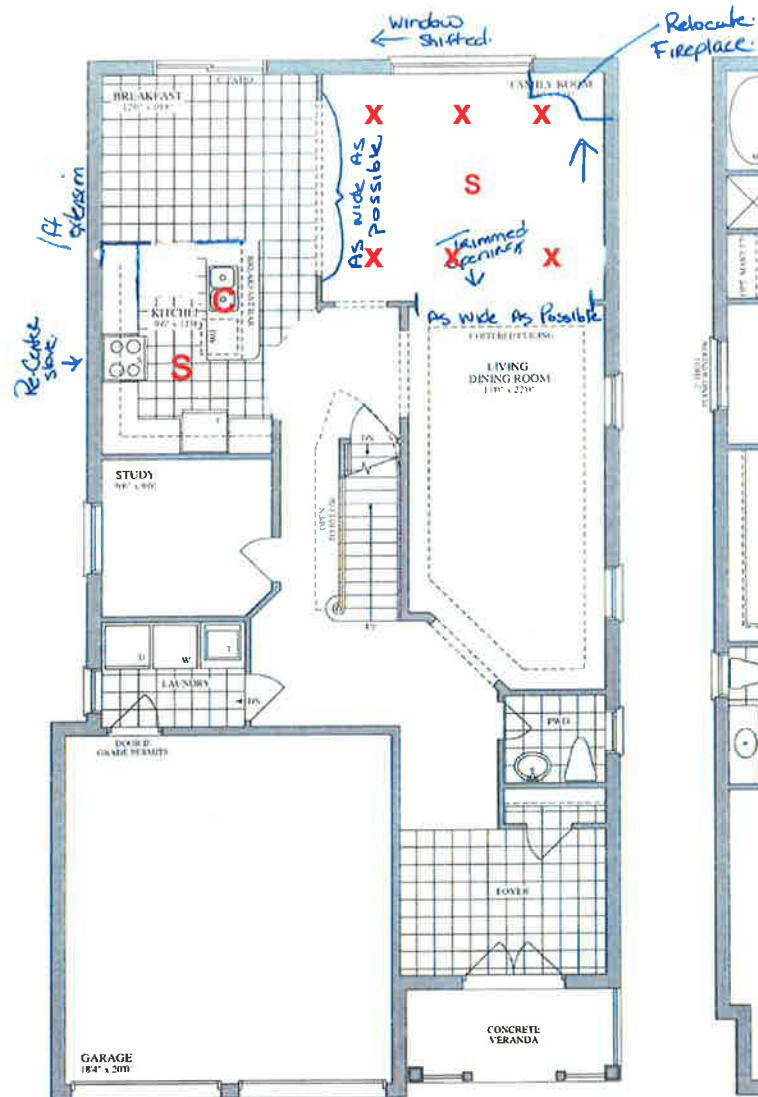


FIRST FLOOR
ELEVATION A, C

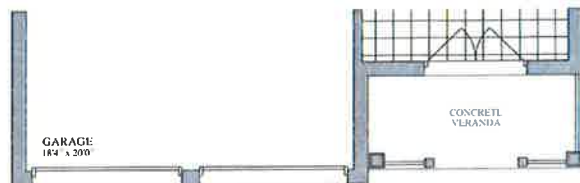


FIRST FLOOR
ELEVATION B

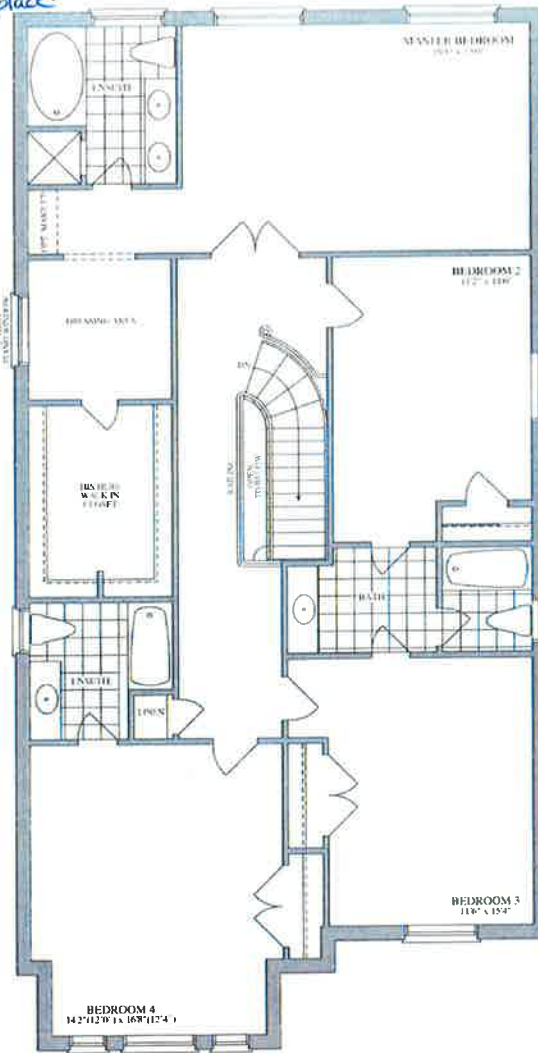

SECOND FLOOR
ELEVATION A

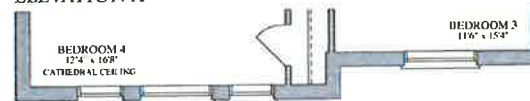


SECOND FLOOR
ELEVATION B

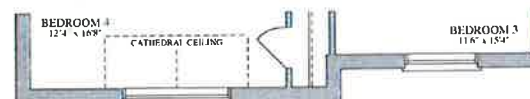

SECOND FLOOR
ELEVATION C

X-POTLIGHTS
S - STANDARD
C-CAPPED LIGHT

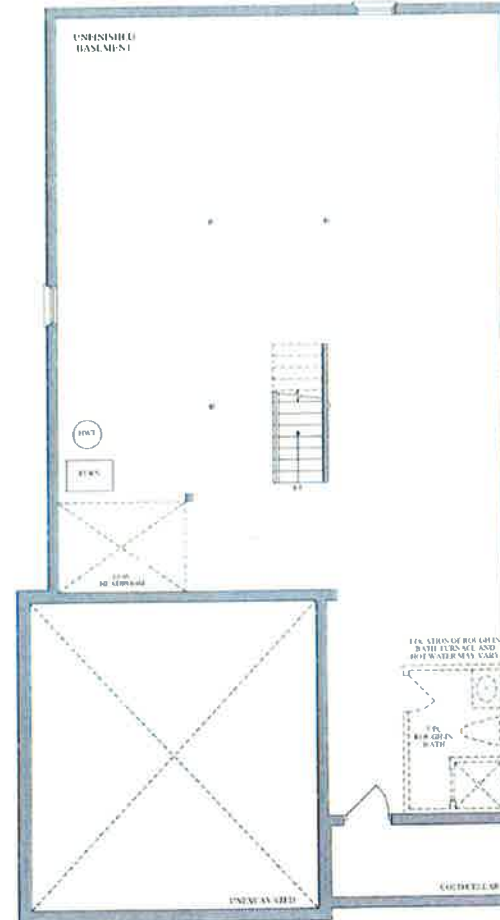

BASEMENT
ELEVATION A, B, C

LOT 108, PHASE 3, BRADFORD
PR003

38

The
KIMBERLEY

ELEVATION A ▲ 3,020 SQ. FT.

ELEVATION B ▲ 3,020 SQ. FT.

ADD STONE HERE THIS SIDE BRICK ✓

ELEVATION C ▲ 3,020 SQ. FT.

DONE

Lornel
HOMES

Plans and specifications are subject to change without notice. E & O. E. Actual visible floor space may vary from the stated floor area. All renderings are artist's concept.