



HORIZON

A NEW LANDSCAPE FOR LIVING


CABLE / TELEPHONE / SMART WIRE LOCATIONS

LOT NUMBER/PHASE:	LOT 010 PH3
PURCHASER:	Talat Rehan
DATE RECEIVED FROM PURCHASER:	May 28, 2020
REVIEWED BY:	Merlina/Naty


For office use only:

Copy sent to site:	
Copy sent to Altronic	
NOTES:	


a. a. site

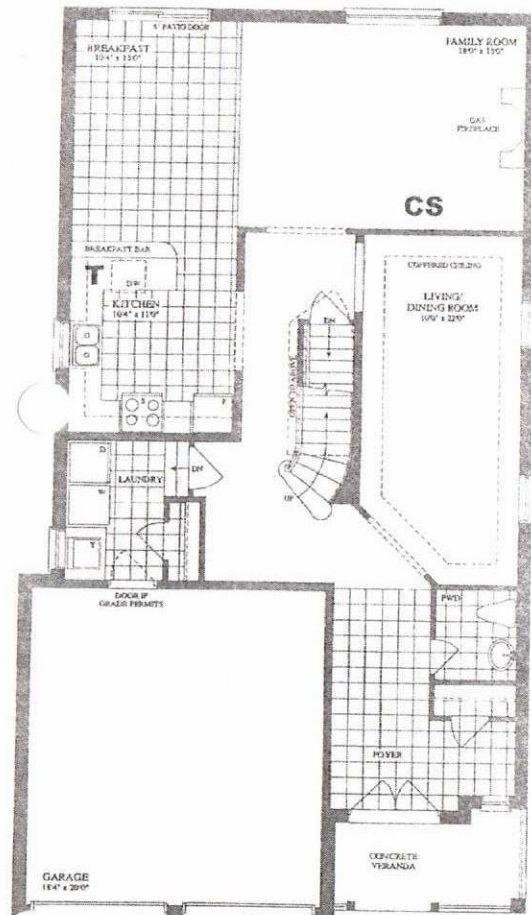


FIRST FLOOR ELEVATION A, C

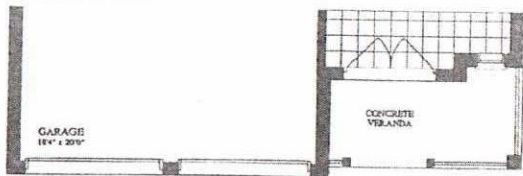


FIRST FLOOR ELEVATION B

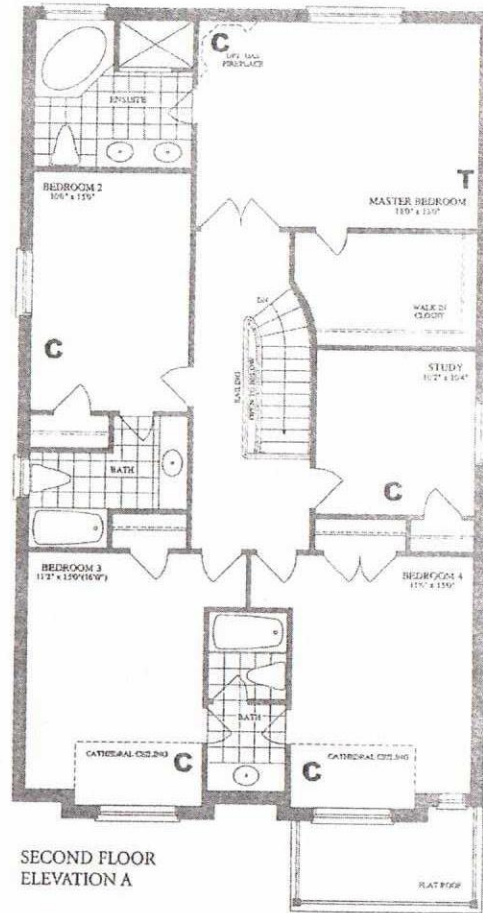

SECOND FLOOR ELEVATION A

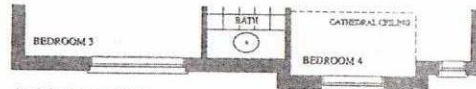


SECOND FLOOR ELEVATION B

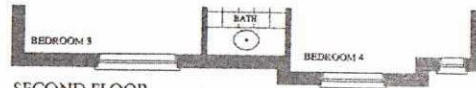

SECOND FLOOR ELEVATION C

Lot #: 10

C = CABLE R/I
T = TELEPHONE R/I
S = SMARTWIRE R/I

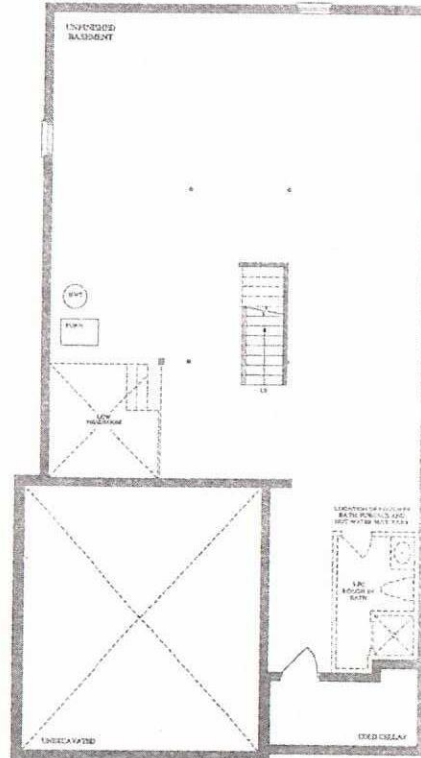

BASEMENT ELEVATION A, B, C

Purchaser: Talat Rehman

Purchaser: _____

Date: May 28, 2020

The ROSEMOUNT



ELEVATION A 2,800 SQ. FT.



ELEVATION B 2,800 SQ. FT.



ELEVATION C 2,800 SQ. FT.

Journal

Plans and specifications are subject to change without notice. E & O. E. Actual usable floor space may vary from the stated floor area. All dimensions are what is shown.