

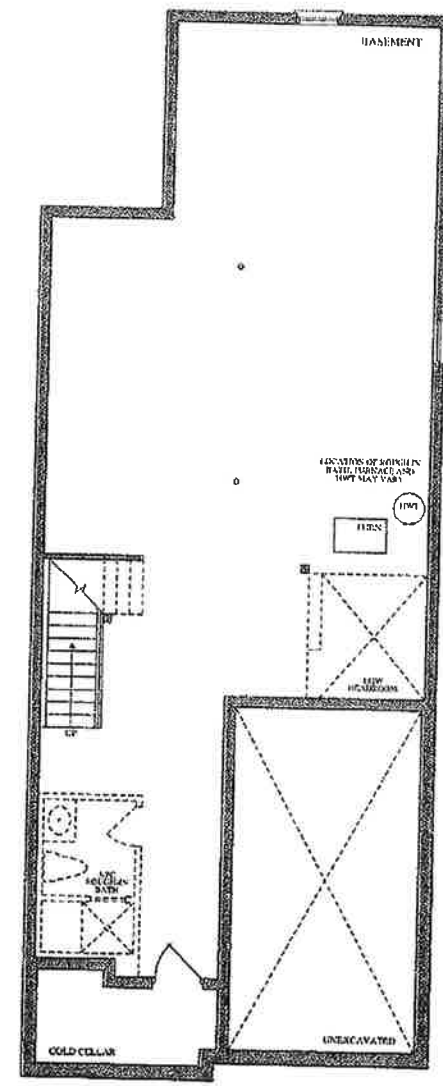


LOT 115, PH 3, BRADFORD.

PE 004 Sketch.

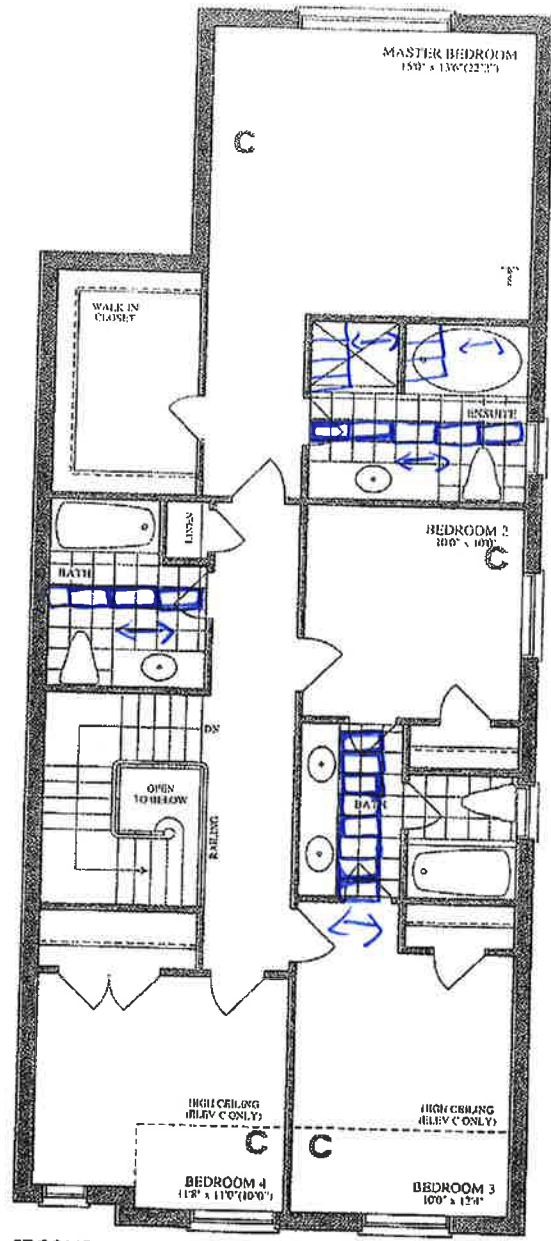

The ASHBURY

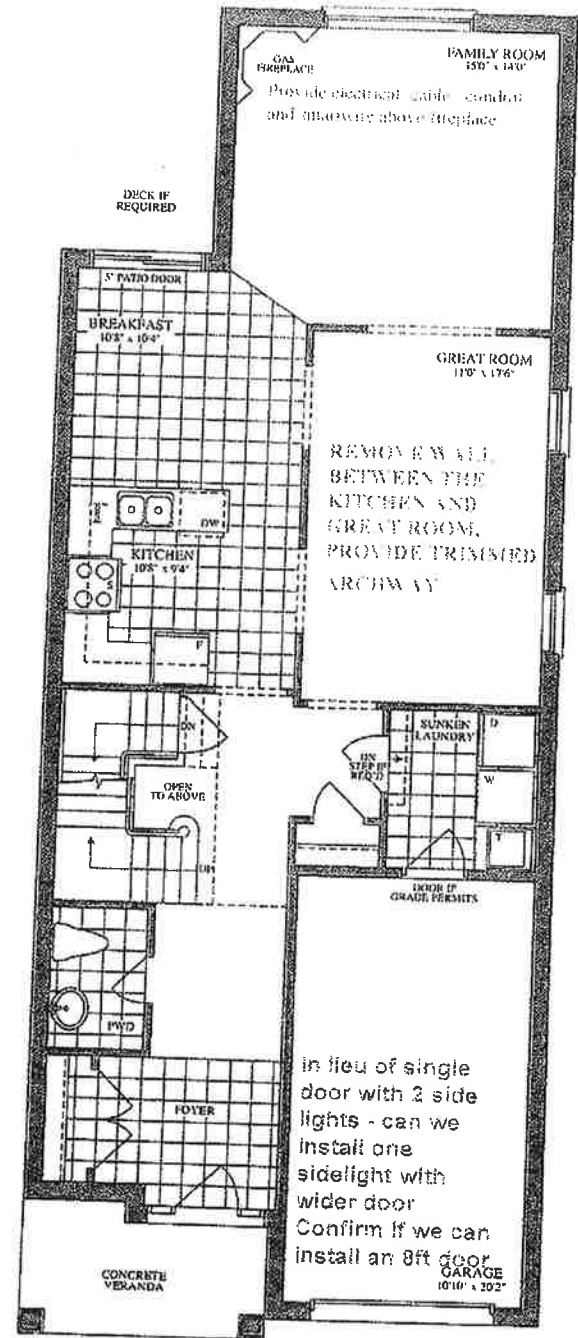

ELEVATION A 2,350 SQ. FT.



ELEVATION B 2,350 SQ. FT.



ELEVATION C 2,350 SQ. FT.

Lorne
HOMES

© 2004 Lorne Homes. All rights reserved. No part of this publication may be reproduced without prior written permission from Lorne Homes. All other trademarks are the property of their respective owners.