


ASSOCIATION OF ONTARIO
LAND SURVEYORS
PLAN SUBMISSION FORM
2140750


THIS PLAN IS NOT VALID
UNLESS IT IS AN EMBOSSED
ORIGINAL COPY
ISSUED BY THE SURVEYOR
In accordance with
Regulation 1026, Section 29(3).

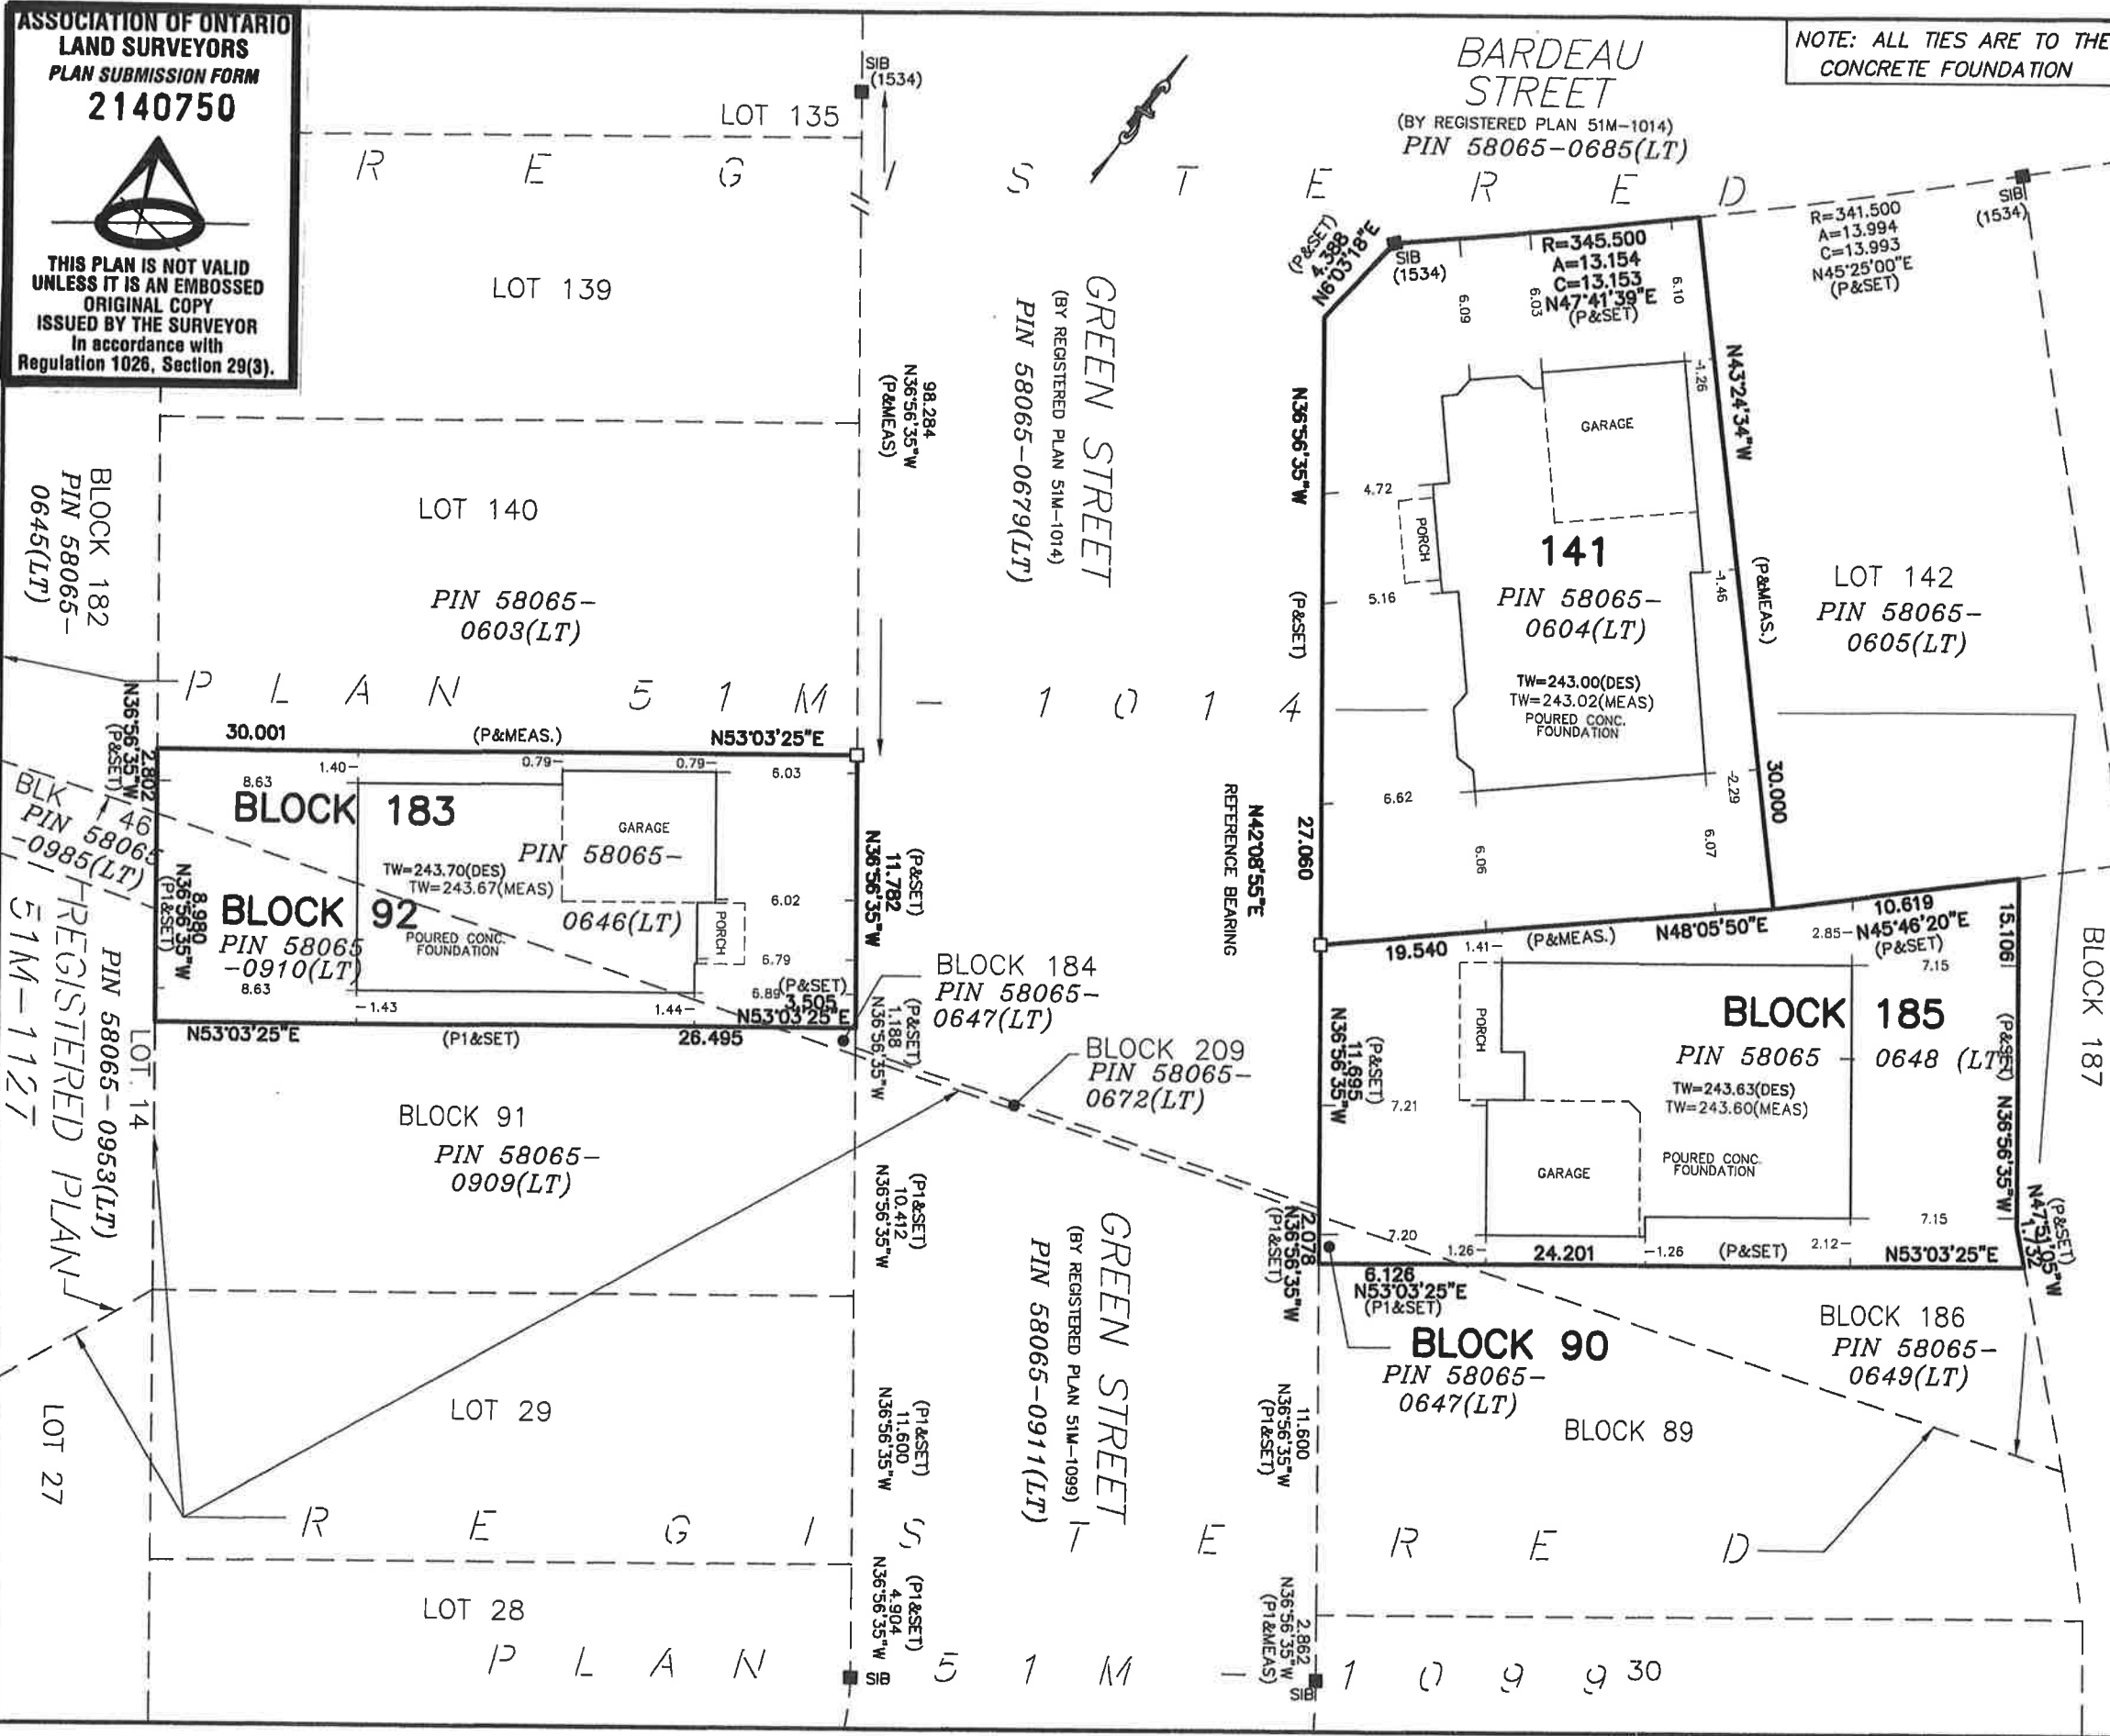

NOTE: ALL TIES ARE TO THE
CONCRETE FOUNDATION

SURVEYOR'S REAL PROPERTY REPORT

PART 1:
PLAN OF
LOT 141, BLOCKS 183 AND 185
REGISTERED PLAN 51M-1014
AND BLOCKS 90 AND 92
REGISTERED PLAN 51M-1099
TOWN OF INNISFIL
COUNTY OF SIMCOE

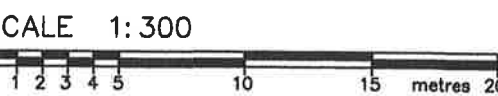

2021 © HUNT SURVEYS INC.

PART 2: THIS REPORT WAS PREPARED FOR
LORMEL HOMES.

TITLE SEARCH INDICATES THE FOLLOWING:
NO REGISTERED EASEMENTS OR RIGHTS-OF-WAY

METRIC: DISTANCES SHOWN ON THIS PLAN ARE IN
METRES AND CAN BE CONVERTED TO
FEET BY DIVIDING BY 0.3048

LEGEND		
■	DENOTES	SURVEY MONUMENT FOUND
□	"	SURVEY MONUMENT PLANTED
SIB	"	STANDARD IRON BAR
IB	"	IRON BAR
P	"	REGISTERED PLAN 51M-1014
P1	"	REGISTERED PLAN 51M-1099
(1534)	"	DOUGLAS E. HUNT O.L.S.

BEARINGS: BEARINGS ARE ASTRONOMIC AND ARE
REFERRED TO THE WESTERNLY LIMIT OF GREEN STREET, AS
SHOWN ON PLAN 51M-1014 HAVING A BEARING OF N36°56'35"E.

SURVEYOR'S CERTIFICATE
I CERTIFY THAT:
1. This survey and plan are correct and in accordance
with the Surveys Act, the Surveyors Act, the Land Titles
Act and the regulations made under them.
2. The survey was completed on November 1, 2021.
DATE: November 24, 2021 *Douglas E. Hunt*
Douglas E. Hunt
ONTARIO LAND SURVEYOR

HUNT SURVEYS INC.
ONTARIO LAND SURVEYORS

1234 REID STREET, UNIT 7/9A, RICHMOND HILL, ON.
L4B 2P2. Tel: (905) 764-8759 Fax: (905) 764-6812
Email: huntsurveys@rogers.com

SURVEY BY: E.S.	CHECKED BY: D.E.H	FILE: 65268 srpr_66 to 68, 70.dwg
CAD : O.C.	LOTS 66-68, 70	PROJECT #: 065268 Ph 2 srpr