



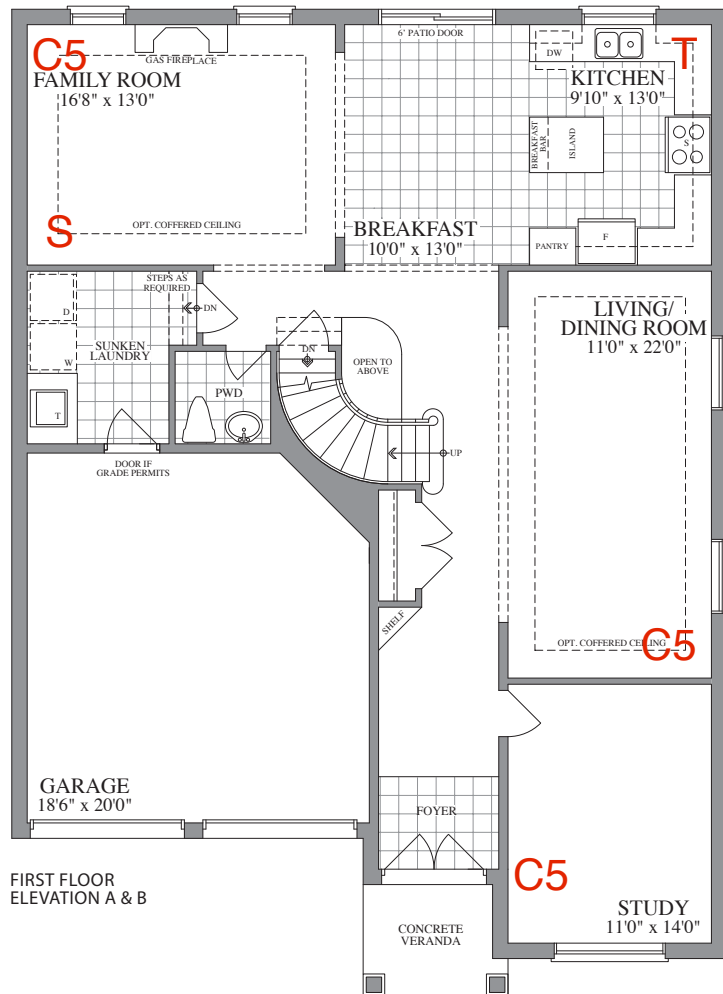


FIRST FLOOR
ELEVATION A & B

Please indicate the location of the rough-ins on your plan


Description	Symbol on Sketch	Standard Locations
Cable (Rough-in)	C	Family room Or Great Room, all bedrooms, Study/Den/Computer, (as per model)
Cat5	C5	A Cat5 wire can replace the rough-in cable at no additional cost.
Cat6	C6	Upgrade - \$50 per location
Telephone (Rough-in)	T	Kitchen and Primary Ensuite
Smart-Wire (Cat5)	S	Can be installed a Purchaser's desired location

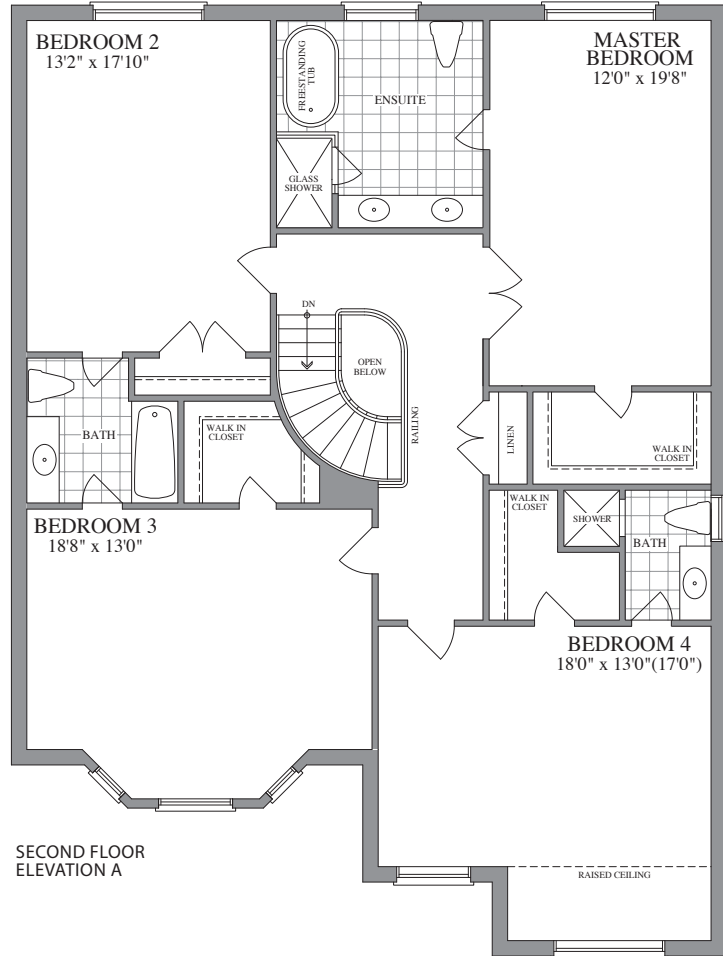

SECOND FLOOR
ELEVATION A

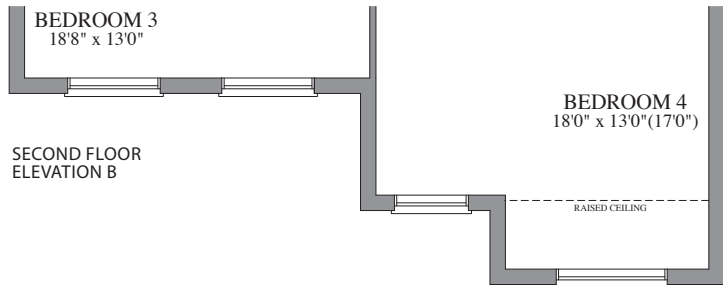

SECOND FLOOR
ELEVATION B

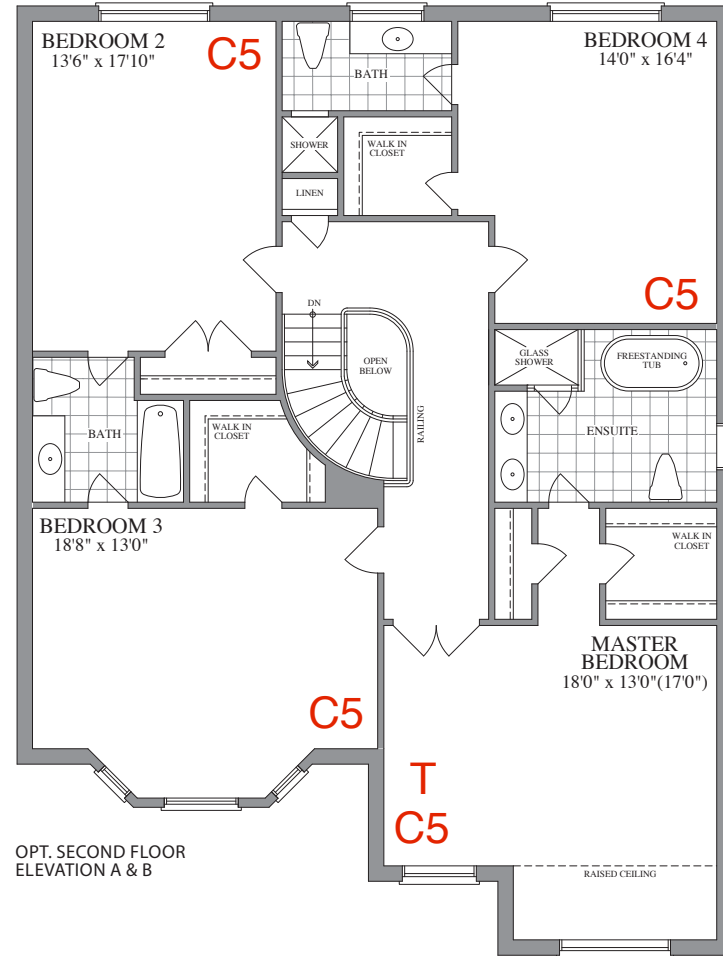


OPT. SECOND FLOOR
ELEVATION A & B

LOT # 2-24

PURCHASER: *hp kel*

PURCAHSER:

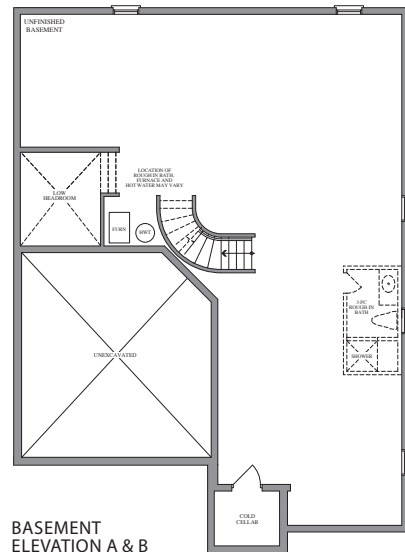

BASEMENT
ELEVATION A & B