

47'
DESIGNS

The Kahshe / Elev. A & B
3000 sq.ft.



First Floor Elevation A & B

1/10/15/Conduct

Best Place For Pantry 24" deep by 36" wide

OTR

Charge to shower

FRIDGE Enclosure

ADD Shower Niche


ADD Shower Niche

ADD Shower Niche

INCREASE Shower


GLASS DOOR ONLY

INCREASE Garage height to 8ft.

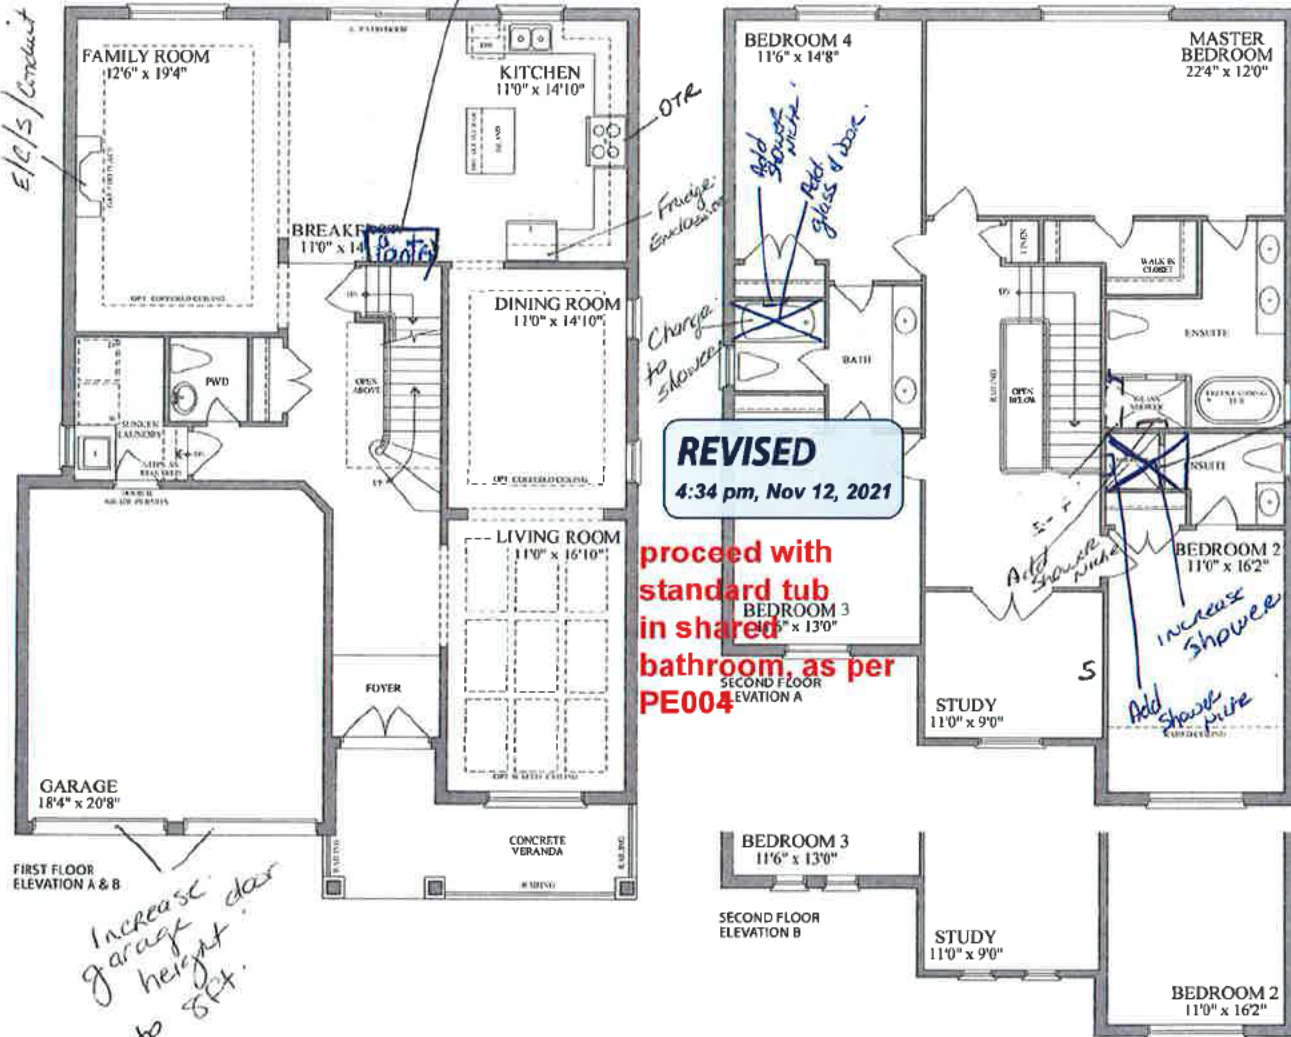

REVISED
4:34 pm, Nov 12, 2021


proceed with standard tub in shared bathroom, as per PE004

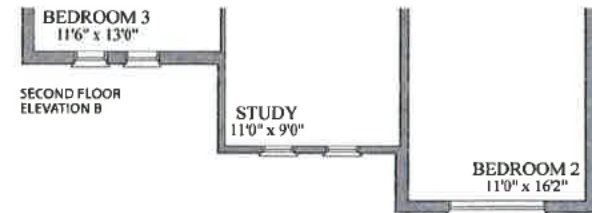

Lot 2-68



**Walk-up Basement

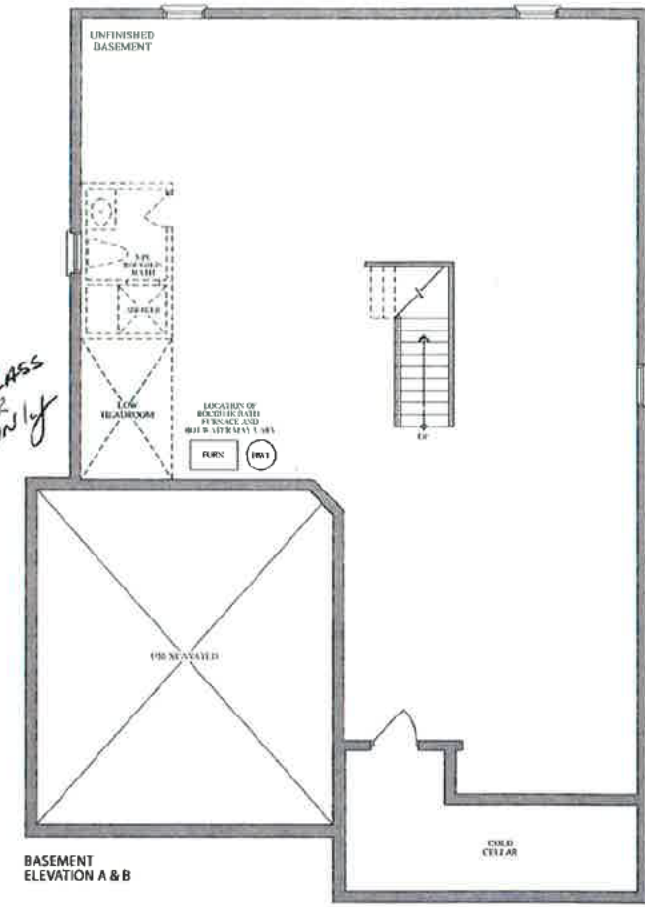

LOT 2-68, PH2, INNISFIL - PE004
(PROCEED WITH STANDARD TUB IN SHARED BATHROOM NICHE AND PLUMBING UPGRADES TO REMAIN)

PURCHASER Kert McKenzie (Nov 12, 2021 16:54 EST)

PURCHASER _____

Plans and specifications are subject to change without notice. E & O E. Actual usable floor space may vary from the stated floor area. All renderings are artist's concept.