


38'
DESIGNS

The Buckhorn / Elev. A & B
1800 sq.ft.

Conduit with electrical and tech cable

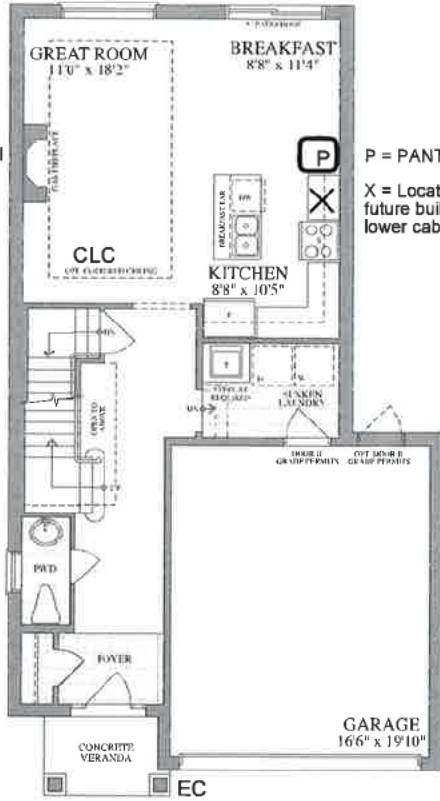

FIRST FLOOR
ELEVATION A & B


P = PANTRY
X = Location for future built-in micro in lower cabinet



SECOND FLOOR
ELEVATION A



SECOND FLOOR
ELEVATION B

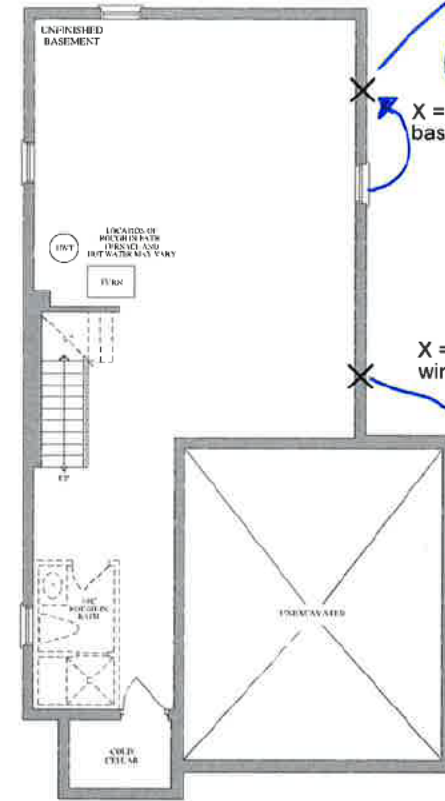

BASEMENT
ELEVATION A & B

Location 4ft FROM REAR WALL



Purchaser's Initial: AL


LOT 5-16, INNISFIL,
SKETCH, PE002



Plans and specifications are subject to change without notice. E. & O. B. Actual available floor space may vary from the stated floor area. All renderings are artist's conceptions.


LOT 5-16, INNISFIL, SKETCH, PE002

REVISIONS	
#	DATE

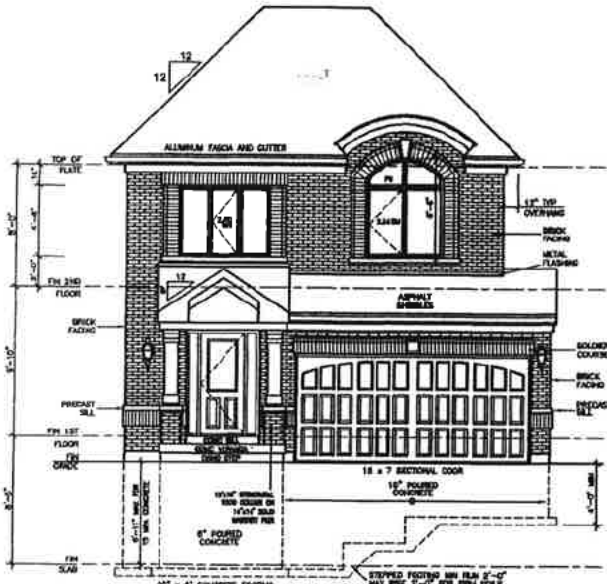

FRONT ELEVATION 'B'


WALLS AND WINDOWS AREA			
ELEVATION	WALL AREA	WINDOW AREA	
FRONT ELEVATION	47.50 SQ M	1.00 SQ M	
RIGHT SIDE ELEVATION	88.10 SQ M	1.00 SQ M	
LEFT SIDE ELEVATION	89.20 SQ M	1.11 SQ M	
REAR ELEVATION	89.20 SQ M	1.11 SQ M	
TOTAL AREA	314.00 SQ M	4.22 SQ M	1.33

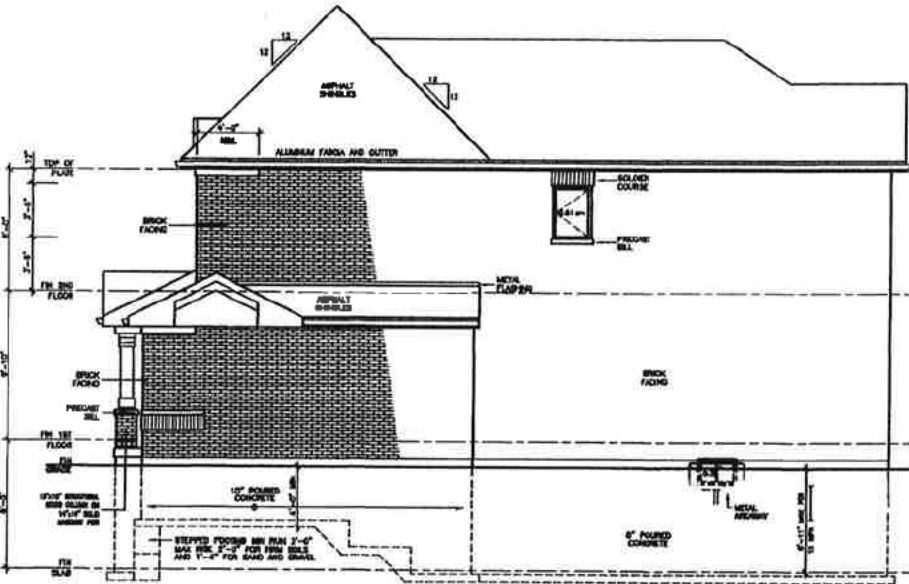


RIGHT SIDE ELEVATION 'B'

ALLOWABLE UNPROTECTED OPENINGS		
LAPSE DISTANCE	2.94 FT	1.00 M
MINIMUM PERCENTAGE	1.00 %	
TOTAL WALL AREA	814.00 SF	84.87 SQ M
ALLOWABLE OPENINGS	8.14 SF	0.80 SQ M
ACTUAL OPENINGS	8.08 SF	0.80 SQ M

X = Location for gas line
Purchaser's Initial: _____

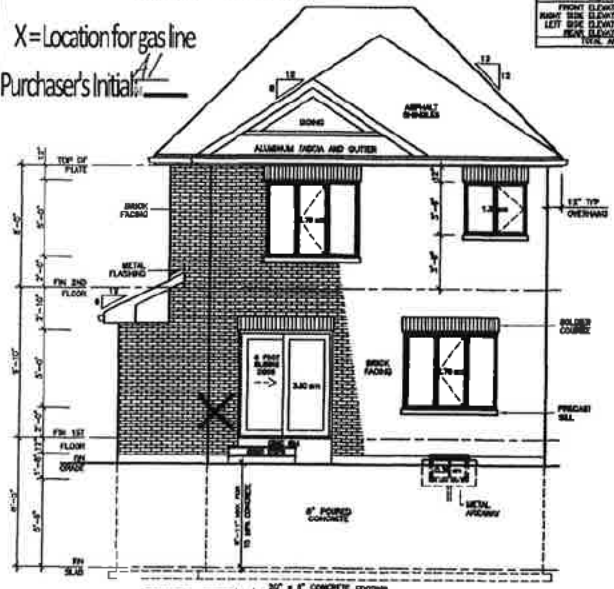

REAR ELEVATION 'B'

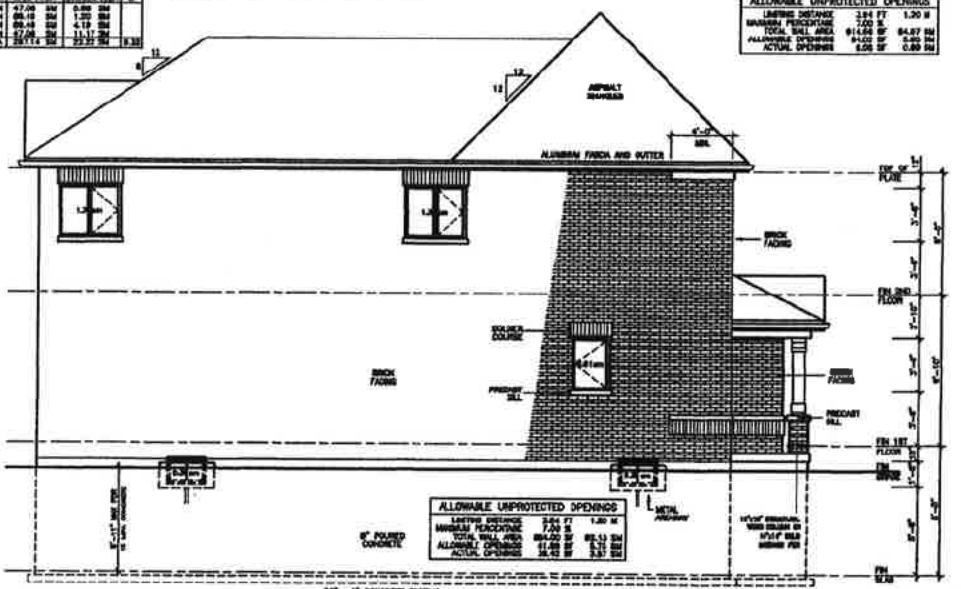

LEFT SIDE ELEVATION 'B'

ALLOWABLE UNPROTECTED OPENINGS		
LAPSE DISTANCE	2.94 FT	1.00 M
MINIMUM PERCENTAGE	1.00 %	
TOTAL WALL AREA	814.00 SF	84.87 SQ M
ALLOWABLE OPENINGS	8.14 SF	0.80 SQ M
ACTUAL OPENINGS	8.08 SF	0.80 SQ M

Lornel
HOMES

ORDINARY ASSOCIATION
OF
ARCHITECTS
187 ANNE STREET
TORONTO, ONT. M5S 1A7
CANADA

ARCHITECTURAL
DESIGN INC.

BUCKHORN
MODEL 1800

38' LOT