




The Kahshe / Elev. A & B
3000 sq.ft.

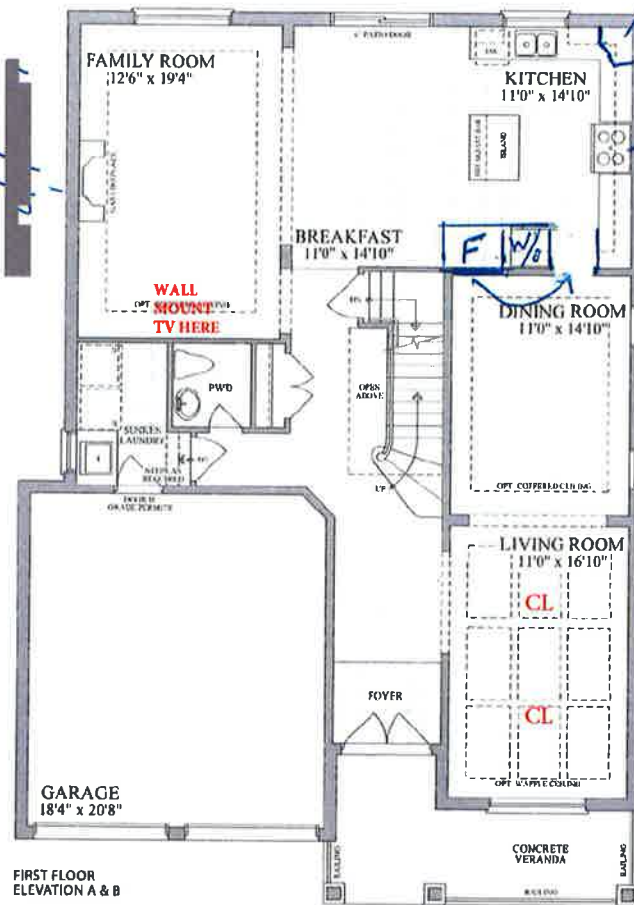

corner cabinet

Gas Line

change to Shower

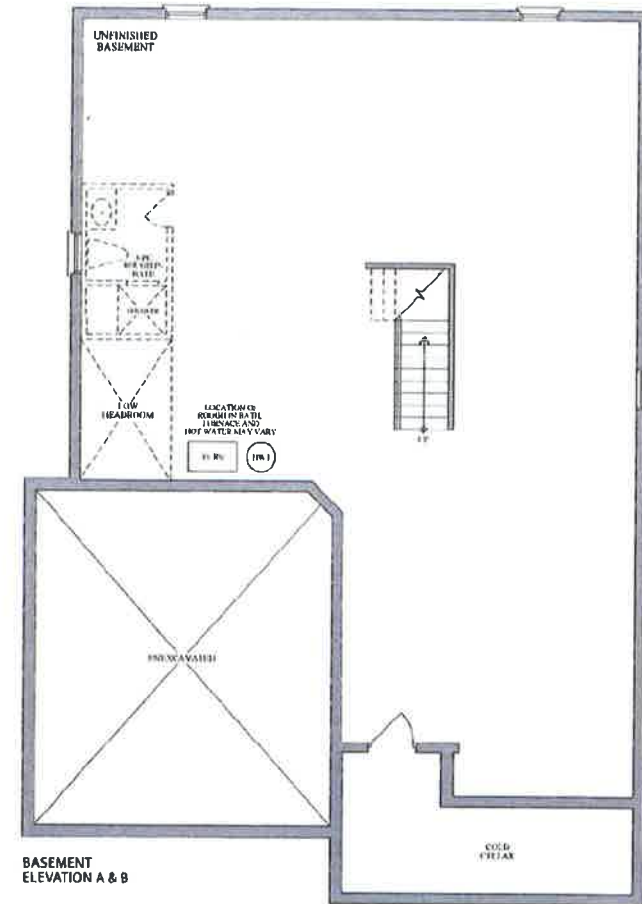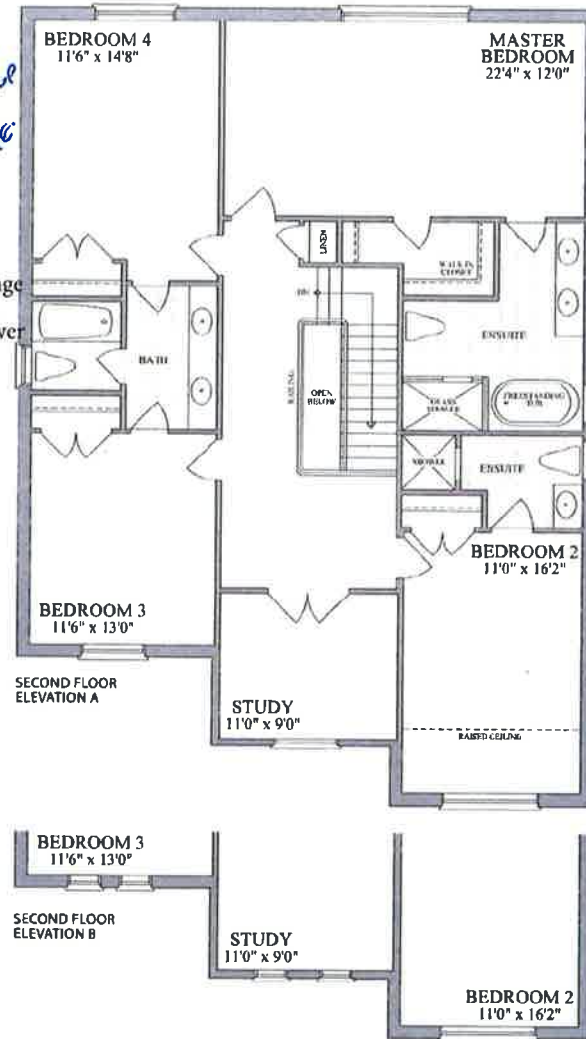

LOT 5-22, PH5, INNISFIL, PE002

PURCHASER: _____

PURCHASER: Rajiv Punj
Rajiv Punj (Dec 2, 2021 20:51 EST)