
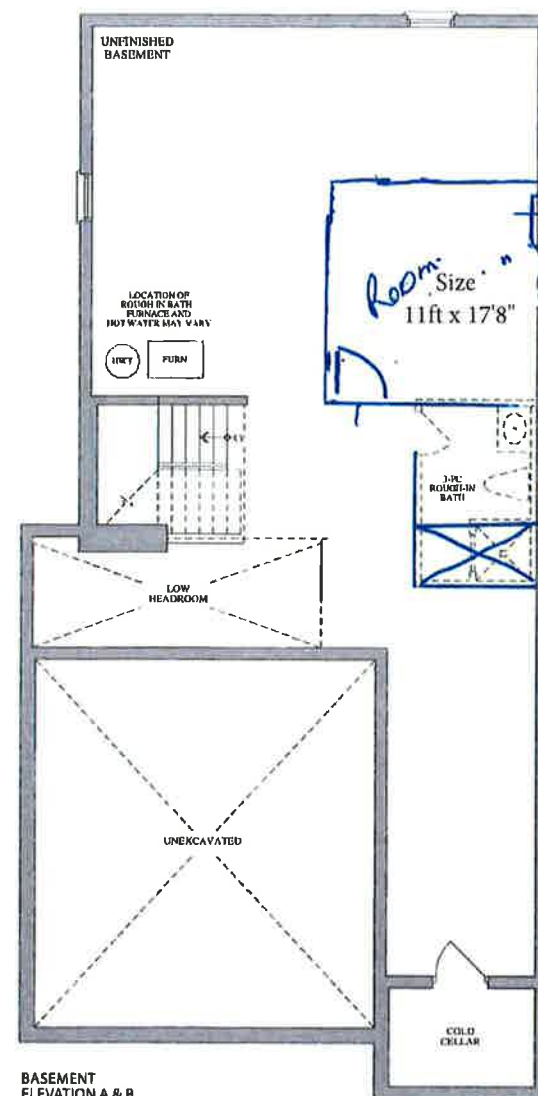
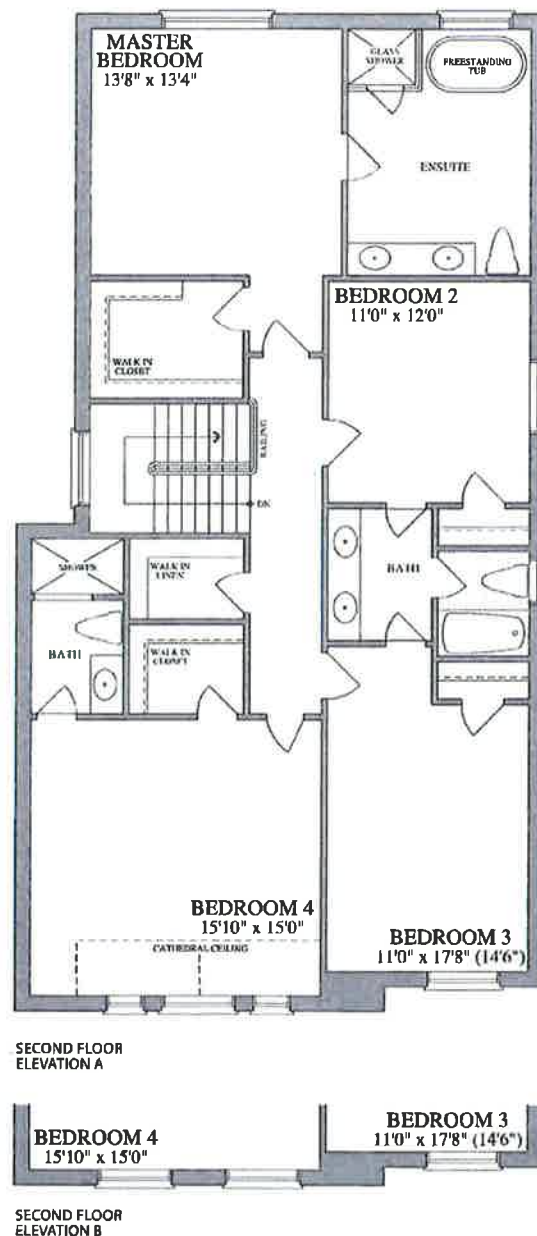


38'
DESIGNS

The Finlay / Elev. A & B
2515 sq.ft.

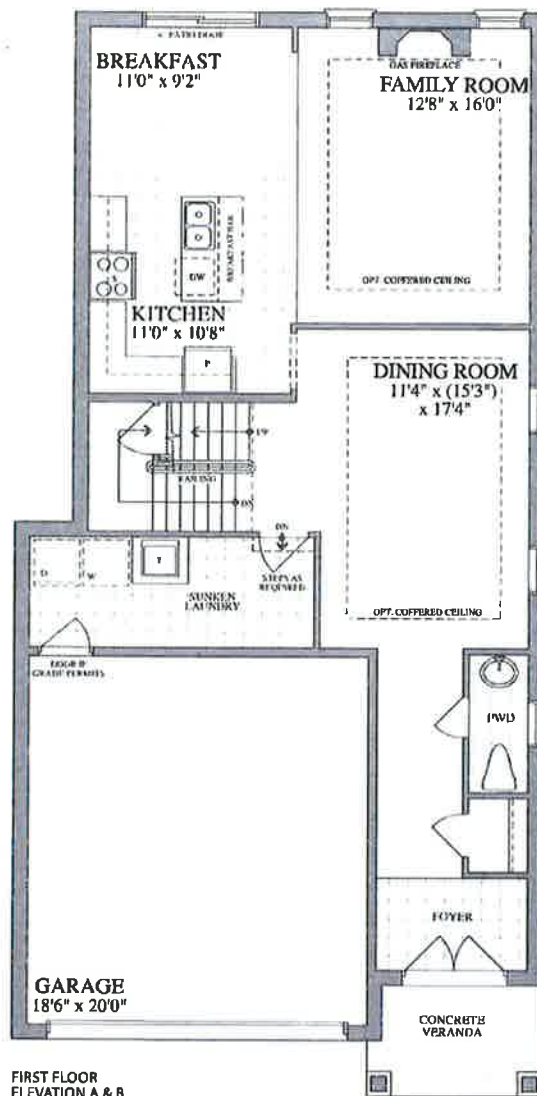

Ensure standard basement window is inside room

Add window

LOT 5-39, PH5, INNISFIL, PE-002, SKETCH

PURCHASER: Qamar Hafeez (Nov 9, 2021 12:57 EST)



Plans and specifications are subject to change without notice. E. & O. E. Actual usable floor space may vary from the stated floor area. All renderings are artist's concept.