




Lot 5-70, PH5, INNISFIL - PE003, SKETCH

PURCHASER: Shikha Prashar (Oct 23, 2021 11:00 EDT)

PURCHASER: _____

38'
DESIGNS

The Temagami / Elev. A & B
3 Car Tandem 3068 sq.ft. - includes 478 sq.ft. of finished area in lower level
2 Car Garage 3350 sq.ft. - includes 760 sq.ft. of finished area in lower level

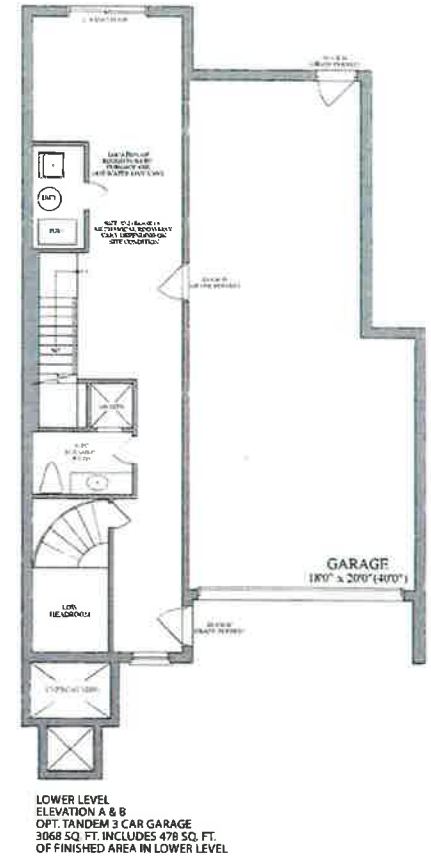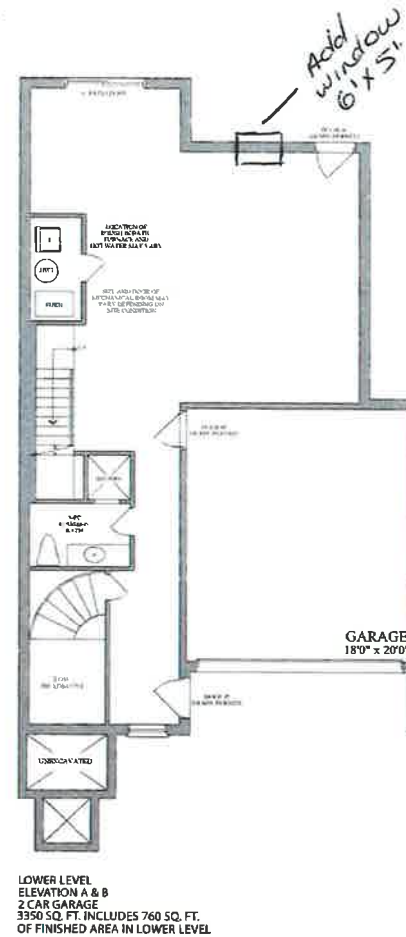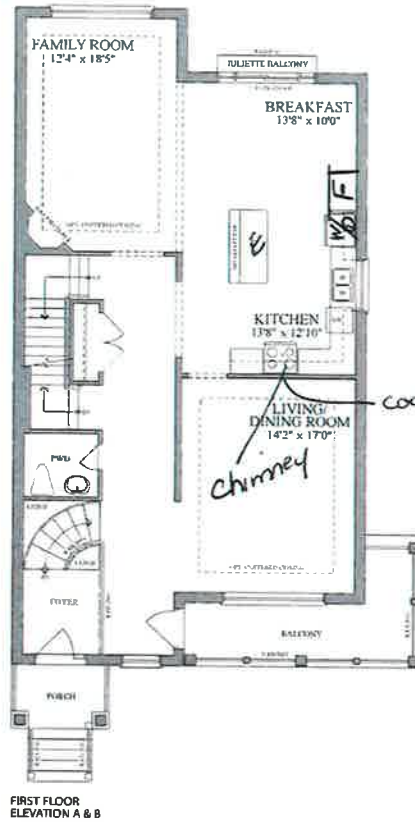

Plans and specifications are subject to change without notice. E. & O. E. Actual results may vary from the sketch. Room names and dimensions are subject to change.