

38'
DESIGNS

The Fraser / Elev. A & B
2250 sq.ft.

Relocate Fridge Space & Store Space
Center vent as much as possible
Relocate Sink & Dishwasher to Island
1 of the receptacles between fridge & store space on its own breaker
* All kitchen receptacles to be installed horizontally & as close to counter as possible.


PANTRY: 36" inches wide by 2ft deep.
w/ Built-in Micro Provision

Provision for future wall mount TV above fireplace.


Capped Light

Standard ceiling light


1 of the receptacles along this wall to be on its own breaker.

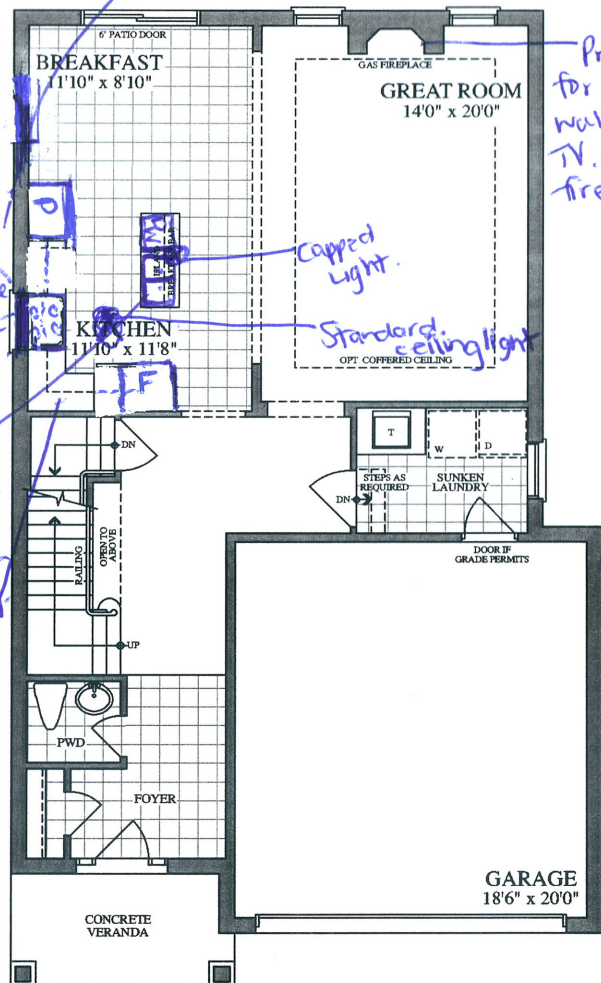

FIRST FLOOR
ELEVATION A & B

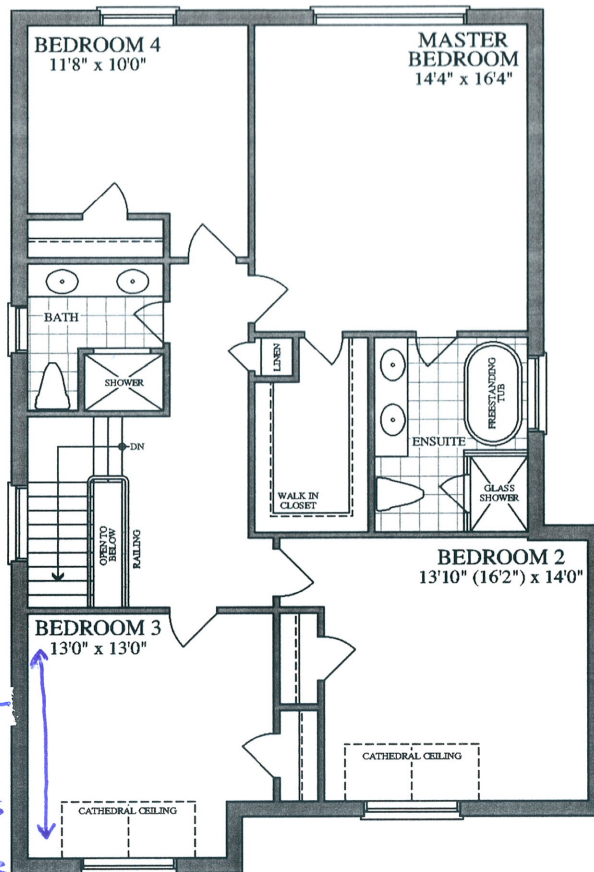


SECOND FLOOR
ELEVATION A

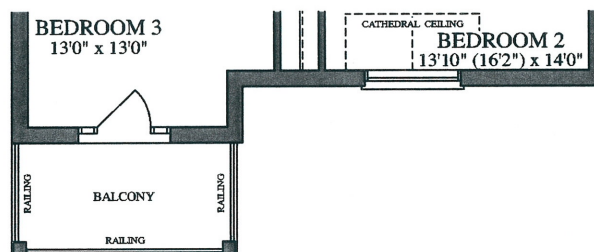

SECOND FLOOR
ELEVATION B

LOT 5-79, INNISFIL

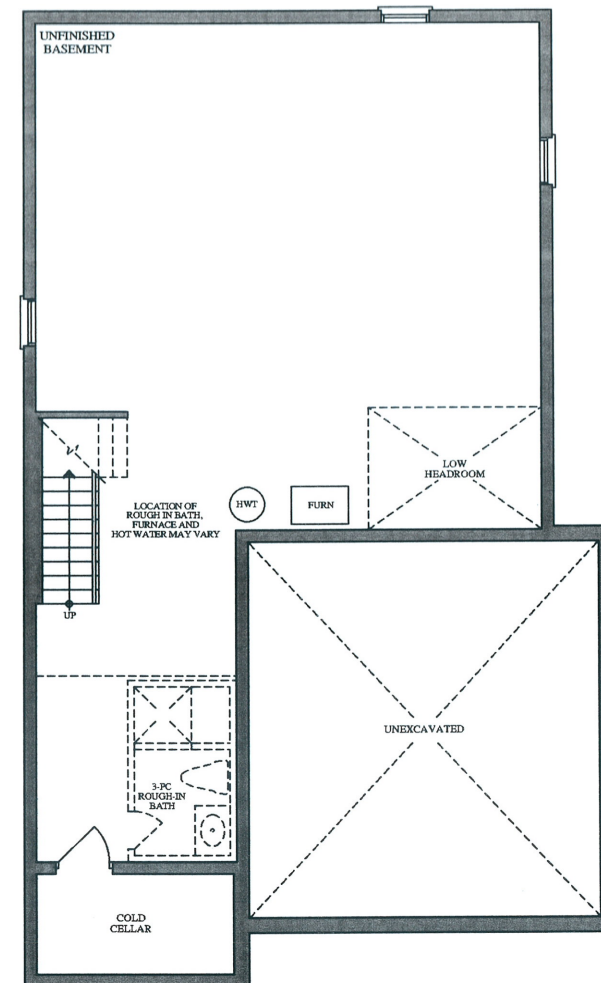

BASEMENT
ELEVATION A & B