



47'
DESIGNS


The Nipissing / Elev. A & B
3210 sq.ft.

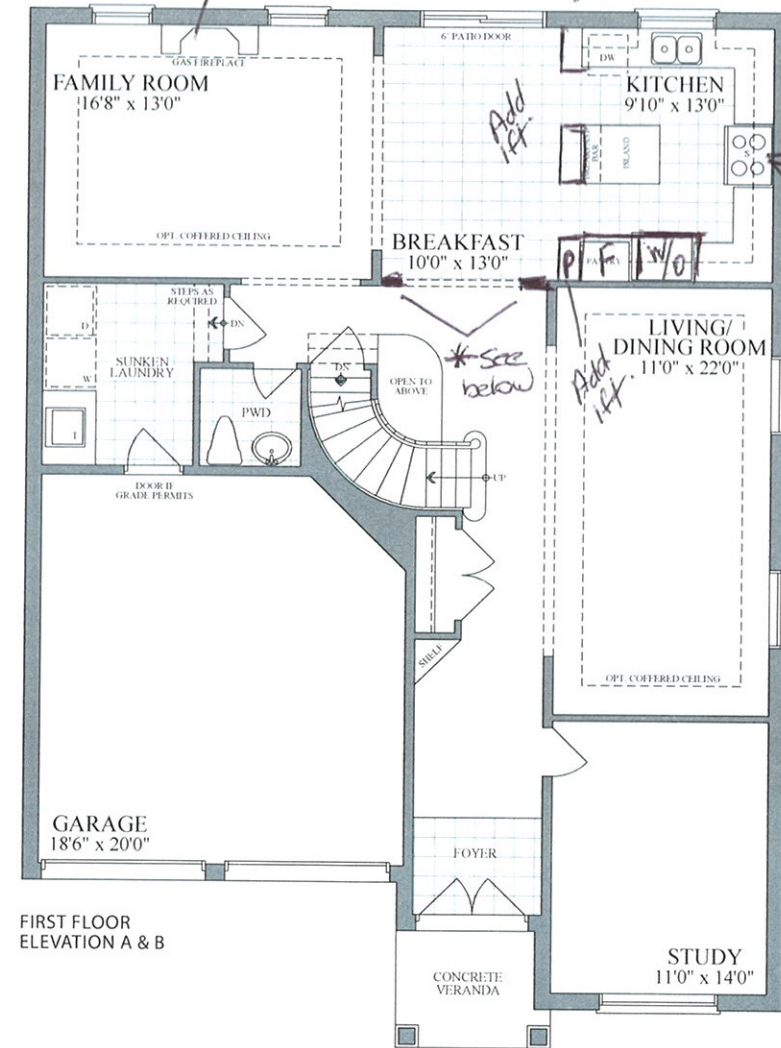


FIRST FLOOR
ELEVATION A & B

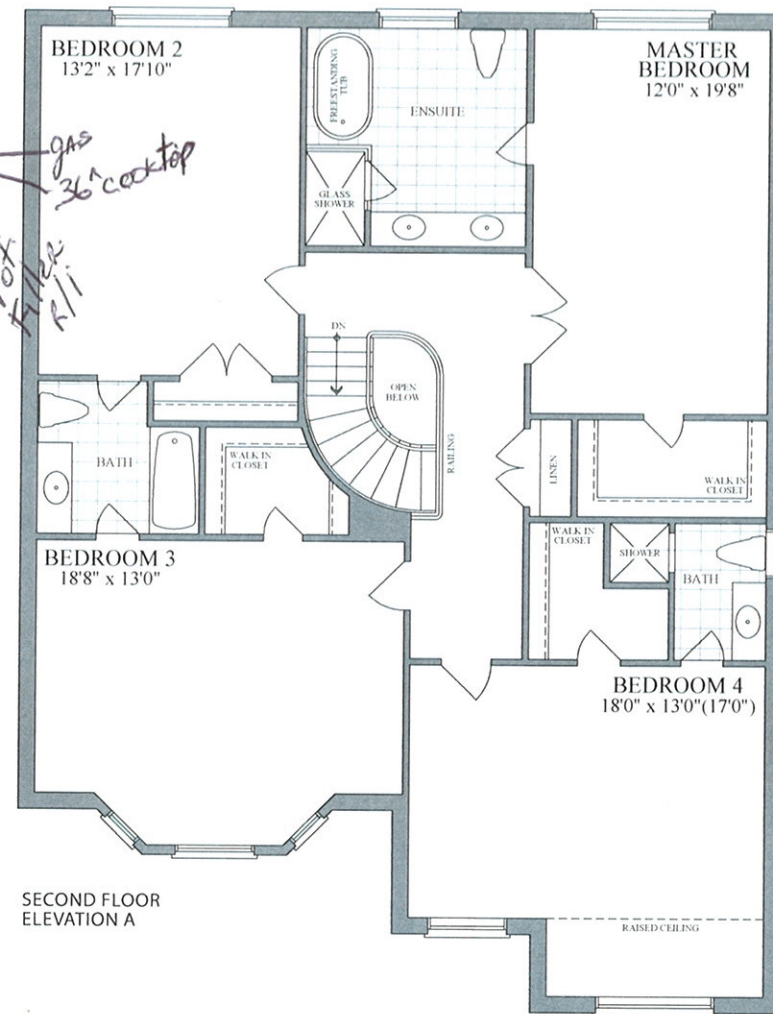

SECOND FLOOR
ELEVATION A

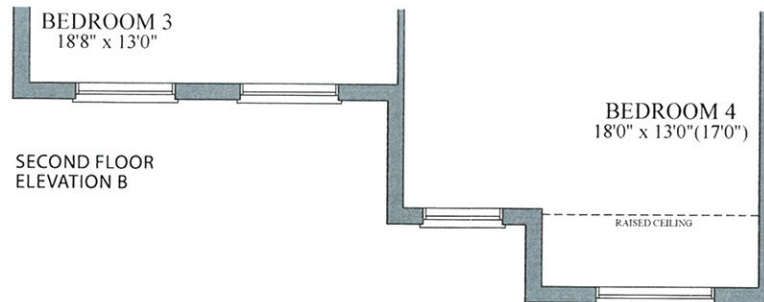


SECOND FLOOR
ELEVATION B

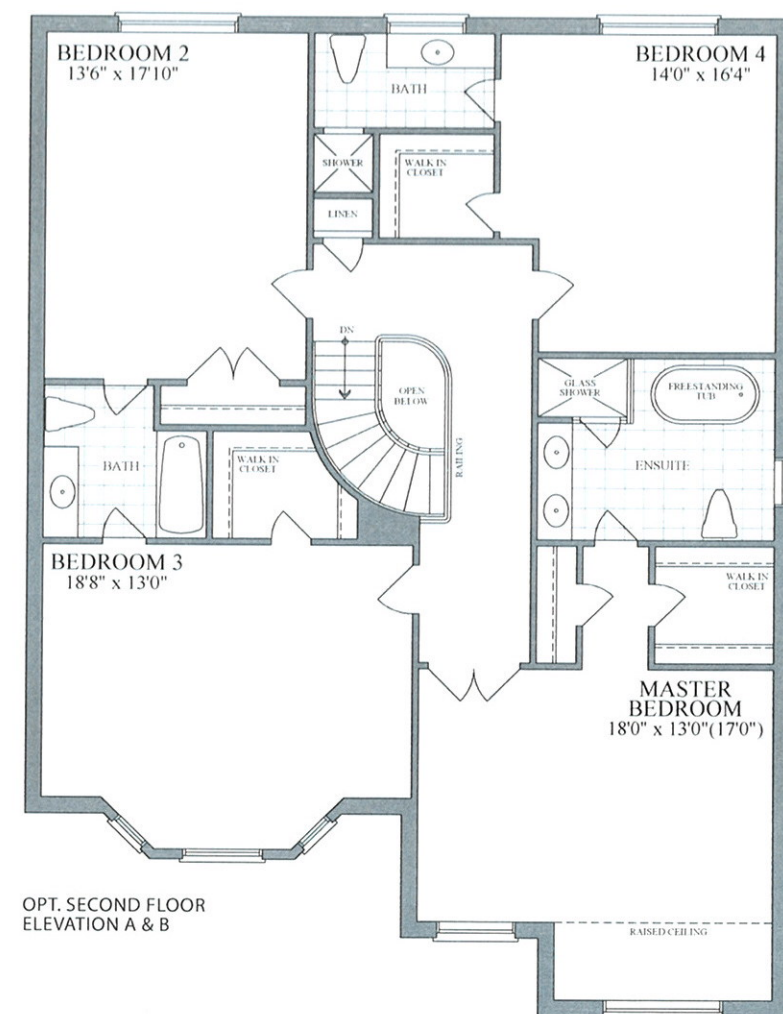

OPT. SECOND FLOOR
ELEVATION A & B

LOT 5-80
PE #002

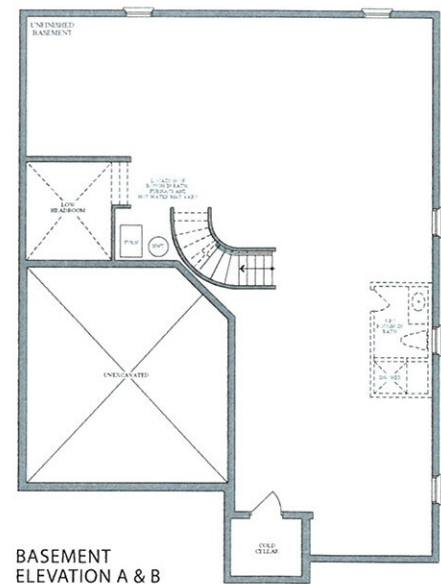

BASEMENT
ELEVATION A & B

* We need to extend this wall so that we can get extra room for the built-in appliances