




LOT 2-62, INWISIL



ADDITIONAL CEILING LIGHT (CENTERED)

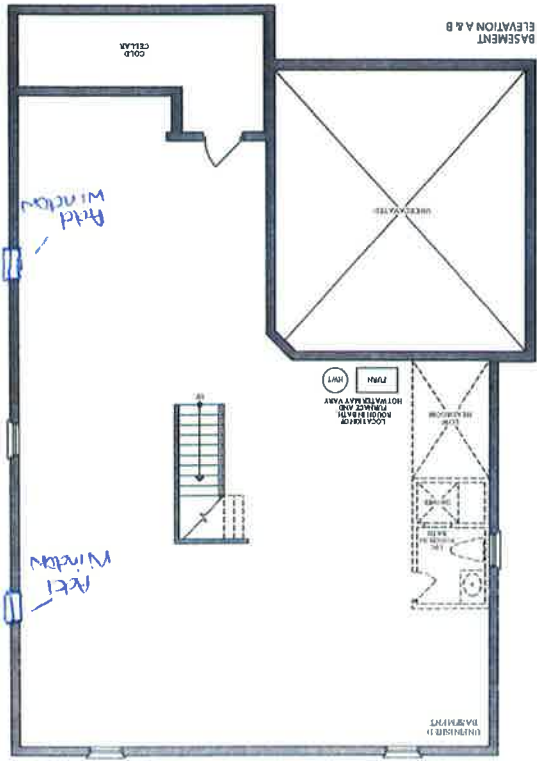

REMOVE CHIMNEY FROM CENTER VENT AS MUCH AS POSSIBLE

SHOWS LOCATION OF THE CHIMNEY

WINDOWN TO BE SHIFTED (NOT CENTERED) BY 3 INCHES WIDE

REMOVE FIREPLACE TO THE CORNER



The Kamshe / Elev. A & B
5000 sq.ft.



Plans and elevations are subject to change without notice. C. & D. L. Architects Inc. 1998 1999 2000 