



AMENDMENT TO AGREEMENT

Type of Agreement: Agreement of Purchase and Sale Dated: October 22, 2021  
Subject Property: LOT # 5-30 INNISFIL  
Between  
PURCHASER(s): Tayyeba Ahsan Butt  
And VENDOR(s): Bellaire Properties Inc.

It is hereby understood and agreed between the undersigned parties hereto that the following changes shall be made to the above-mentioned Agreement, and except for such changes noted below all other terms and conditions in the Agreement shall remain in full force and effect:

DELETE:

LOT # 5-30  
SCHEDULE “E” Site Plan

INSERT:

LOT # 5-12  
SCHEDULE “E” Site Plan

AuthentiSIGN

Tayyeba Butt


11/1/2021 9:17:04 AM EDT

11/01/2021

(Purchaser)(Date)

(Purchaser)(Date)

(Vendor)(Date)

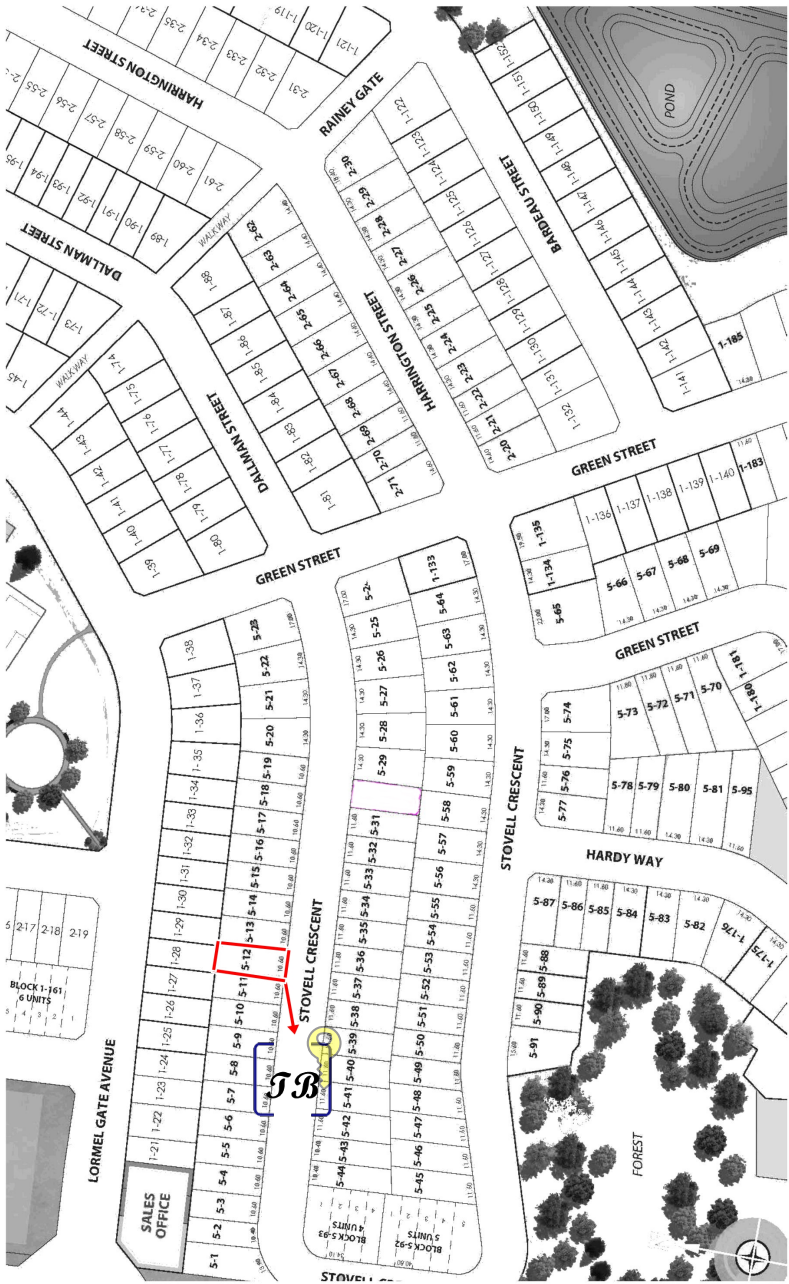

Initials: \_\_\_\_\_

