
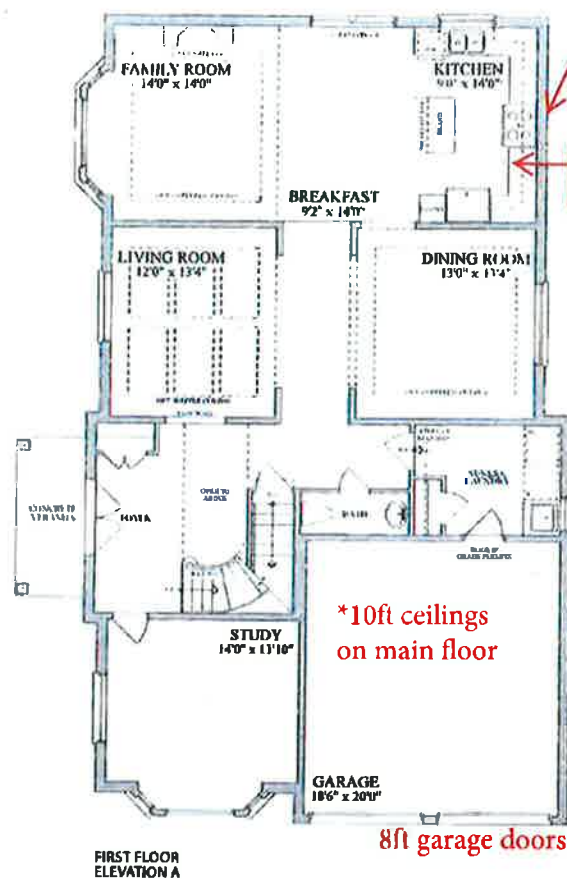




47'
DESIGNS

The madawaska / Elev. A & B
3190 sq.ft.

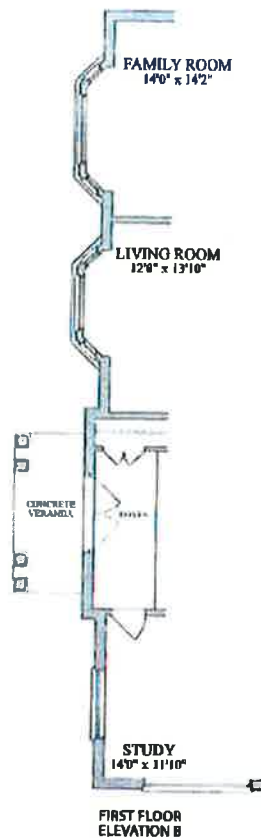

Provision for OTR

Add built-in micro cabinet (base)

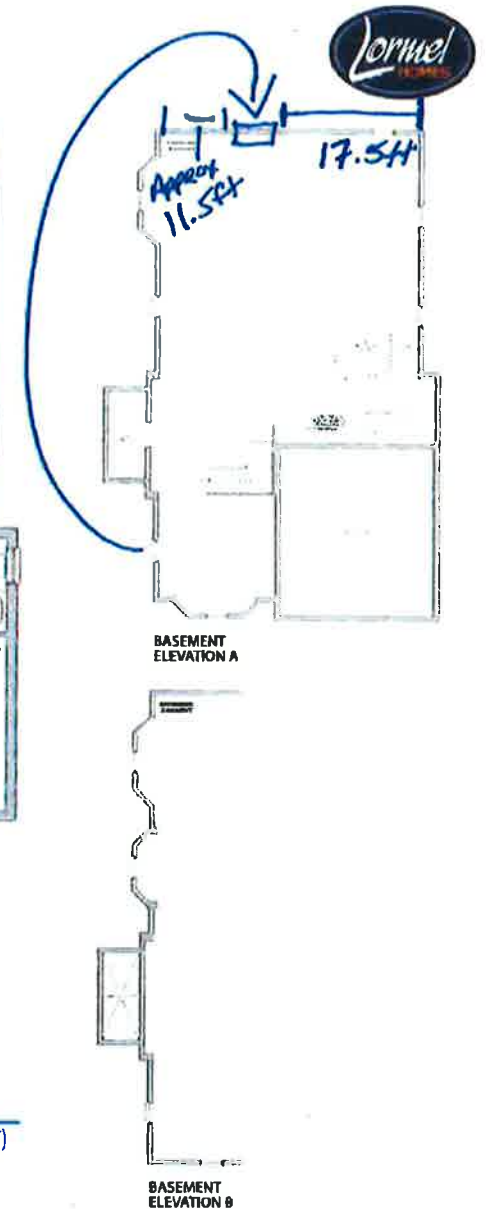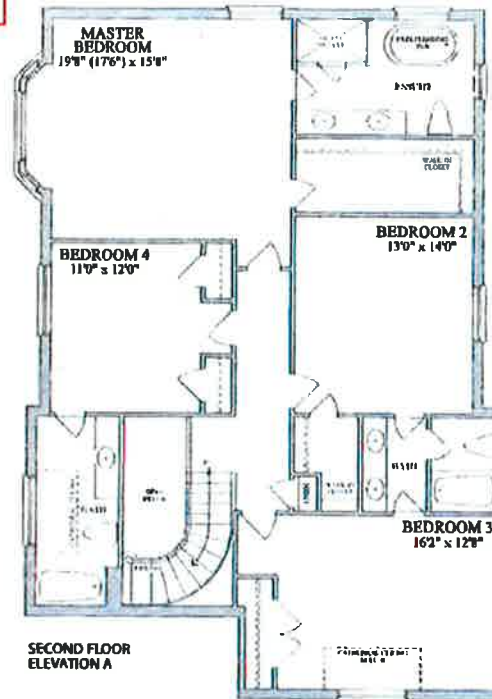

LOT 5-23, PH5, INNISFIL, PE002

PURCHASER: Jeyaseelan Sarwanandam (Dec 10, 2021 13:44 EST)

PURCHASER: _____



Plans and specifications are subject to change without notice. E & O. E. Actual visible floor space may vary from the stated floor area. All measurements are artist's conception.