

47'  
DESIGNS

The Carlyle / Elev. A & B  
2950 sq.ft.



E/C/CONDUIT FOR TV  
ABOVE FIREPLACE

8ft - Exterior Garden Door,  
full length glass

9FT CEILINGS ON THE  
MAIN FLOOR with 8FT  
DOORS

98" HIGH DOOR FROM  
HOUSE TO GARAGE

48" stove and hood  
fan  
10" vent

Island to 3x5 - includes  
base and countertop (no  
overhang)

Swap location of the  
servery cabinetry and  
the walk-in pantry



Include spacing and  
electrical for beverage  
center

DELETE DOOR FROM  
THE HALLWAY, EXTEND  
THE VANITY

8FT TALL GARAGE  
DOORS

10ft CEILINGS ON MAIN  
FLOOR

ADD DOUBLE DOORS TO  
STUDY

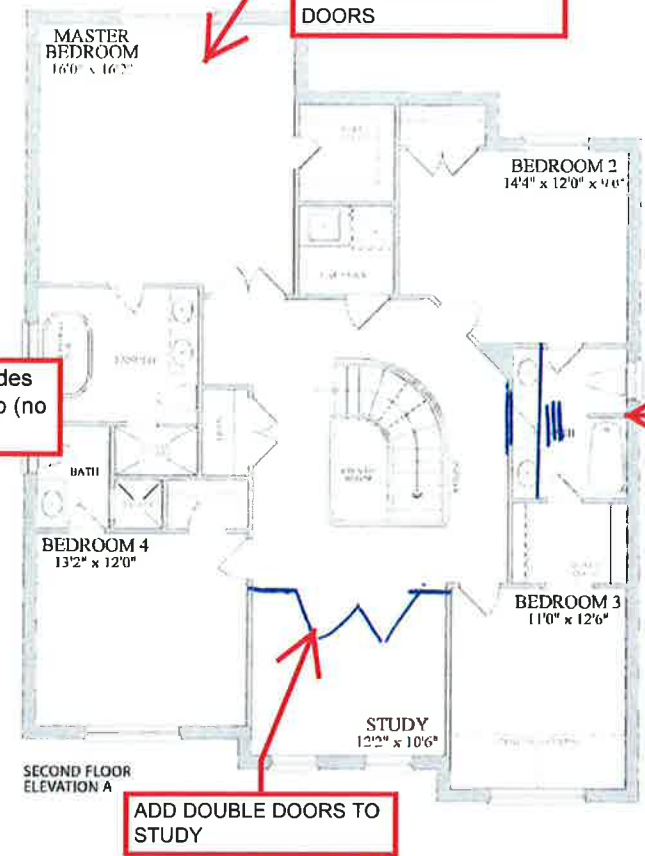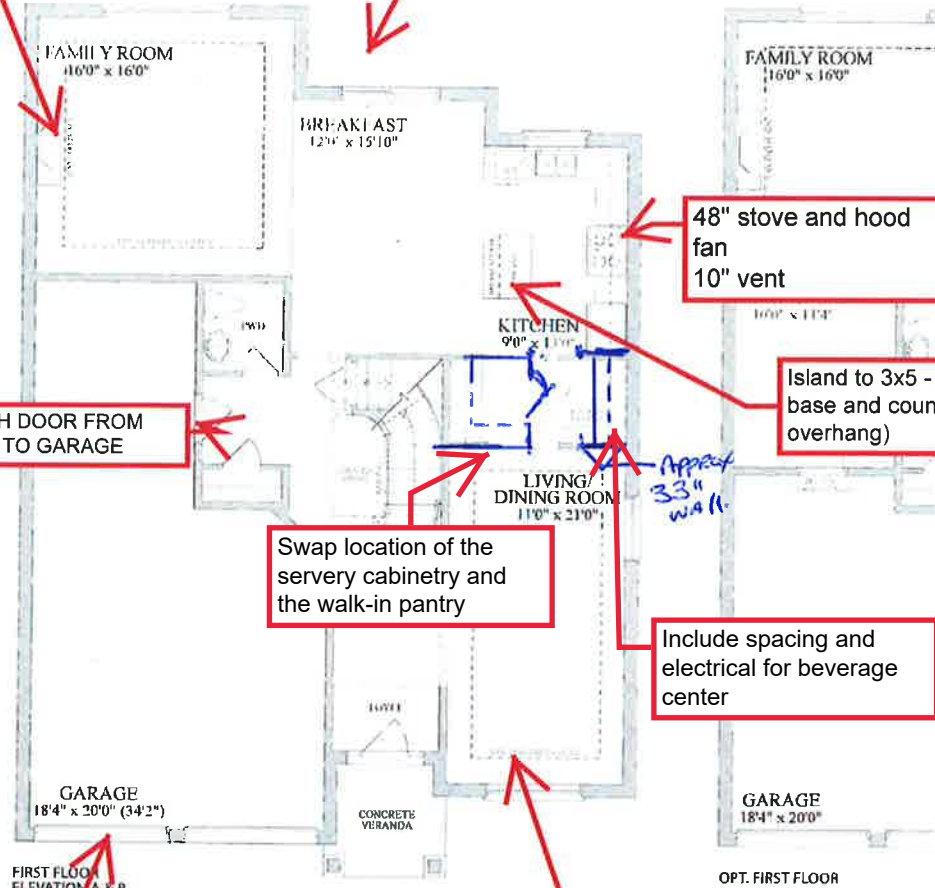

Plans and specifications are subject to change without notice. E & O E. Actual usable floor space may vary from the stated floor area. All renderings are artist's concept.

LOT 1-176, PH1, INNISFIL  
PE002 - SKETCH

PURCHASER: \_\_\_\_\_

PURCAHSER: \_\_\_\_\_