

X = Additional ceiling light

□ = Relocate standard ceiling light

LOT 5-51, INNISFIL




PE 003

Purchaser's Initial: CC



38'
DESIGNS

The Buckhorn / Elev. A & B
1800 sq.ft.

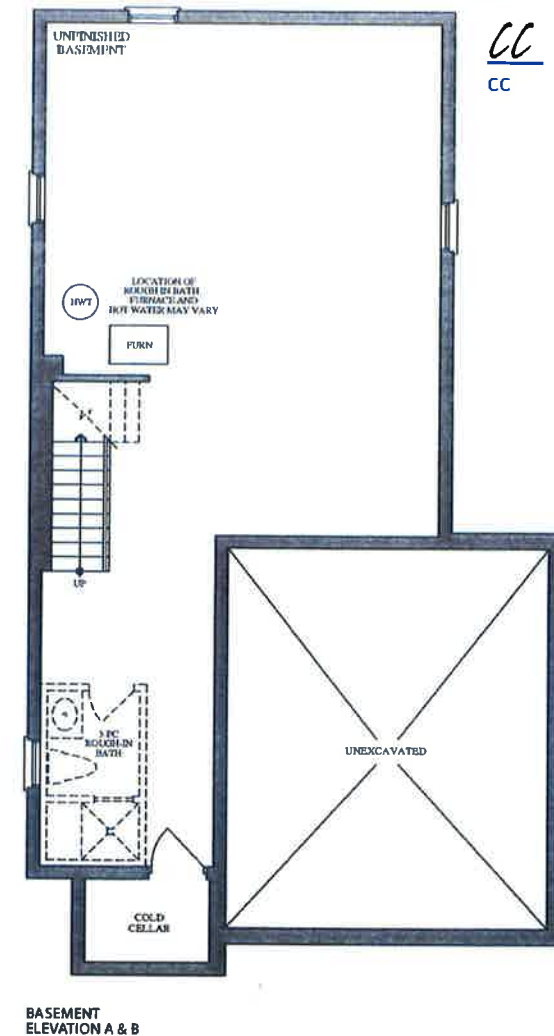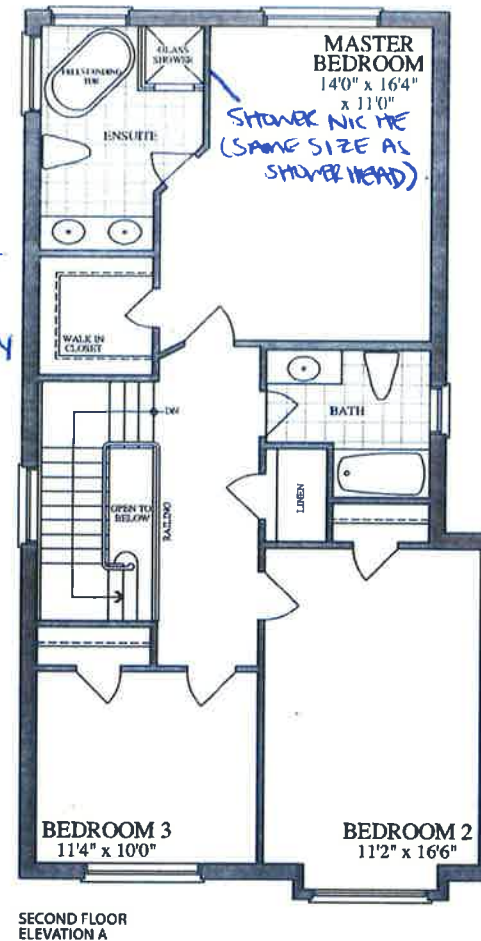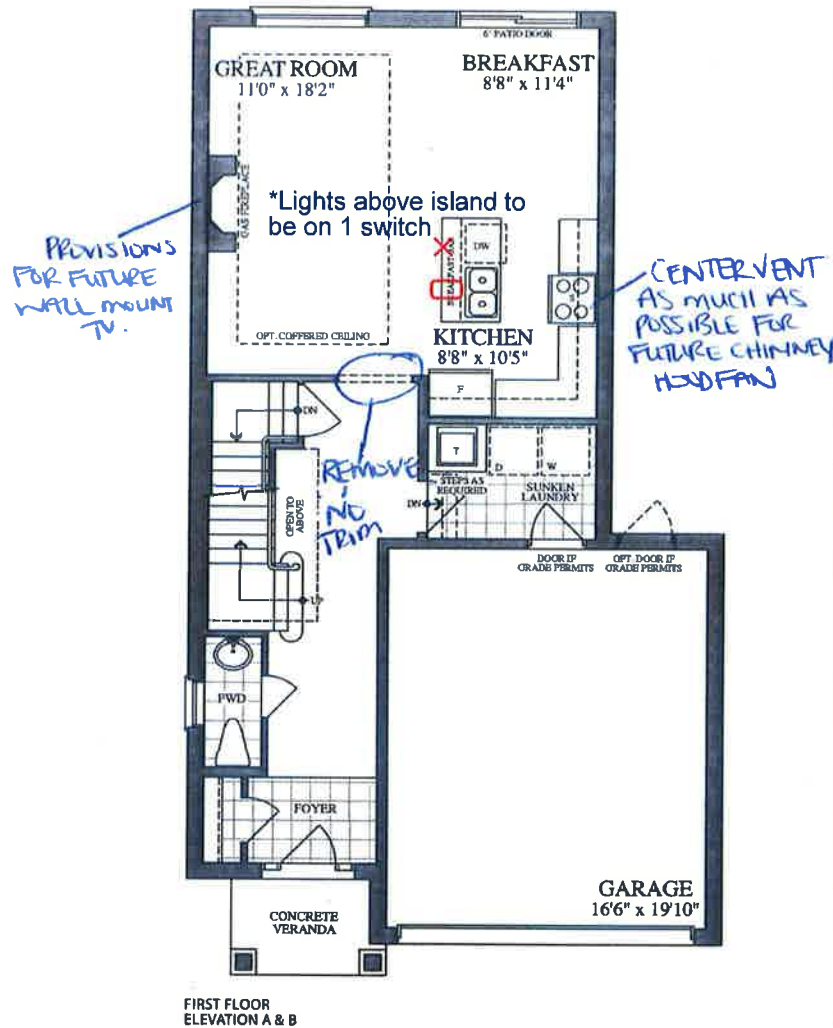

Plans and specifications are subject to change without notice. E. & O. E. Actual usable floor space may vary from the illustrated floor area. All renderings are artist's concepts.