




Plans and specifications are subject to change without notice. © 2013. Actual results may vary from those shown. All trademarks are subject to change.

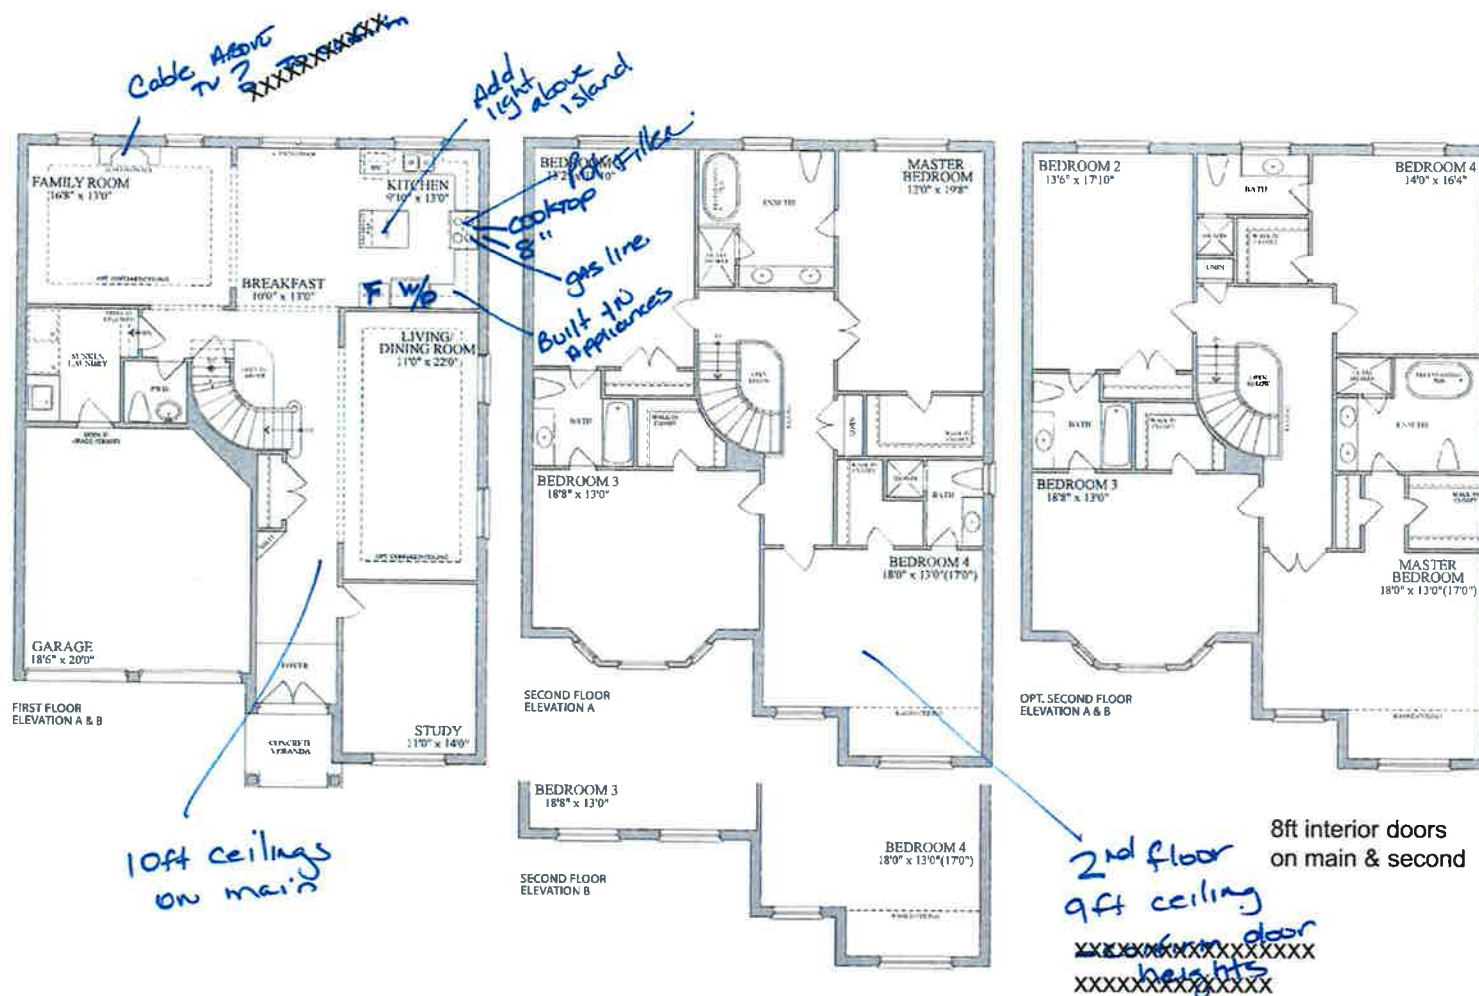

Lot 1-175, PE002

PE002
Satish Sekhri

Purchaser: Satish Sekhri (Feb 9, 2022 16:31 EST)

Purchaser: _____