



38' DESIGNS

The Buckhorn / Elev. A & B
1800 sq.ft.

CARSON'S CREEK

INSTALL TILE
IN LIEU OF HARDWOOD

LOT 2-22, PE002, SKETCH

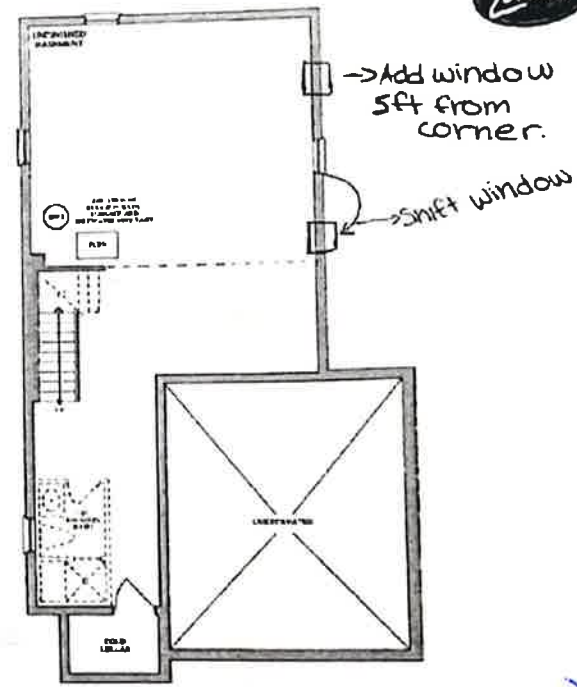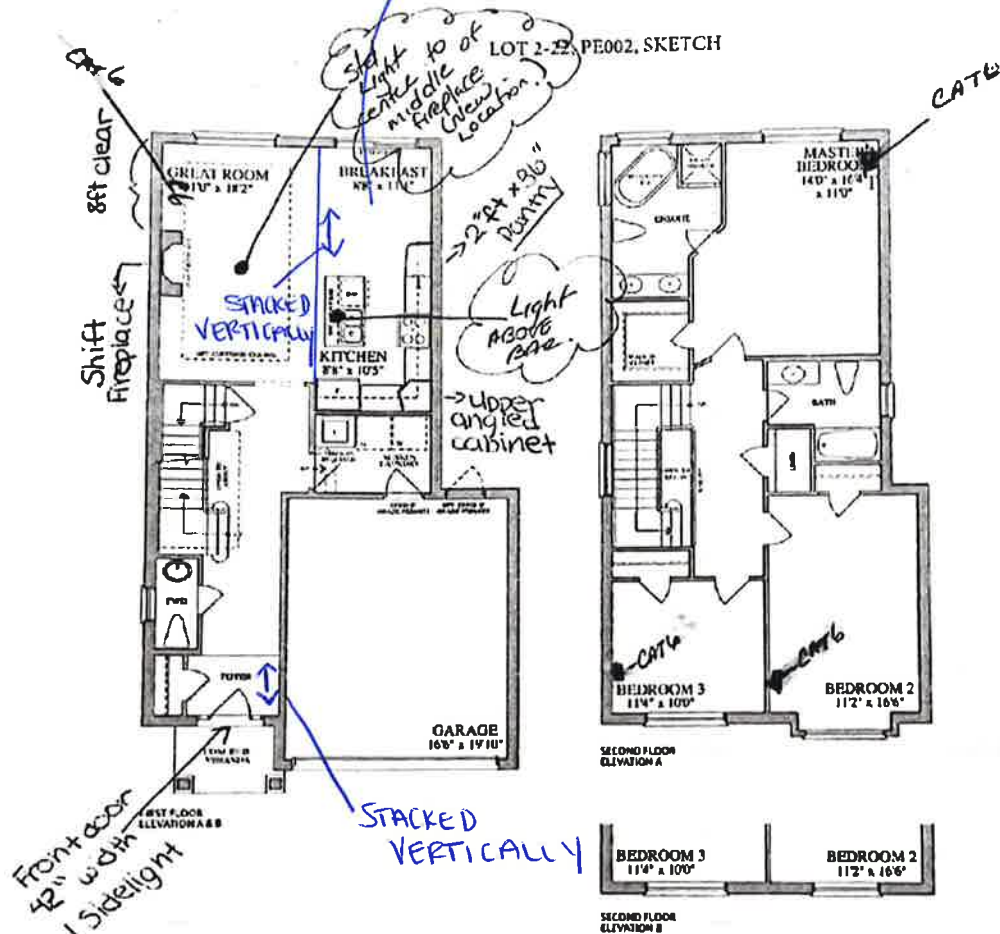

Lot 2-22, PE 003 004
Revisions to Light +
Cable R/I'S

V. Volodin V.V.
N. Volodina N.V.