



The **Kahshe /** Elev. A & **3000** SQ.ft.

 \Box



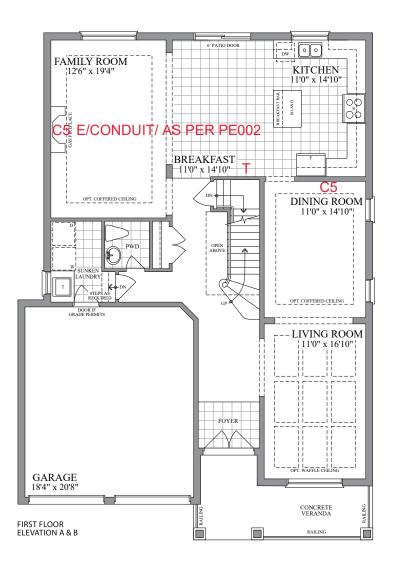

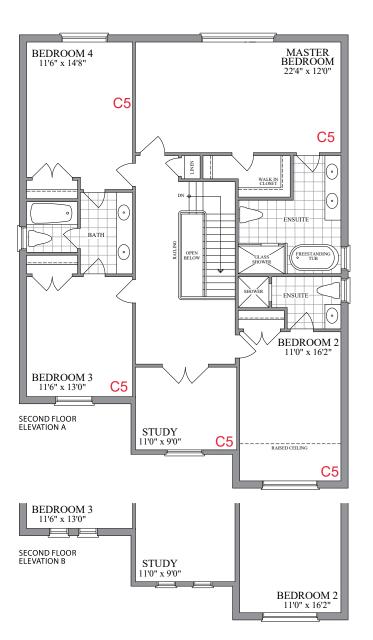

Please indicate the location of the rough-ins on your plan

Description	Symbol on Sketch	Standard Locations
Cable (Rough-in)	С	Family room Or Great Room, all bedrooms, Study/Den/Computer, (as per model)
Cat5	C5	A Cat5 wire can replace the rough-in cable at no additional cost.
Cat6	C6	Upgrade - \$50 per location
Telephone (Rough-in)	Т	Kitchen and Primary Ensuite
Smart-Wire (Cat5)	S	Can be installed a Purchaser's desired location

LOT #: 2-65

Karan Bhanot

PURCHASER Karan Bhanot (Dec 21, 2021 15:01 EST)

PURCHASER Monika Shangari (Dec 21, 2021 15:45 EST)

