

X = Additional ceiling light

□ = Relocate standard ceiling light

LOT 5-51, INNISFIL


PE 003

Purchaser's Initial: CC




38' DESIGNS

The Buckhorn / Elev. A & B
1800 sq.ft.

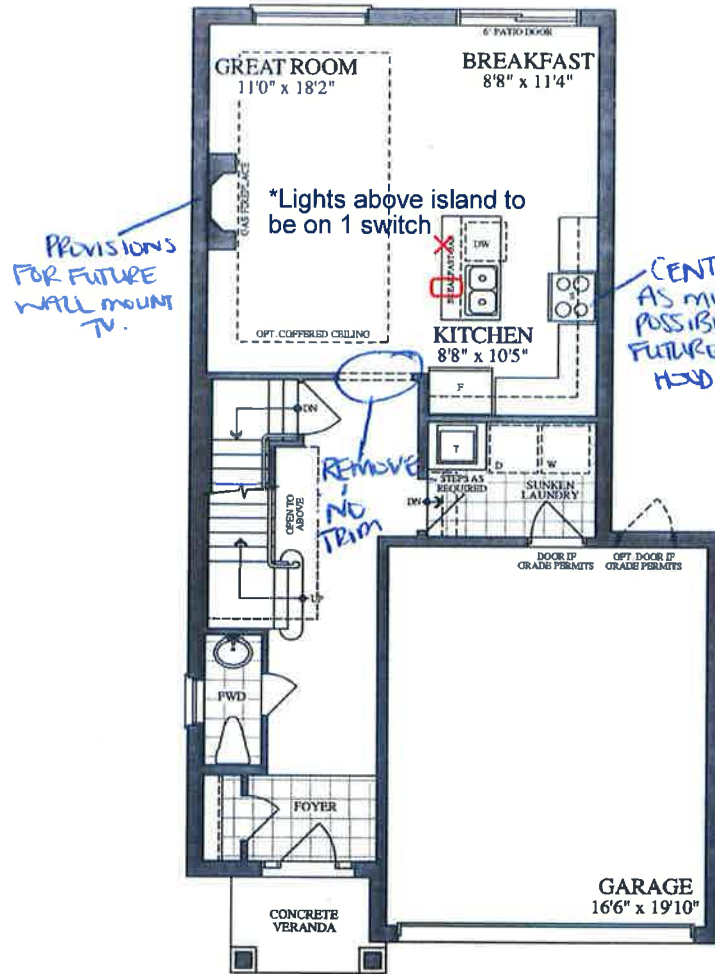


FIRST FLOOR ELEVATION A & B

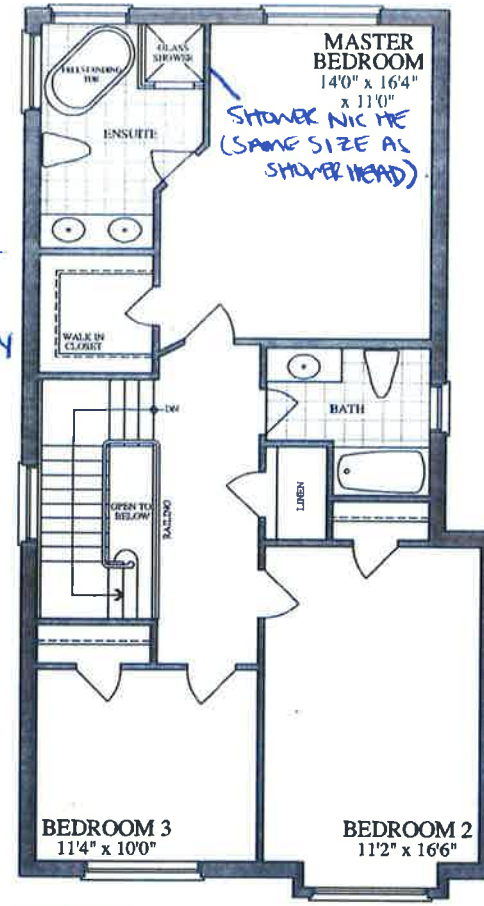

SECOND FLOOR ELEVATION A



SECOND FLOOR ELEVATION B

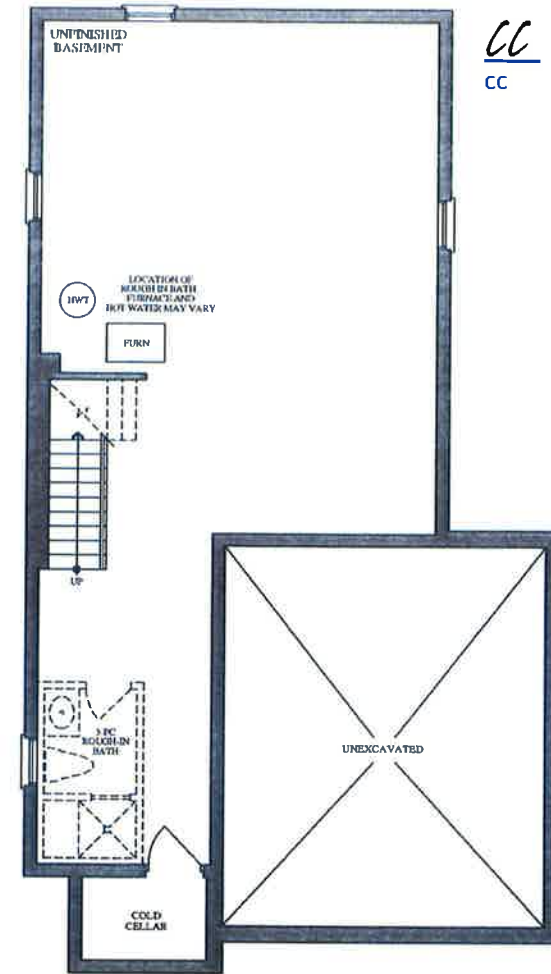

BASEMENT ELEVATION A & B



Plans and specifications are subject to change without notice. E. & O. E. Actual usable floor space may vary from the stippled floor area. All renderings are artist's concept.