


47'
DESIGNS

The Carlyle / Elev. A & B
2950 sq.ft.

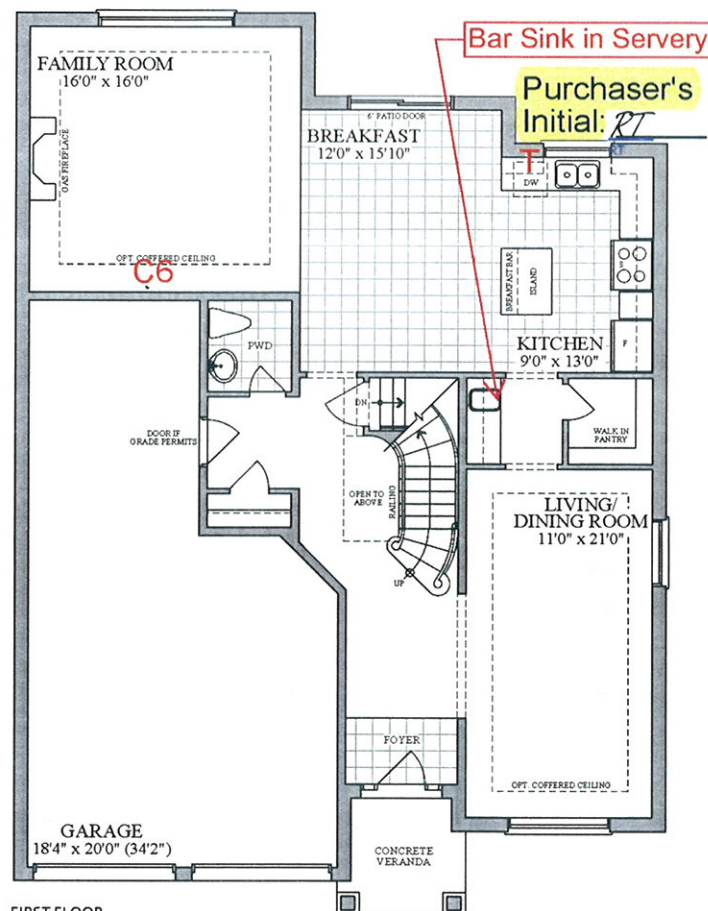

FIRST FLOOR
ELEVATION A & B


Please indicate the location of the rough-ins on your plan

Description	Symbol on Sketch	Standard Locations
Cable (Rough-in)	C	Family room Or Great Room, all bedrooms, Study/Den/Computer, (as per model)
Cat5	C5	A Cat5 wire can replace the rough-in cable at no additional cost.
Cat6	C6	Upgrade - \$50 per location
Telephone (Rough-in)	T	Kitchen and Primary Ensuite
Smart-Wire (Cat5)	S	Can be installed a Purchaser's desired location


LOT #: 2-29, PH2, CABLE LOCATIONS

PURCHASER: RT


PURHASER: _____

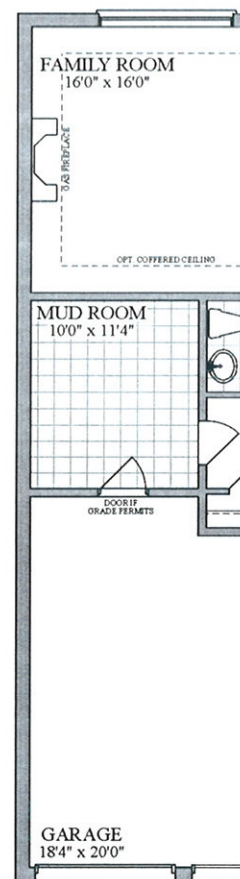

OPT. FIRST FLOOR

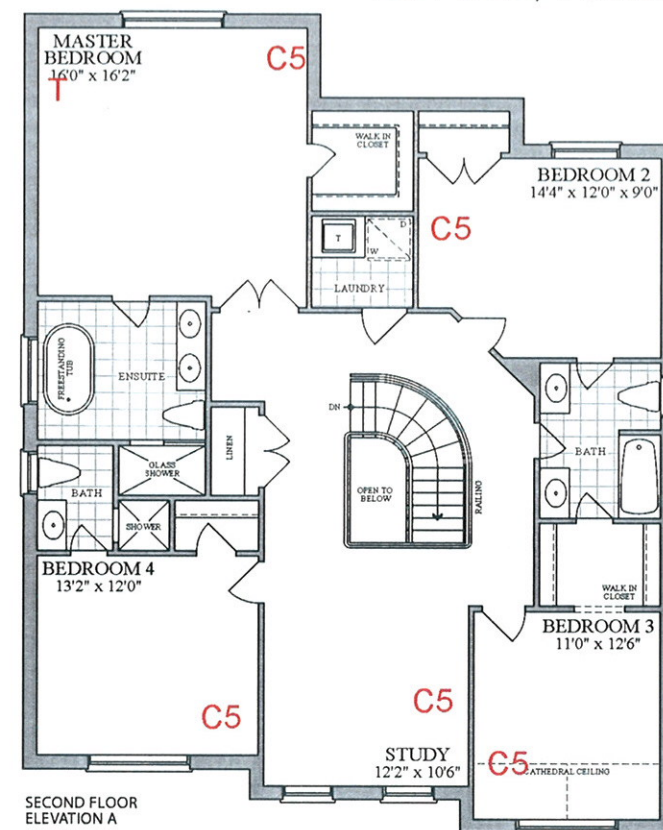


SECOND FLOOR
ELEVATION A

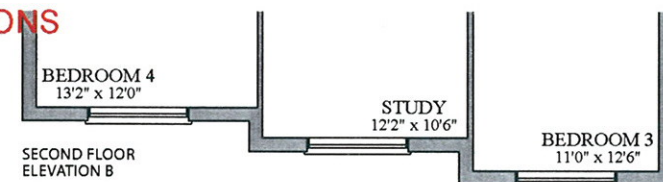


SECOND FLOOR
ELEVATION B


LOT 2-29, INNISFIL, PE003

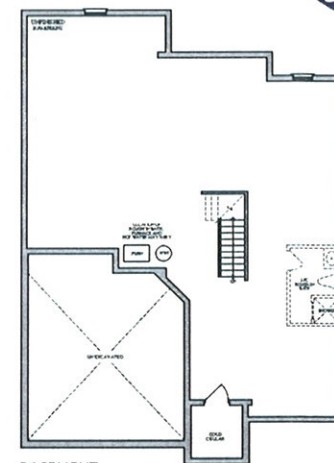

BASEMENT
ELEVATION A

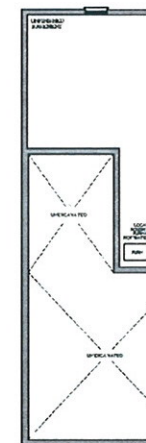

BASEMENT
ELEVATION B

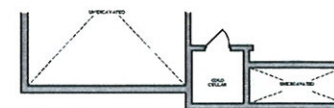

BASEMENT
ELEVATION C

Plans and specifications are subject to change without notice. E. & O. E. Actual usable floor space may vary from the stated floor area. All renderings are artist's concept.