
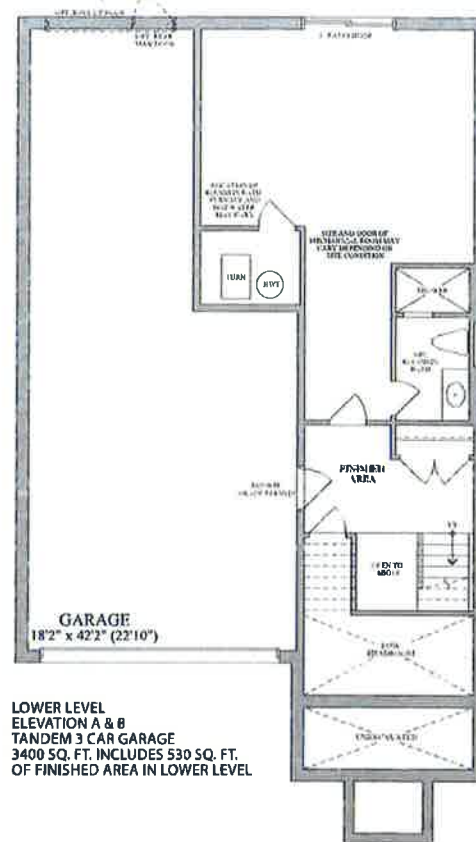
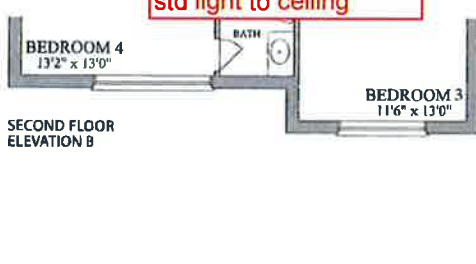
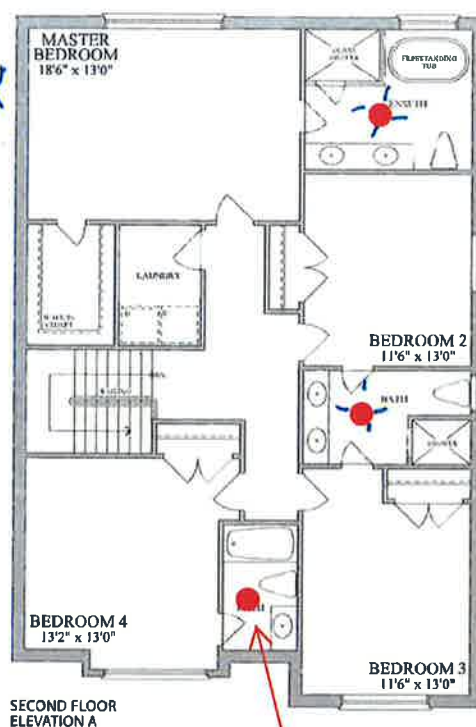
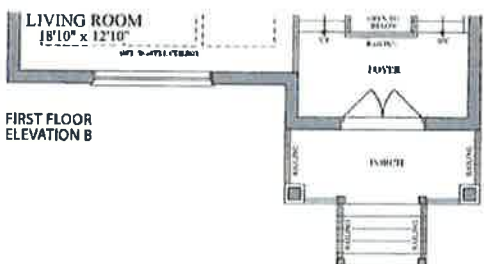


38'
DESIGNS

The Superior / Elev. A & B
3 Car Tandem 3400 sq.ft. - includes 530 sq. ft. of finished area in lower level
2 Car Garage 3615 sq.ft. - includes 748 sq. ft. of finished area in lower level

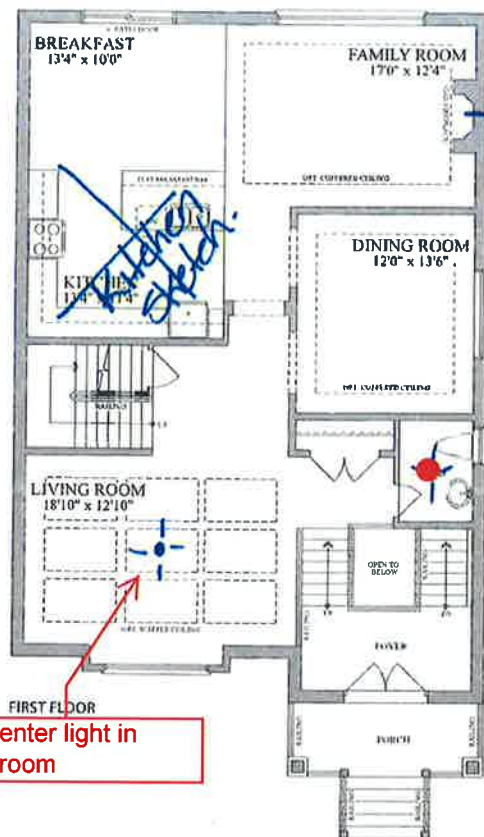

remove standard closet
- relocate the standard
shower here - maintain
the same
measurements for the
bathroom

LOT 5-03, PH5, PE003, SKETCH

Purchaser: Jawad abasi
Jawad abasi (Apr 27, 2022 18:16 EDT)

Purchaser: _____



Plans and specifications are subject to change without notice, E & O, E. Actual usable floor space may vary from the stated floor area. All renderings are artist's concept.



Add Window