


Revised Sketch - for all electrical - PE009

LOT 1-135, INNISFIL, ELECTRICAL ONLY

47'
DESIGNS

The Madawaska / Elev. A & B
3190 sq.ft.

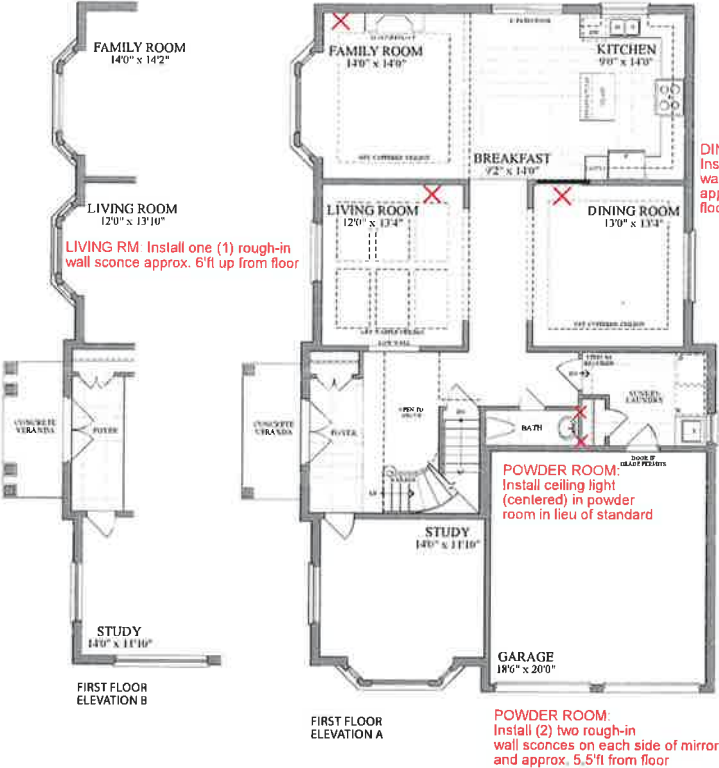


PRIMARY BDRM: Install two (2) rough-in wall sconces approx. 5'ft up from floor & 10'ft between

PRIMARY ENSUITE: Install ceiling light (centered) in bathroom in lieu of standard



PRIMARY ENSUITE: Install one (1) rough-in wall sconce on each end of mirror and one (1) in between; TOTAL three (3)

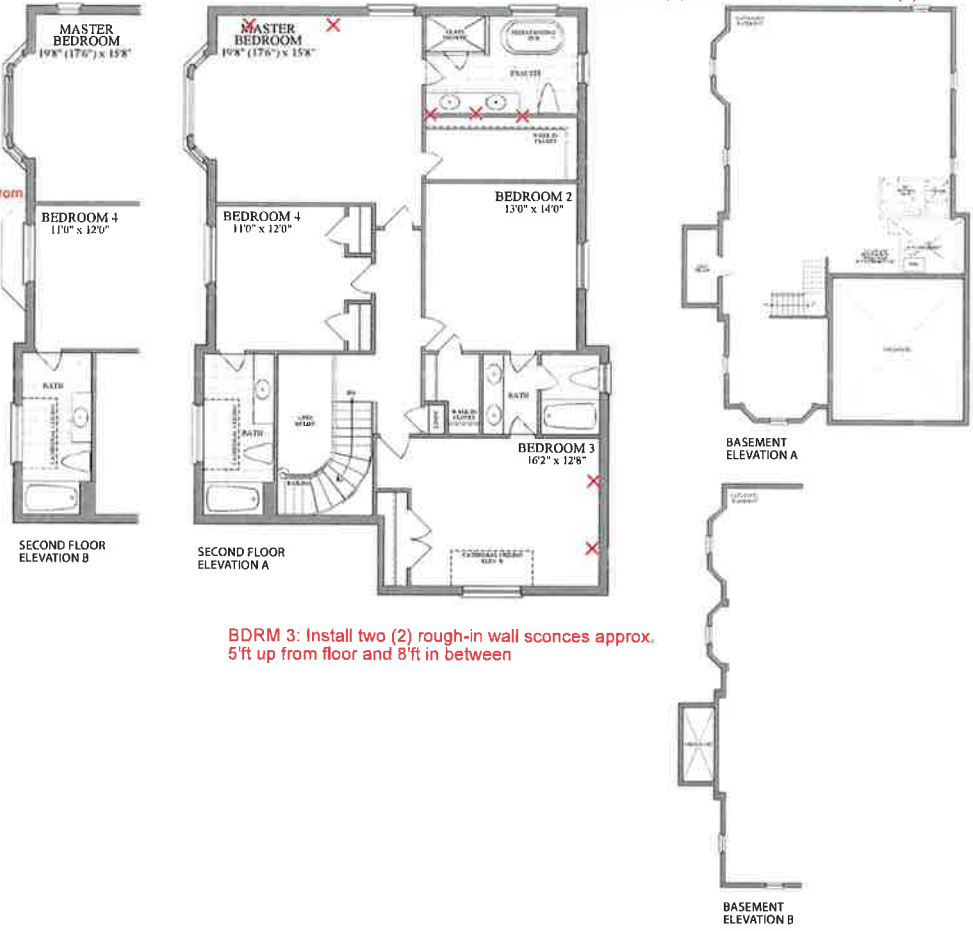

Purchaser's Initial: MPA
MPA



Plans and specifications are subject to change without notice. © D. & O. S. Actual usable floor space may vary from the stated floor area. All measurements are artist's concept.