
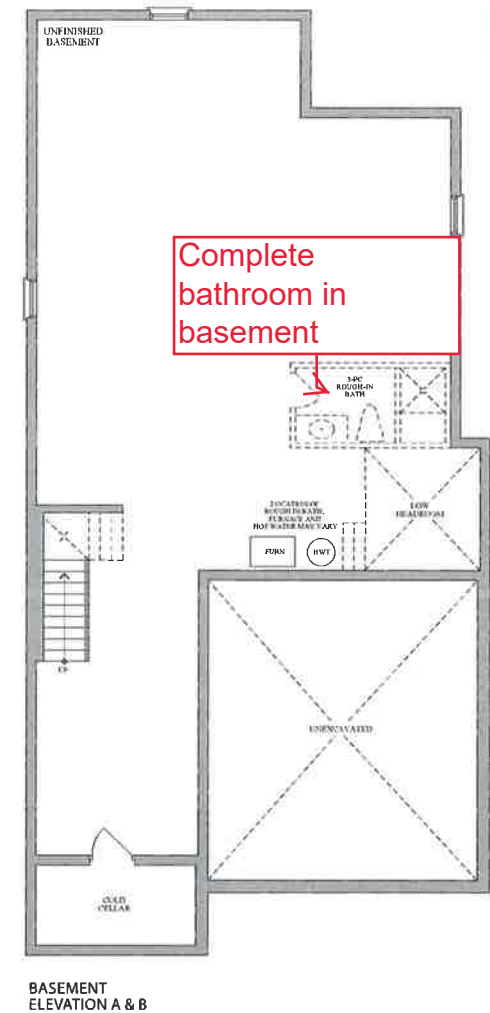
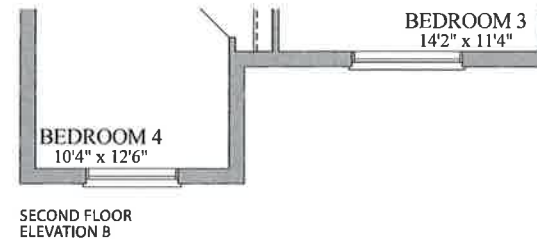
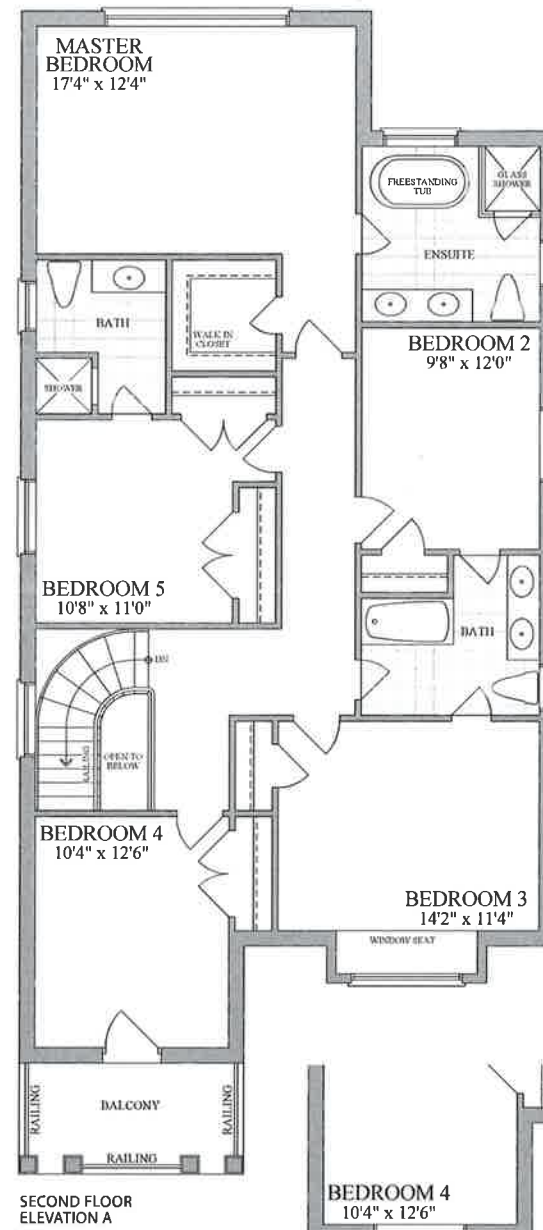


38'
DESIGNS

The Timiskaming / Elev. A
2775 sq.ft.

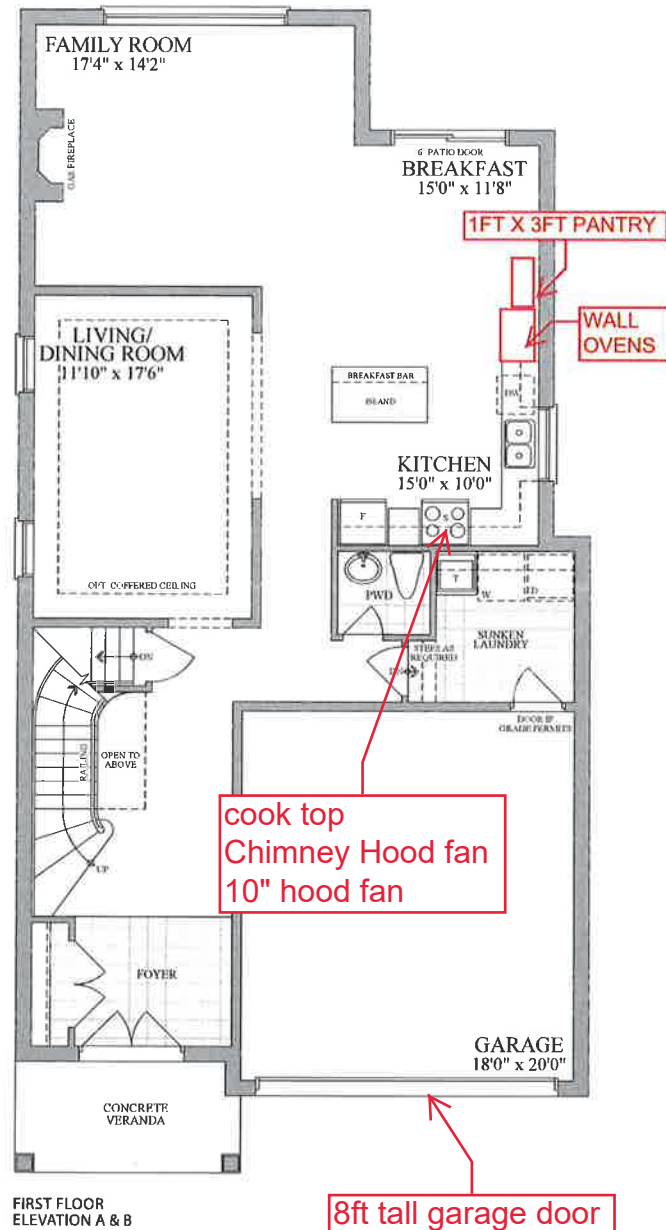

LOT 5-84
PURCHASER Oluwatoyin Adenuga
PURCHASER Adenike Adenuga

Plans and specifications are subject to change without notice. E. & O. E. Actual usable floor space may vary from the stated floor area. All renderings are artist's concept.