
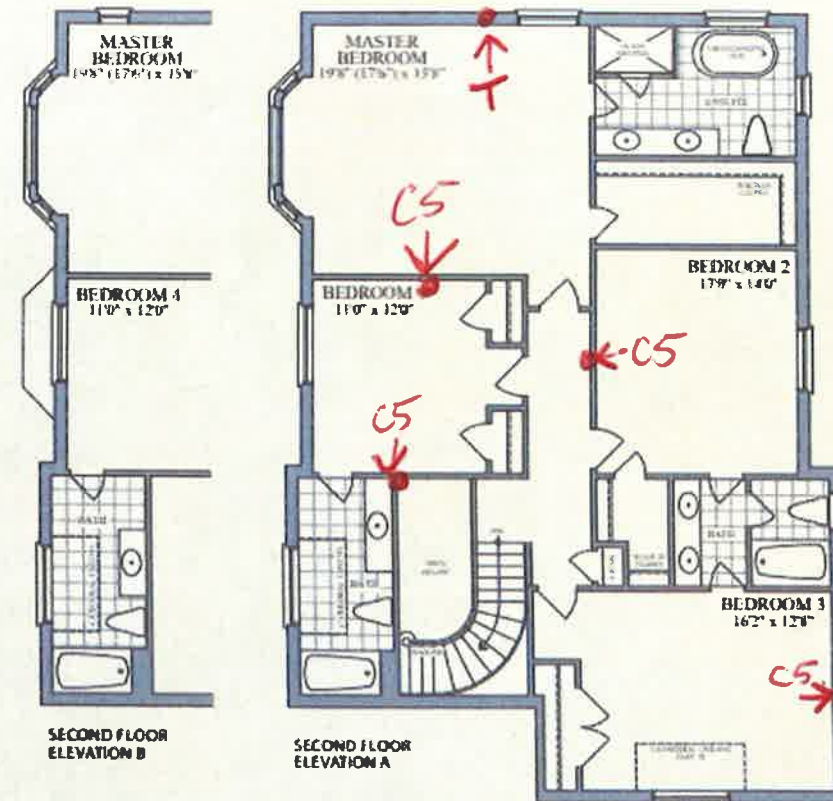


47th
DESIGNS

The madawaska / Elev. A & B
3190 sq.ft.

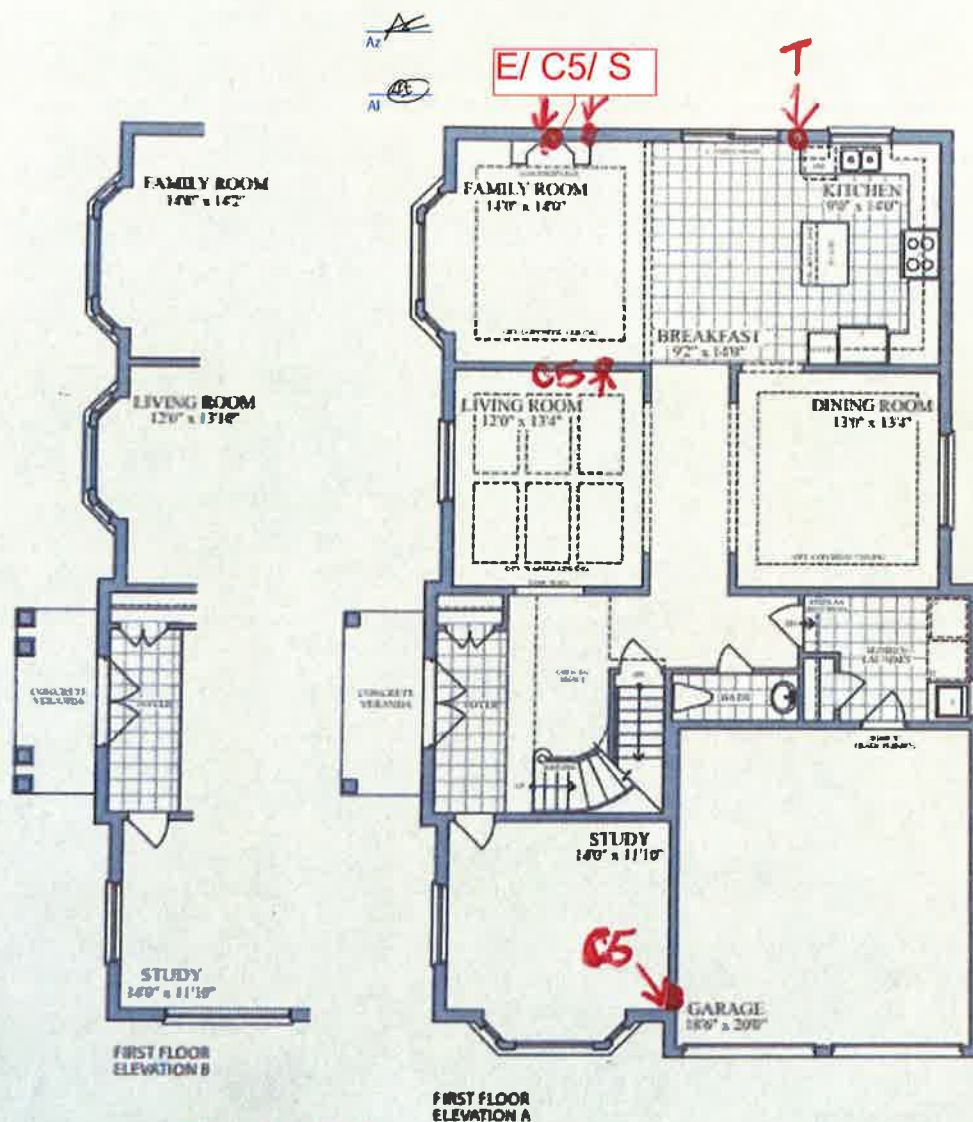

Please indicate the location of the rough-ins on your plan

Description	Symbol on Sketch	Standard Locations
Cable (Rough-in)	C	Family room Or Great Room, all bedrooms, Study/Den/Computer, (as per model)
Cat5	C5	A Cat5 wire can replace the rough-in cable at no additional cost.
Cat6	C6	Upgrade - \$50 per location
Telephone (Rough-in)	T	Kitchen and Primary Ensuite
Smart-Wire (Cat5)	S	Can be installed a Purchaser's desired location

LOT #: 5-65, PH 5
PURCHASER: Ali Raza Zaidi
PURCHASER: Aysha Imtiaz



Plans and specifications are subject to change without notice. E. & C. E. Architect reserves the right to modify these plans without notice. All measurements are subject to change.