


38'
DESIGNS


The Finlay / Elev. A & B
2515 sq.ft.

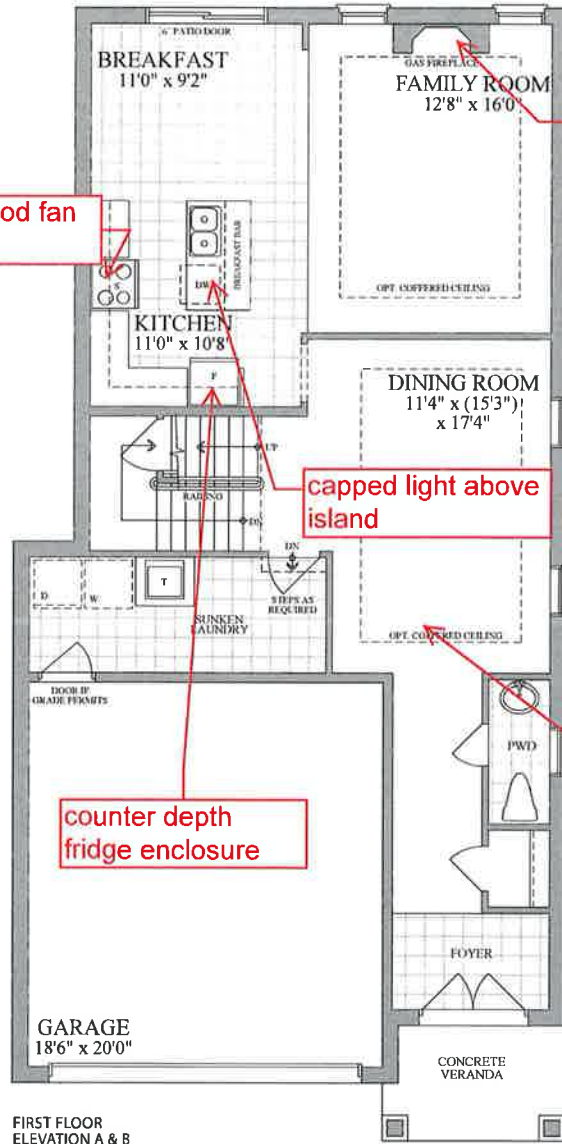

FIRST FLOOR
ELEVATION A & B

Provision for TV
above the fireplace
E/Conduit/Cable


smooth ceilings
throughout the
main floor

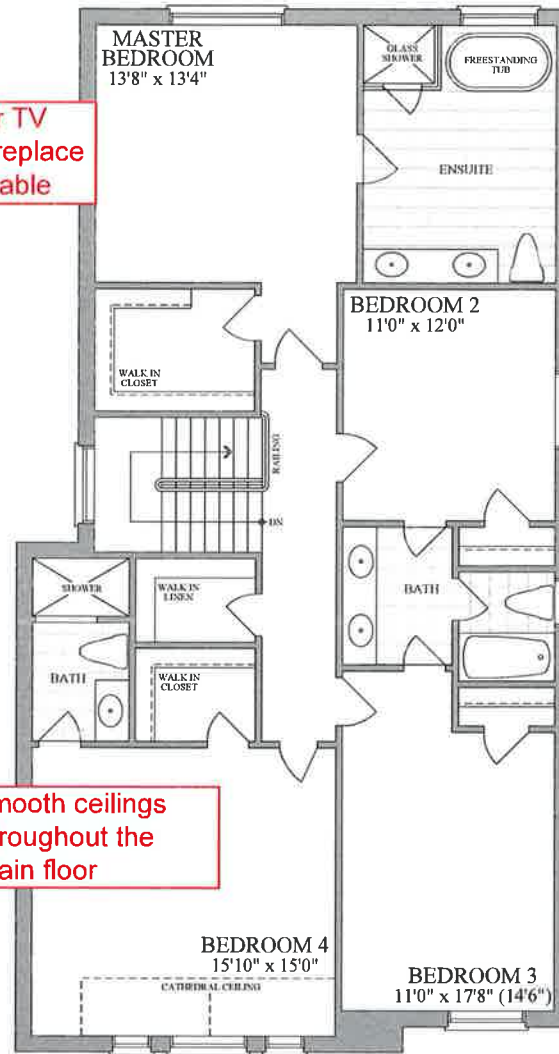

SECOND FLOOR
ELEVATION A



SECOND FLOOR
ELEVATION B

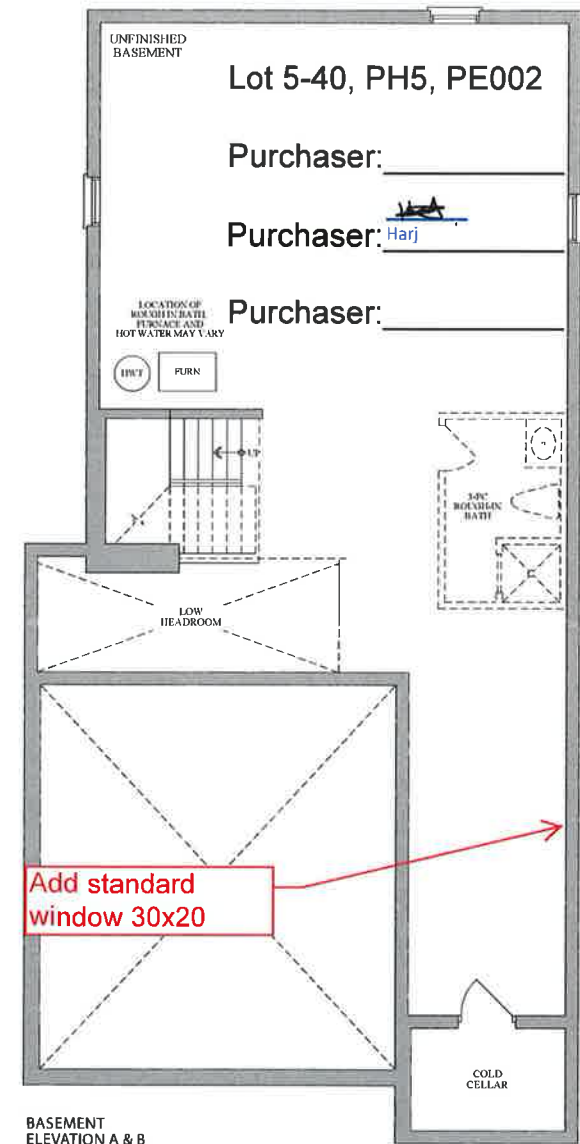

BASEMENT
ELEVATION A & B



Lot 5-40, PH5, PE002

Purchaser: _____

Purchaser: Harj

Purchaser: _____