


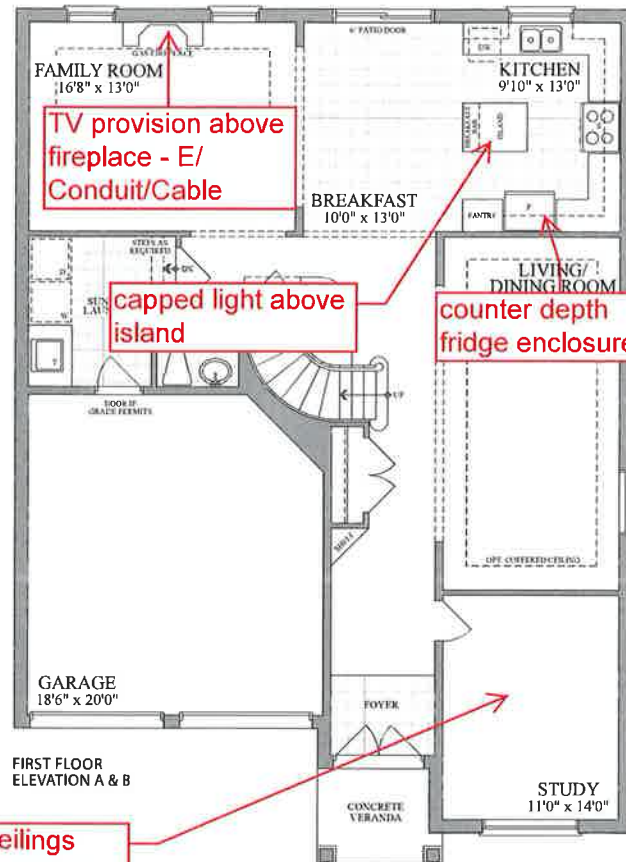

smooth ceilings
throughout main
floor

LOT 5-27, PH5, PE002

Purchaser: Jaswant kaur Thind
Jaswant kaur Thind (May 3, 2022 23:32 EDT)

Purchaser: _____



Plans and specifications are subject to change without notice. E. & O. E. Actual usable floor space may vary from the stated floor area. All renderings are artist's concept.

