

LOT 5-75, INNISFIL, PE003

Purchaser's Initial(s): Nst Jkt


Tiles: At foyer, powder room, kitchen/breakfast area to be installed stacked horizontally

Tiles: In Primary Ensuite & Shared Bath to be installed stacked vertically



47' DESIGNS

The Kahshe / Elev. A & B  
3000 sq.ft.

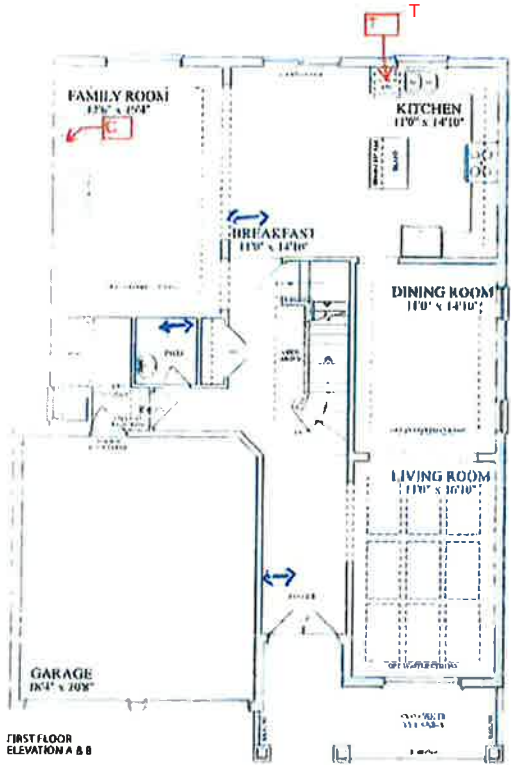

Tiles: 2nd Ensuite (Bdrm 2) to be installed stacked horizontally

Please indicate the location of the rough-ins on your plan

| Description          | Symbol on Sketch | Standard Locations                                                          |
|----------------------|------------------|-----------------------------------------------------------------------------|
| Cable (Rough-In)     | C                | Family room Or Great Room, all bedrooms, Study/Den/Computer, (as per model) |
| Cat5                 | C5               | A Cat5 wire can replace the rough-in cable at no additional cost.           |
| Cat6                 | C6               | Upgrade - \$50 per location                                                 |
| Telephone (Rough-In) | T                | Kitchen and Primary Ensuite                                                 |
| Smart-Wire (Cat5)    | S                | Can be installed a Purchaser's desired location                             |

LOT # 5-75

PURCHASER: Innovative

PURCHASER: Innovative

