


Initial: NKM




38'
DESIGNS

The manitou / Elev. A & B
2480 sq.ft.

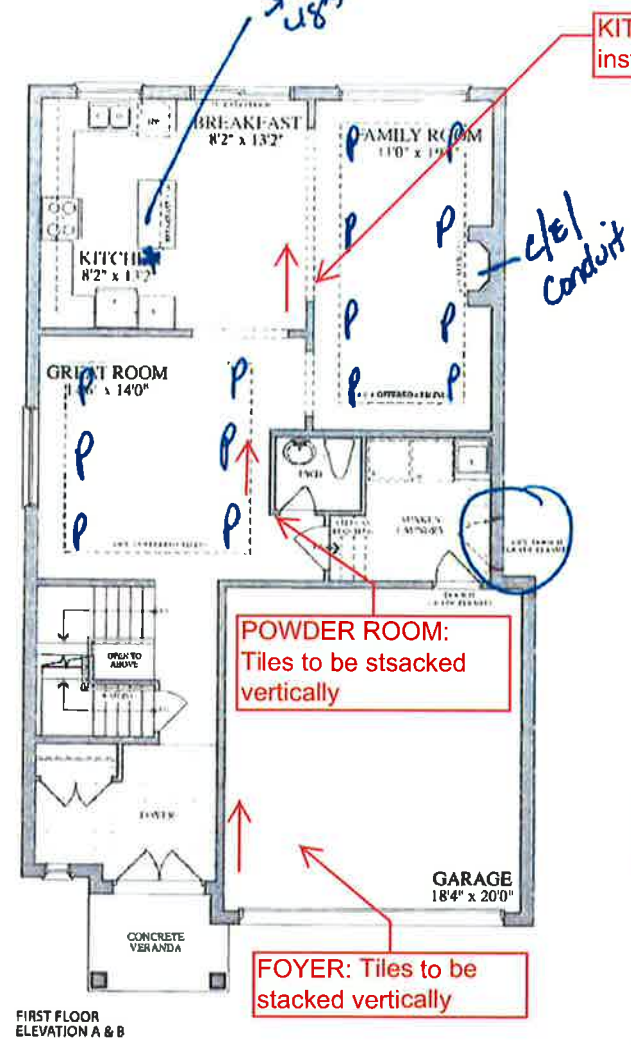

FIRST FLOOR
ELEVATION A & B


KITCHEN: Tiles to be installed vertically

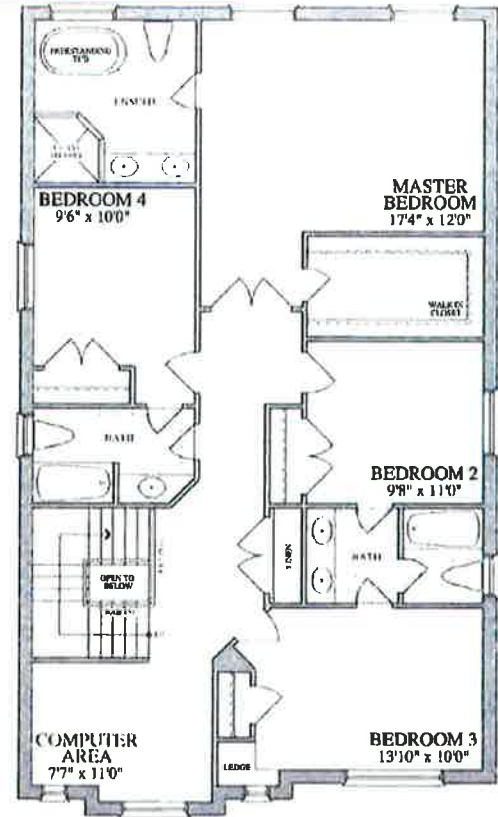

SECOND FLOOR
ELEVATION A



SECOND FLOOR
ELEVATION B

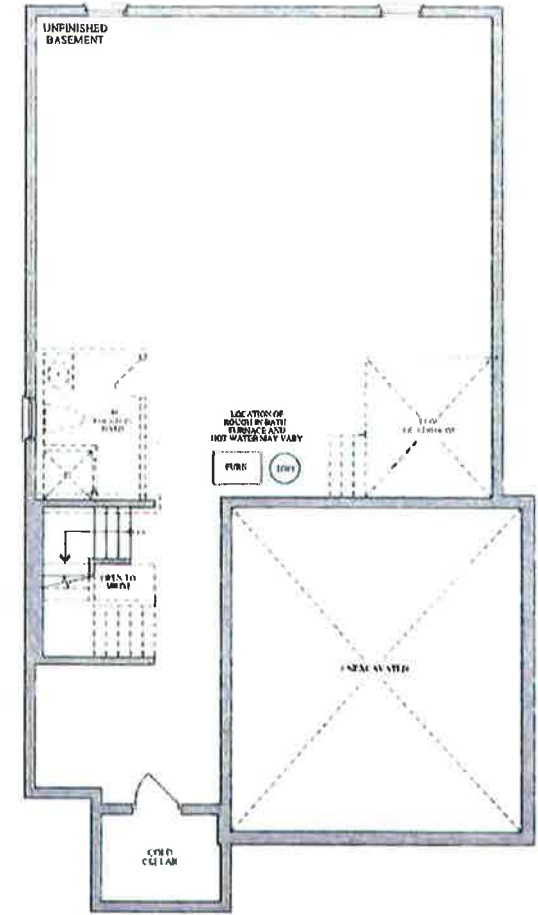

BASEMENT
ELEVATION A & B



Plans and specifications are subject to change without notice. E & O E. Actual results may vary from the stated floor area. All renderings are artist's concept.

LOT 5-78, PE002

PURCHASER: Narinder Manihani (Aug 25, 2021 15:30 EDT)