



47'
DESIGNS

The nipissing / Elev. A & B
3210 sq.ft.


LOT 5-80, INNISFIL, PE003

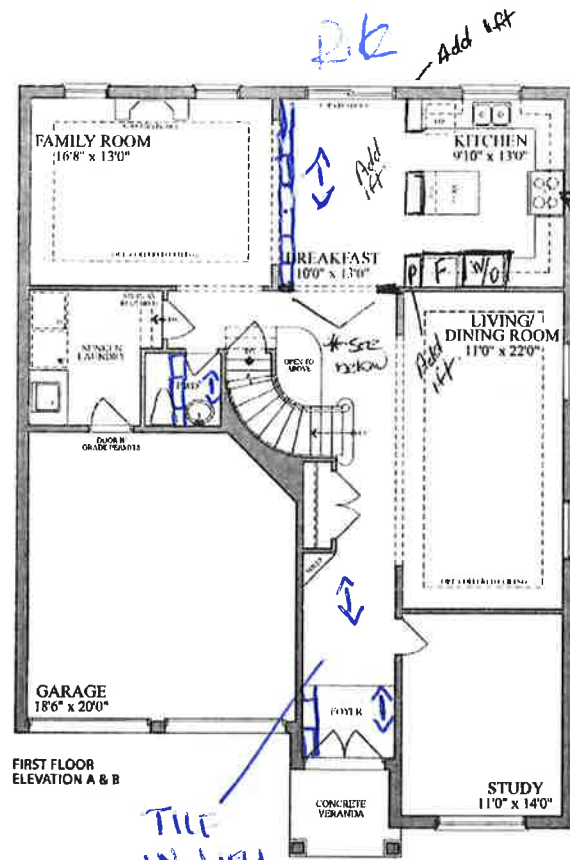


FIRST FLOOR
ELEVATION A & B

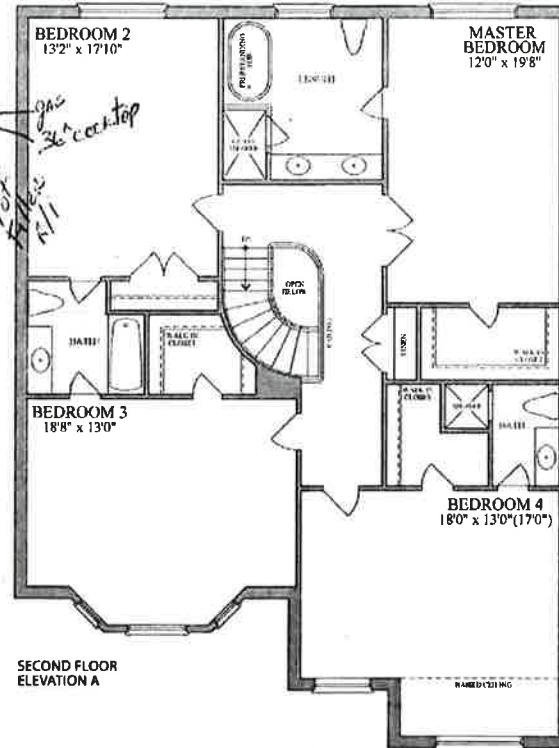

SECOND FLOOR
ELEVATION A

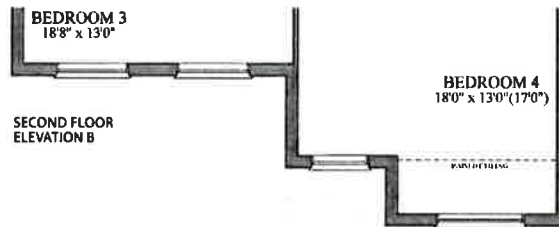

SECOND FLOOR
ELEVATION B

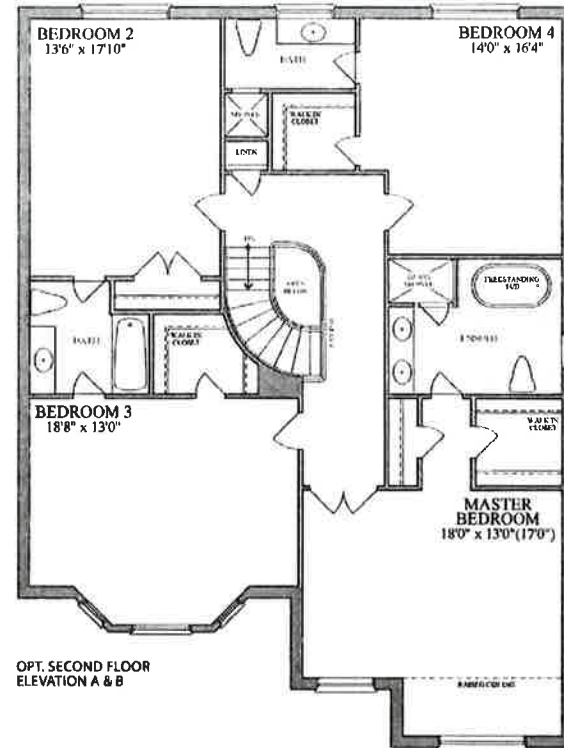


OPT. SECOND FLOOR
ELEVATION A & B

* We need to extend this wall so that we can get extra room for the built-in appliances

Lot 5-80
PE #003

DR

RB

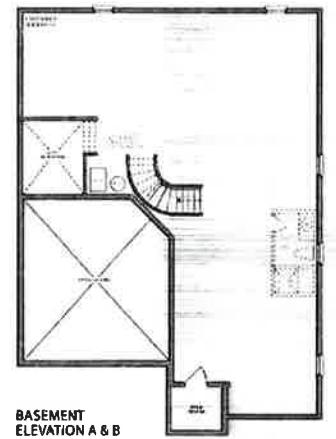

BASEMENT
ELEVATION A & B



Plans and specifications are subject to change without notice. C & O. E. Actual usable floor space may vary from the stated floor area. All measurements are artist's concept.