



The Kahshe / Elev. A & B 3000 SQ.ft.



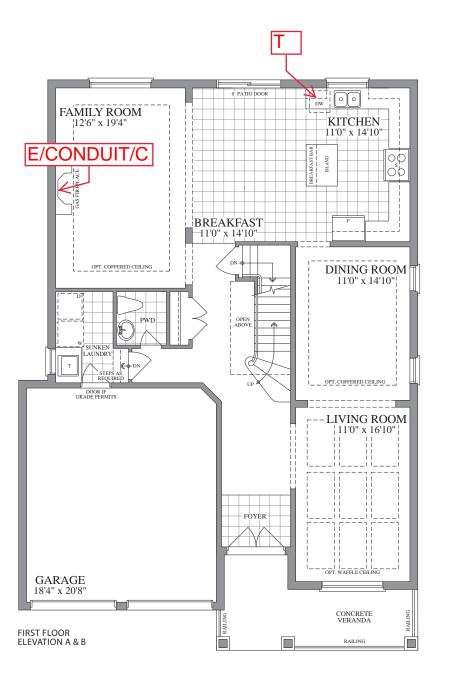

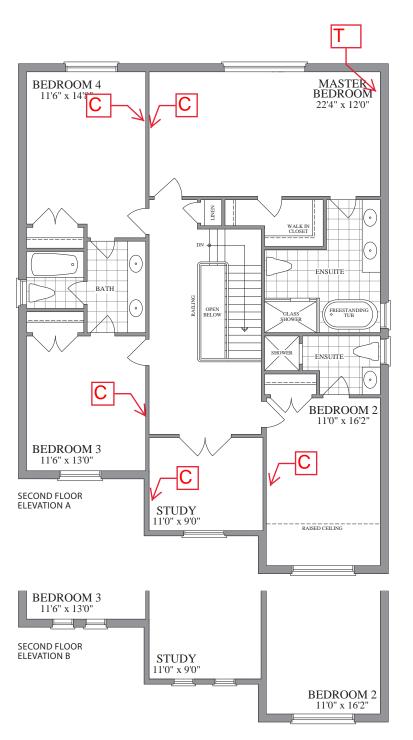

Please indicate the location of the rough-ins on your plan

Symbol on Sketch	Standard Locations	
С	Family room Or Great Room, all bedrooms, Study/Den/Computer, (as per model)	
C 5	A Cat5 wire can replace the rough-in cable at no additional cost.	
C6	Upgrade - \$50 per location	
Т	Kitchen and Primary Ensuite Can be installed a Purchaser's desired location	
S		
	Sketch C C5 C6 T	

LOT #:	5-63	
PURCHAS	SER: Hafsa Majid (Jun 24, 2022 10:53 MDT)	
PURCHAS	SER:	

