


38'
DESIGNS


The **Buckhorn** / Elev. A & B
1800 sq.ft.




Plans and specifications are subject to change without notice. E. & O. E. Actual usable floor space may vary from the stated floor area. All renderings are artist's concept.

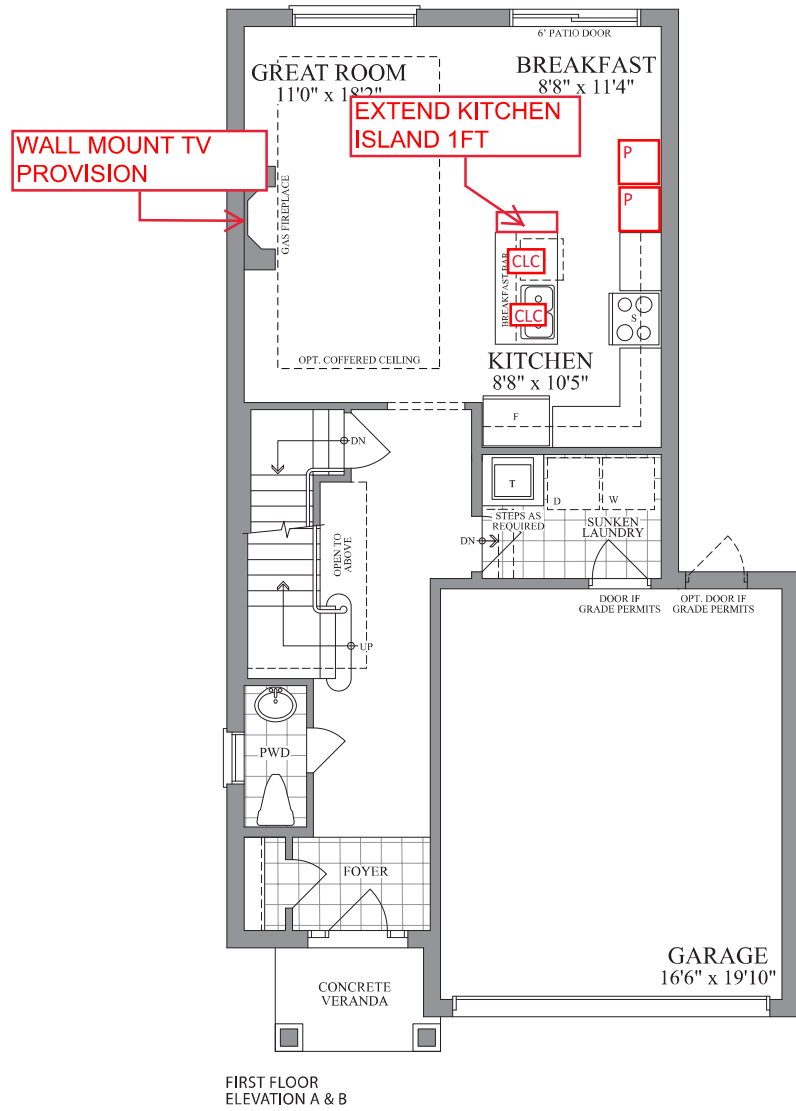


FIRST FLOOR
ELEVATION A & B

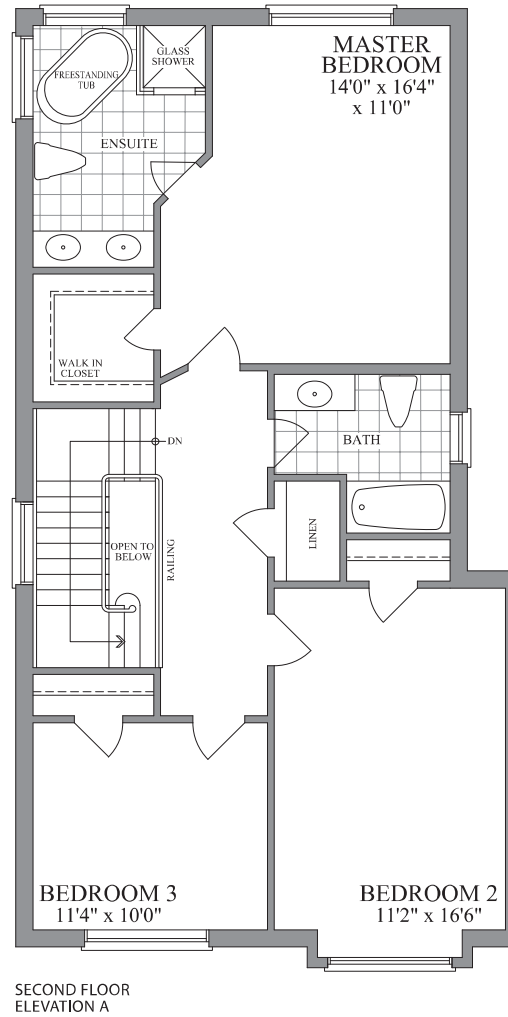

SECOND FLOOR
ELEVATION A

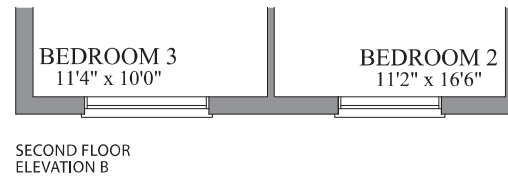

SECOND FLOOR
ELEVATION B

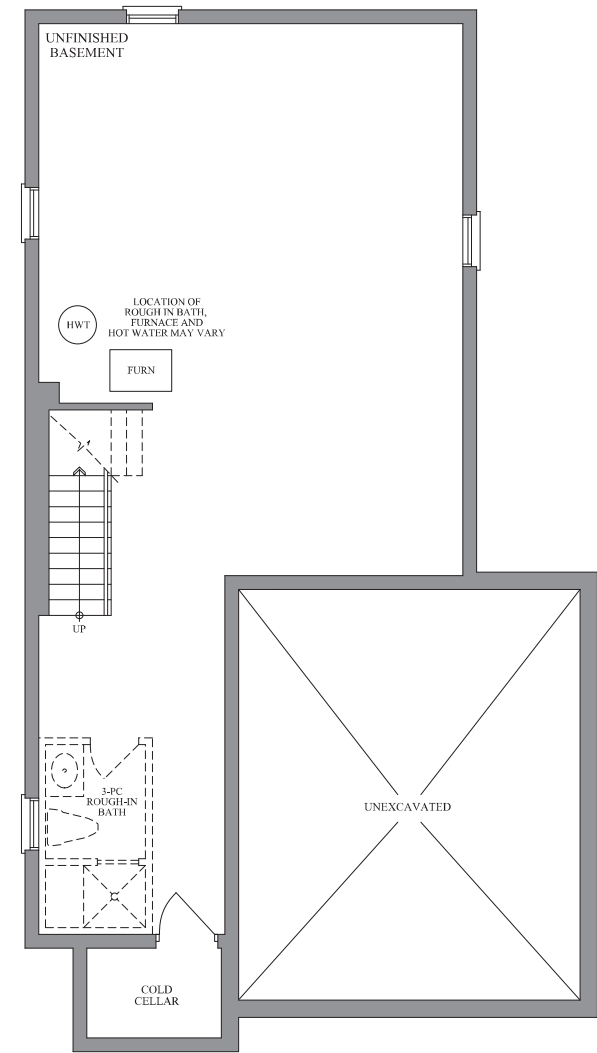

BASEMENT
ELEVATION A & B

LOT 5-10, PH5, INNISFIL - PE003

PURCHASER: Tony (Jun 27, 2022 23:16 EDT)

PURCHASER: SMitha Thomas
SMitha Thomas (Jun 27, 2022 23:33 EDT)