
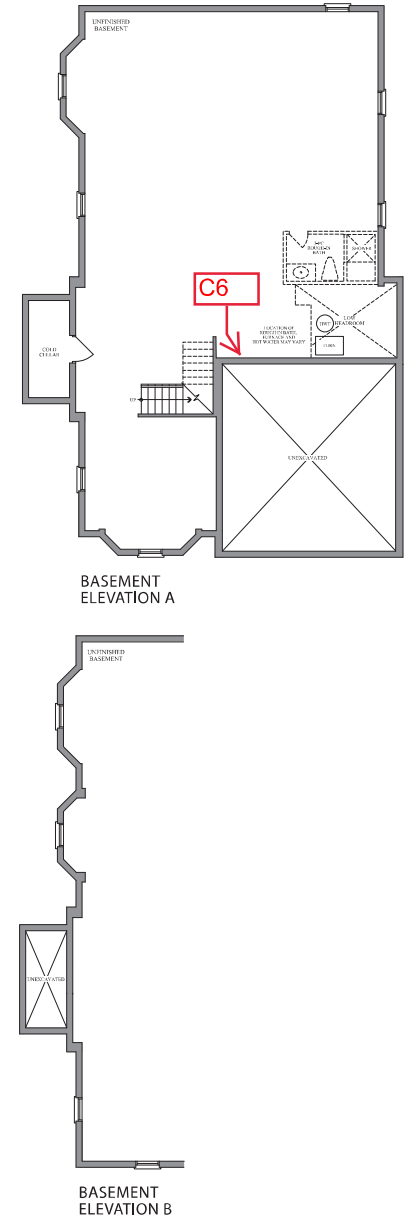
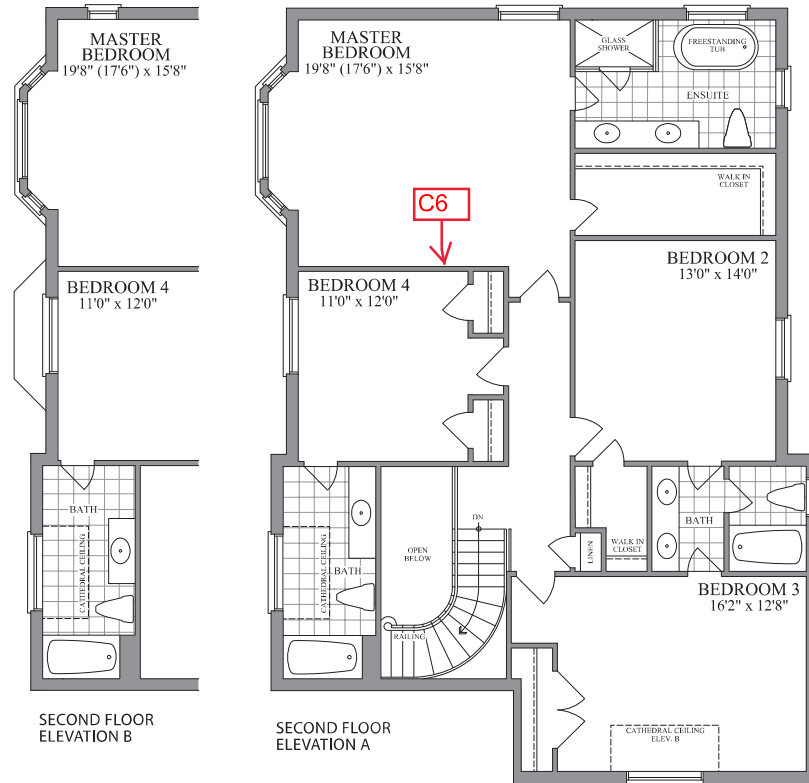


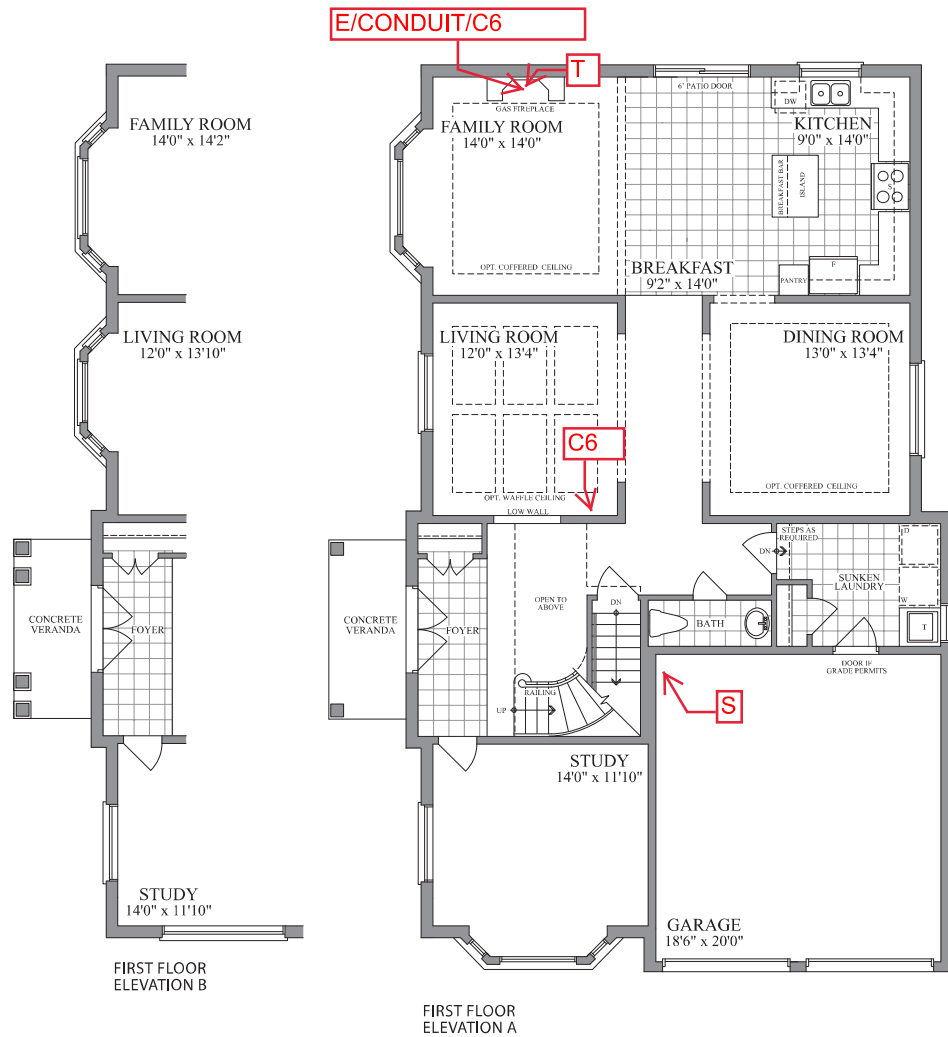

Please indicate the location of the rough-ins on your plan

Description	Symbol on Sketch	Standard Locations
Cable (Rough-in)	C	Family room Or Great Room, all bedrooms, Study/Den/Computer, (as per model)
Cat5	C5	A Cat5 wire can replace the rough-in cable at no additional cost.
Cat6	C6	Upgrade - \$50 per location
Telephone (Rough-in)	T	Kitchen and Primary Ensuite
Smart-Wire (Cat5)	S	Can be installed a Purchaser's desired location

LOT #: 5-24

PURCHASER: Hassan Dawari (Jun 29, 2022 15:31 EDT)

PURCHASER: Arzoo Akbari (Jun 29, 2022 12:11 EDT)

Plans and specifications are subject to change without notice, E. & O. E. Actual usable floor space may vary from the stated floor area. All renderings are artist's concept.