
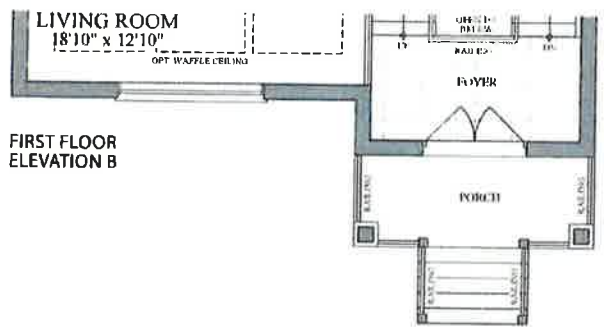


38'
DESIGNS



The Superior / Elev. A & B
3 Car Tandem 3400 sq.ft. - includes 530 sq. ft. of finished area in lower level
2 Car Garage 3615 sq.ft. - includes 748 sq. ft. of finished area in lower level

8ft wide patio sliders - standard height

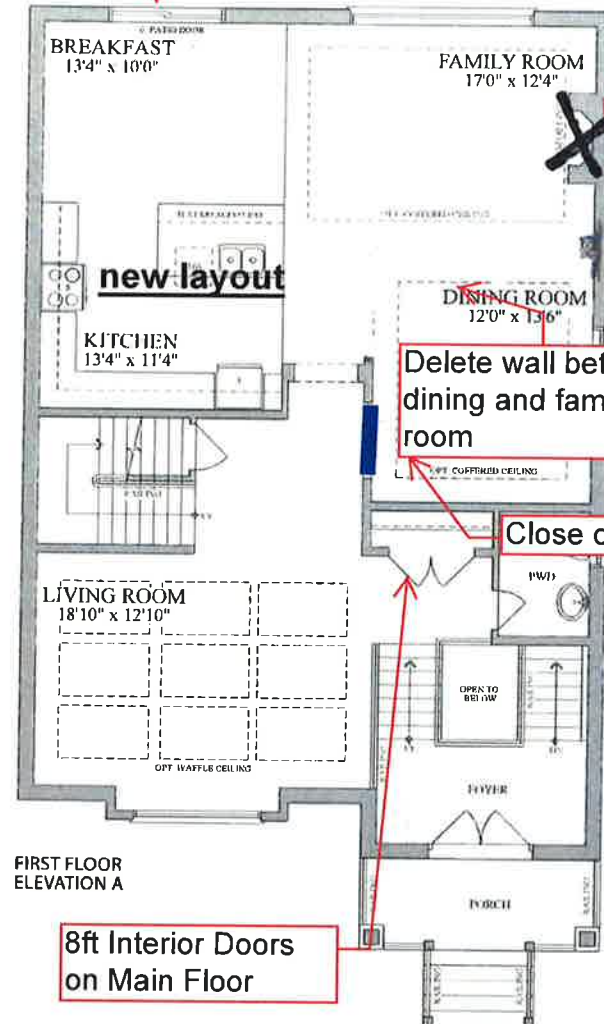

Increase the walk-in closet approx 1-1 1/2ft


Delete Fireplace

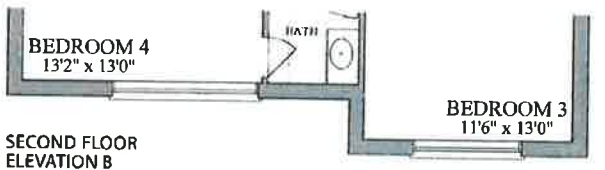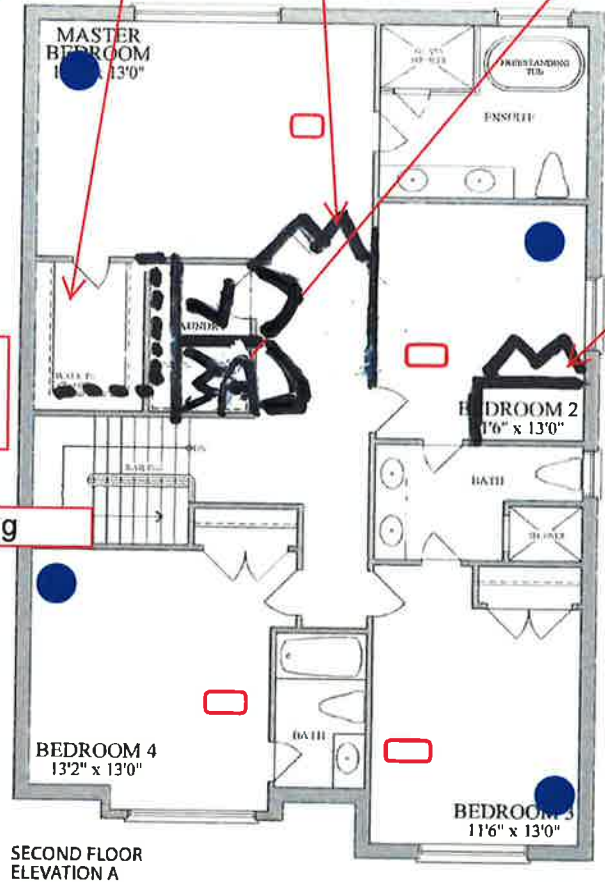

Add double doors to Primary Bedroom

Provide stackable washer and dryer - entry from hallway
Add Linen closet.


Relocate closet in Bdrm 2 here.

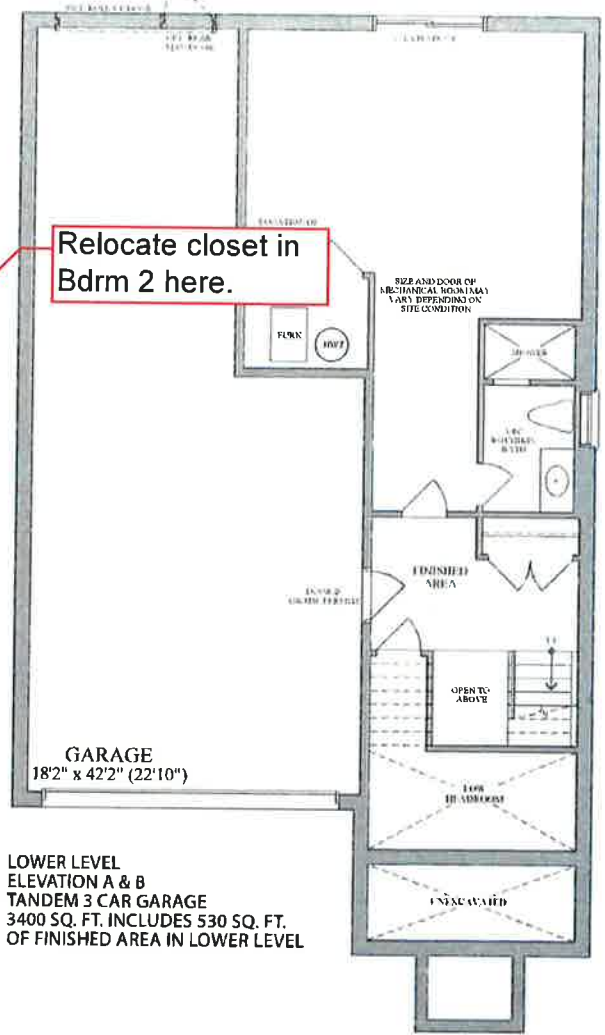

Install Exterior Double Door system - does not come with a screen

Add rough-in for hot/cold future wet bar

Increase height of garage door

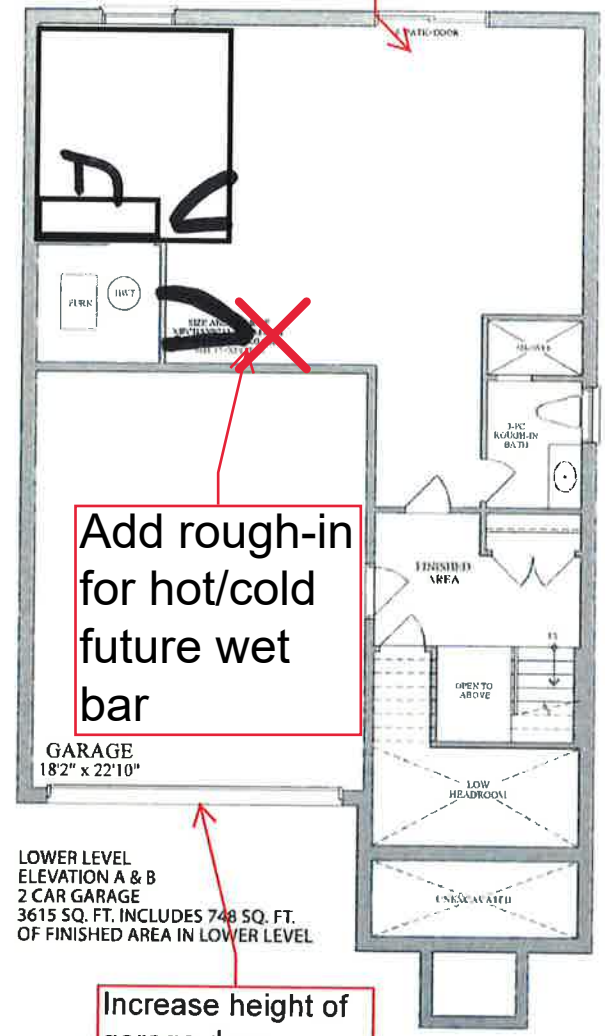

electrical outlet on ceiling

standard light fixture location

LOT 5-15, PH5, PE002, SKETCH

PURCHASER: _____

PURCHASER: _____



Plans and specifications are subject to change without notice. E. & O. E. Actual usable floor space may vary from the stated floor area. All renderings are artist's concept.