


LOT 5-68, INNISFIL

DETAIL OF EXISTING PIPE REINFORCING

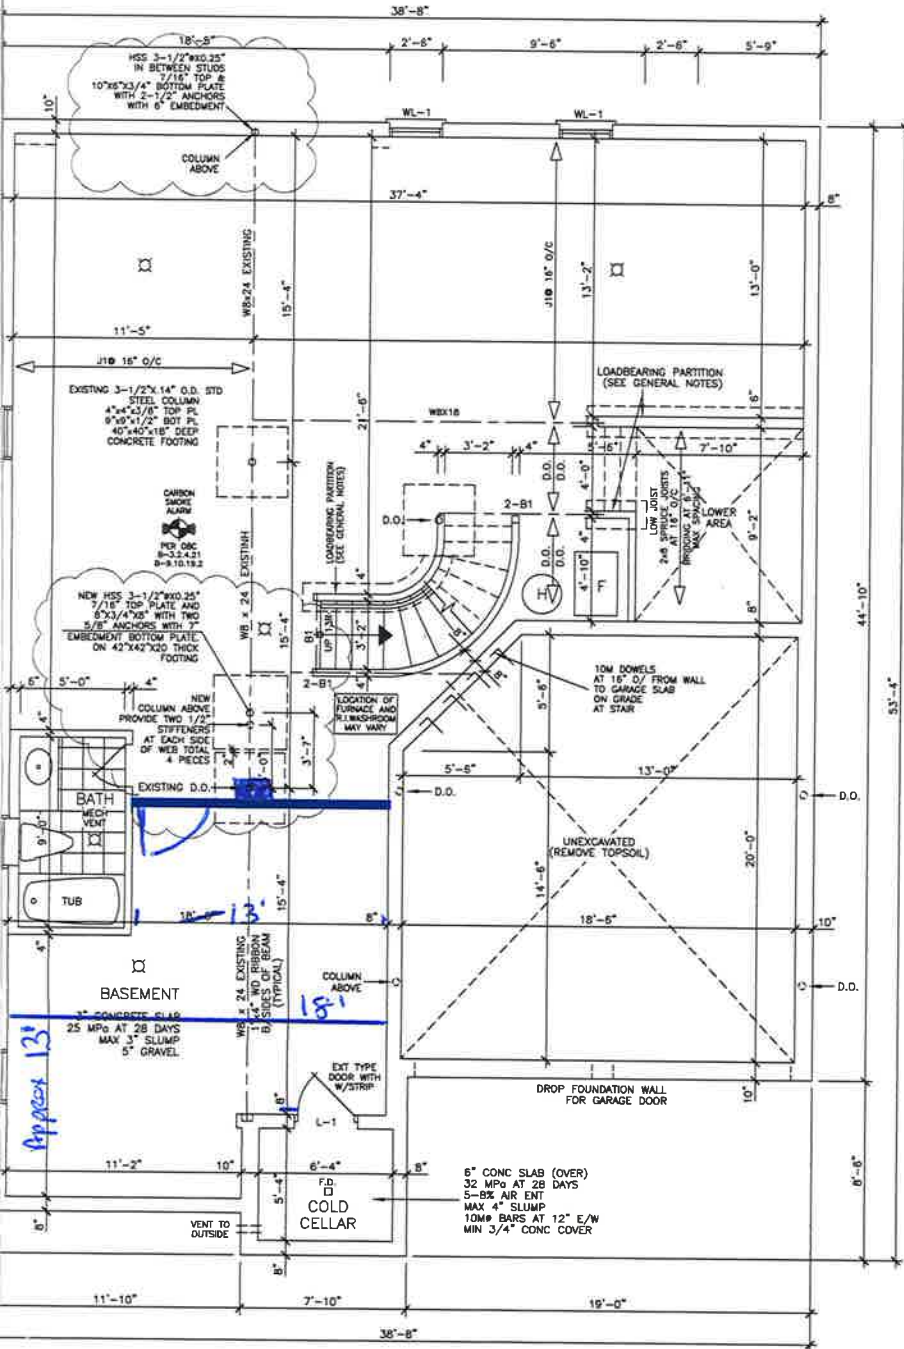

BASEMENT FLOOR PLAN

47' LOT

REVISIONS

#	DATE

LEONARD KALISHENKO
AND ASSOCIATES LIMITED
STRUCTURAL ENGINEERS
FOR STRUCTURAL
DESIGN ONLY



LOT 5-68, PH5
PE006A

Lormel
HOMES

ONTARIO ASSOCIATION
OF
ARCHITECTS

LID ARIENNA
LICENCE
7581

ALL DRAWINGS & SPECIFICATIONS ARE THE PROPERTY
OF THE ARCHITECT AND CANNOT BE USED OR
REPRODUCED WITHOUT HIS APPROVAL.
THE CONTRACTOR SHALL CHECK AND VERIFY ALL
DIMENSIONS ON THE SITE AND REPORT ANY
DISCREPANCIES TO THE ARCHITECT.
DRAWINGS MUST NOT BE SCALED.

ARCHITECTURAL
DESIGN INC.

56 PENNSYLVANIA AVE.
UNIT 1
CONCORD, ONT. L4K 3Y9
TEL 905 660-9393
FAX 905 660-9419

NIPissing
MODEL 3210
LOT 68

PROJECT
PROPOSED
TWO STOREY DWELLING
FOR: LORMEL HOMES
AT: INNISFIL

DRAWING
BASEMENT FLOOR PLAN
AND CROSS SECTION

DATE	JAN '22	PROJECT NO	20-00
DRAWN	N.L.	DRAWING NO	A-2
CHECKED			
SCALE	3/16"=1'-0"		