


LOT 5-13, PH5, STRUCTURAL OPTIONS - PE002

PURCHASER: Fiction Ho (Jun 30, 2022 00:25 EDT)

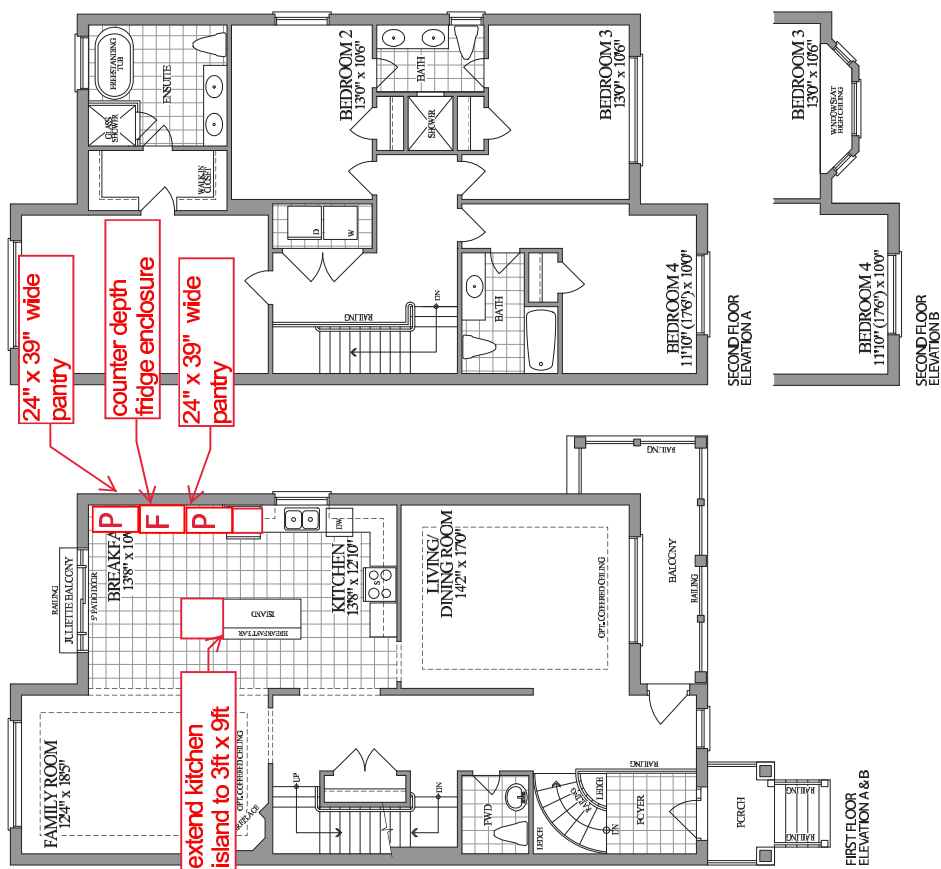

FIRST FLOOR
ELEVATION A & B

SECOND FLOOR
ELEVATION A

SECOND FLOOR

BEDROOM 3

BEDROOM 4

BEDROOM 3

BEDROOM 4

LOWER LEVEL

ELEVATION A & B
2 CAR GARAGE
33350 SQ. FT. INCLUDES 760 SQ. FT.
OF FINISHED AREA IN LOWER LEVEL

CONCRETE LEVEL
ELEVATION A & B
OPT, TANDEM 3 CAR GARAGE
3068 SQ. FT. INCLUDES 478 SQ. FT.
OF FINISHED AREA. IN LOWER LEVEL

