




38'
DESIGNS


The Fraser / Elev. A & B
2250 sq.ft.

change to window is
no longer being done


INCREASE
WINDOW
8'4" x 5'4"

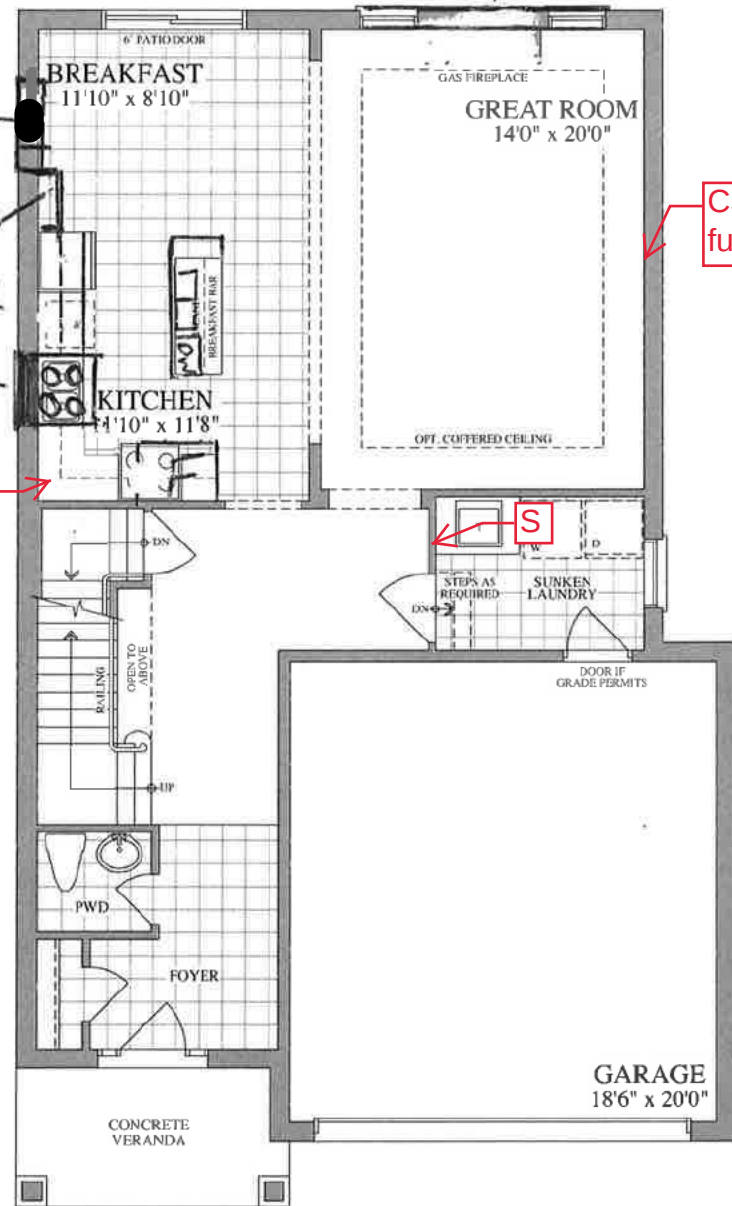


FIRST FLOOR
ELEVATION A & B

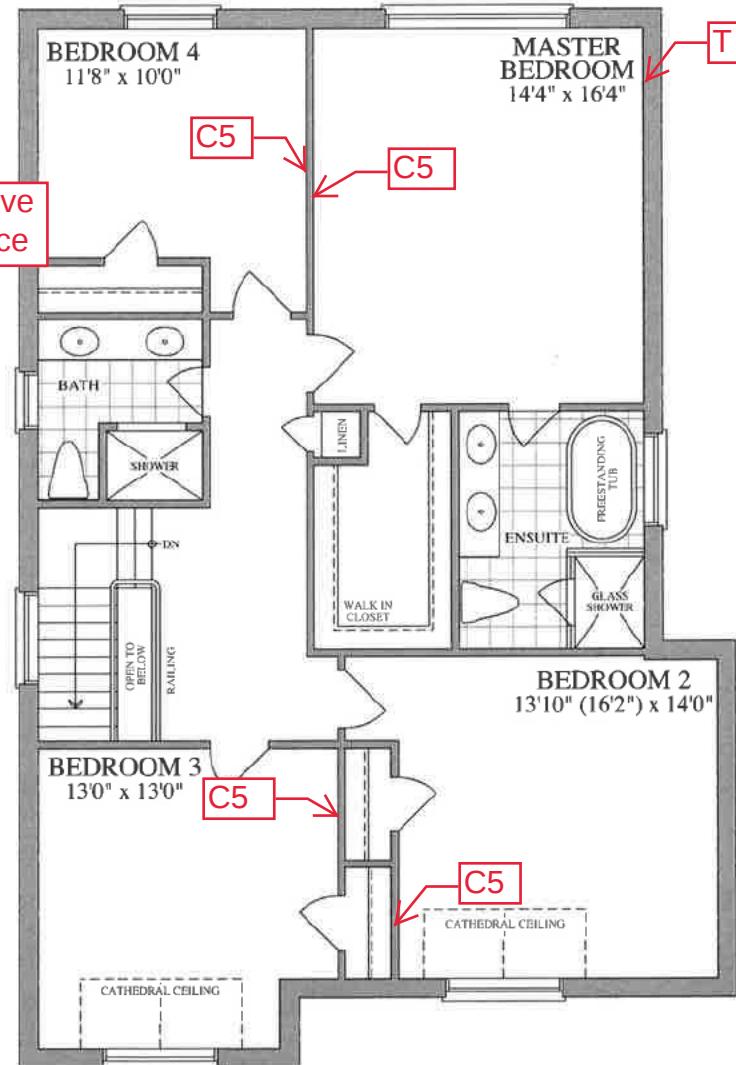

SECOND FLOOR
ELEVATION A

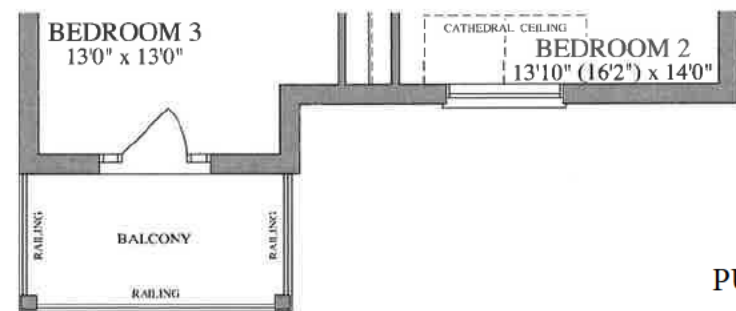

SECOND FLOOR
ELEVATION B

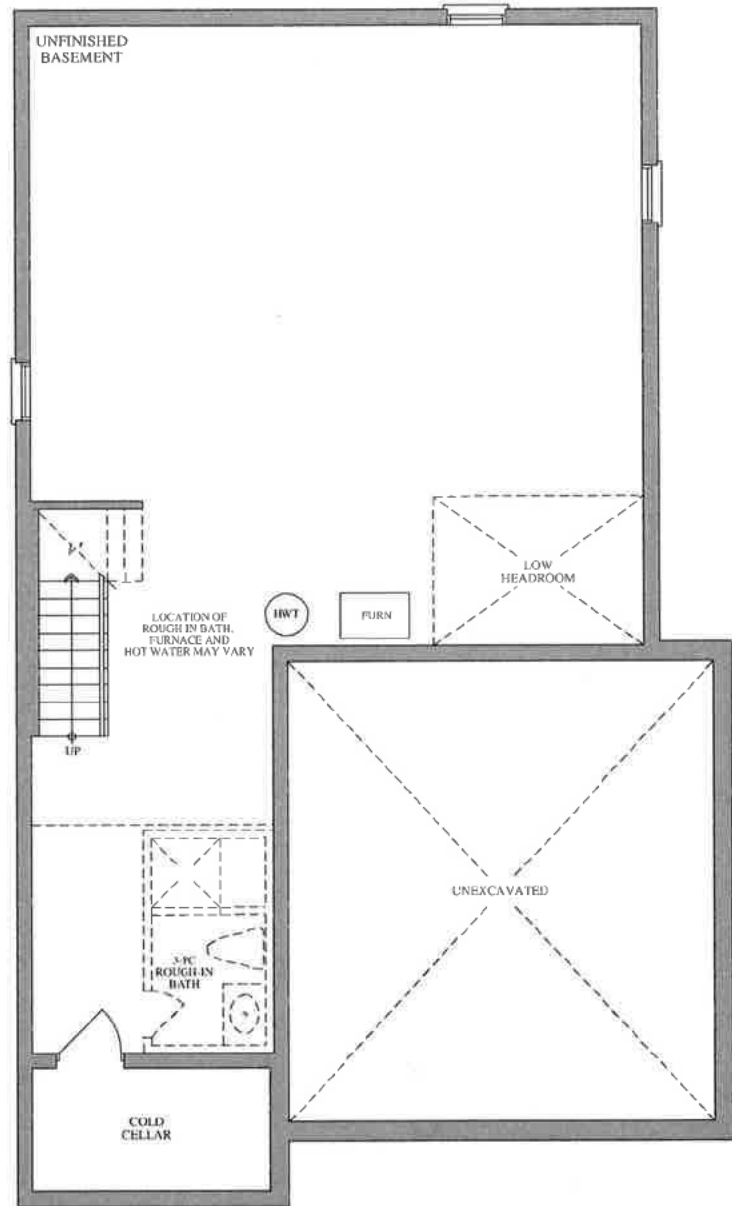

BASEMENT
ELEVATION A & B

PURCHASER: M. Marrano
Marissa Marrano (Aug 29, 2022 13:33 EDT)

PURCHASER: Sam Kasheminejad
Sam Kasheminejad (Aug 29, 2022 13:30 EDT)