


BLK 1-181, INNISFIL, PE004 REVISED MICROWAVE LOCATION



Purchaser's Initial: _____

MICROWAVE W/ TRIM
KIT TO BE INSTALLED
IN BASE CABINET
BESIDE STOVE

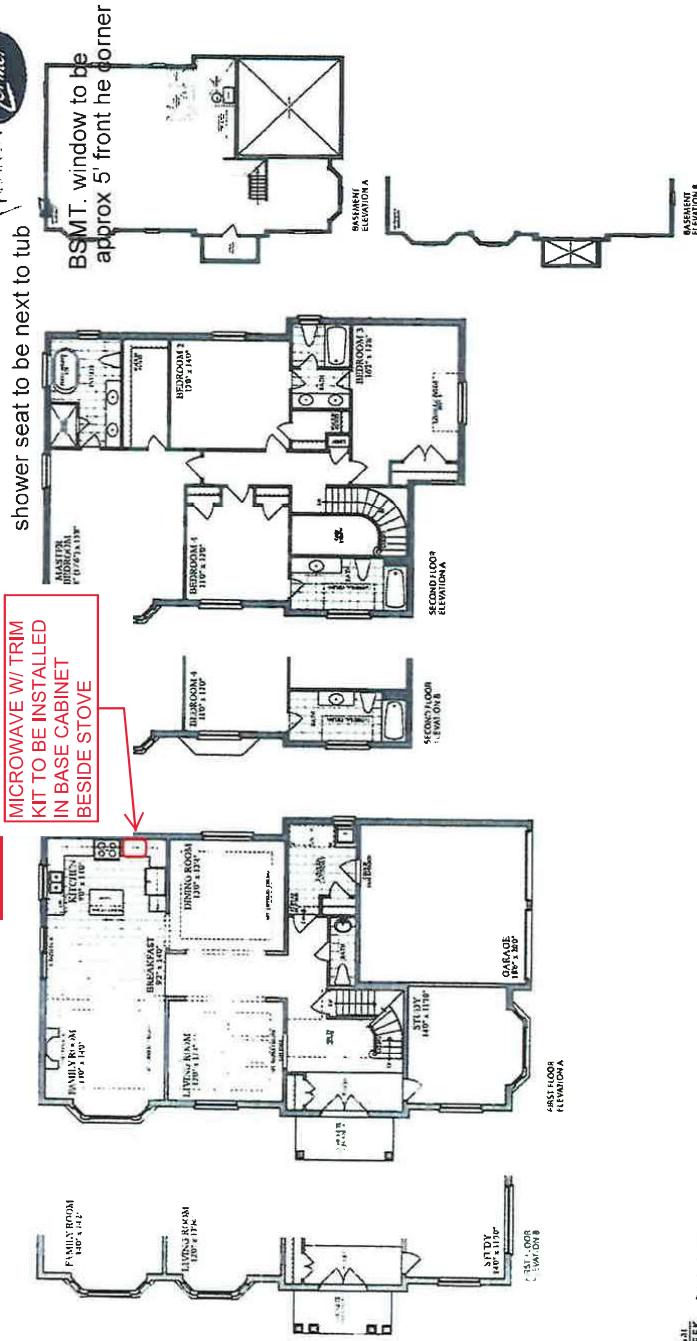

The Madawaska / Elev. A & B
3190 sq.ft.



For more information, visit us online at www.carsons-creek.com or call us at 1-800-368-3688.

Signature:

Email: obubalawfirm@yahoo.com