


LOT 5-49, INNISFIL, PE003


Purchaser's Initial(s): Ly

38'
DESIGNS

The **Manitou** / Elev. A & B
2480 sq.ft.

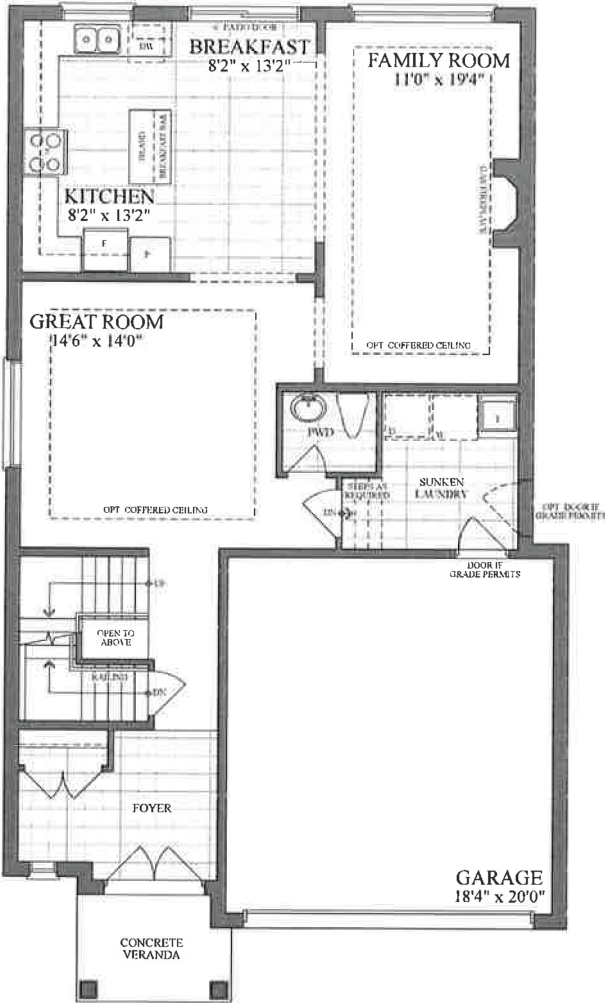


FIRST FLOOR
ELEVATION A & B

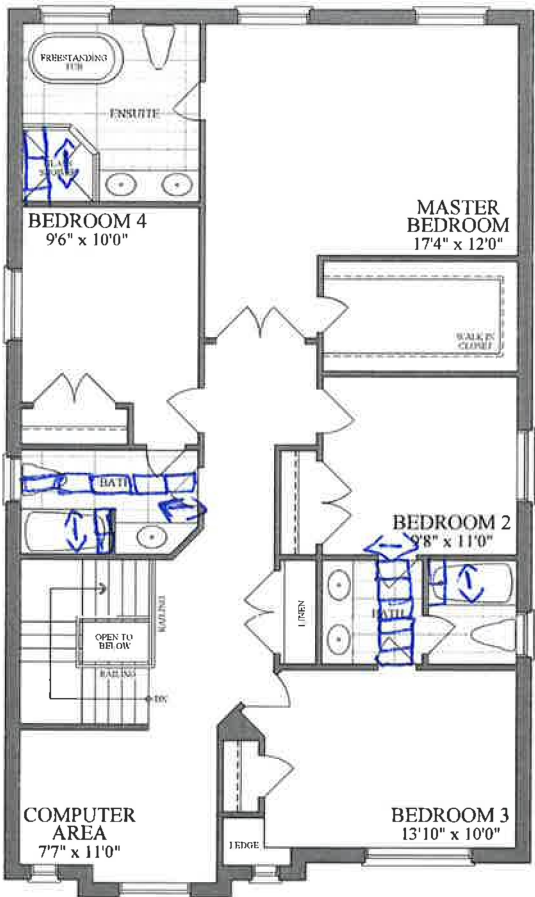

SECOND FLOOR
ELEVATION A



SECOND FLOOR
ELEVATION B

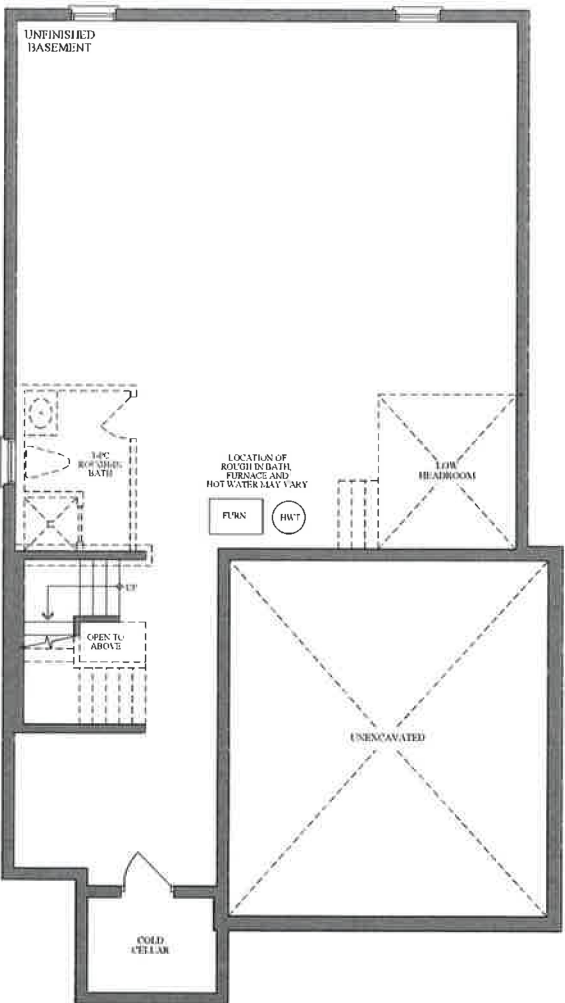

BASEMENT
ELEVATION A & B



Plans and specifications are subject to change without notice. E. & O. E. Actual usable floor space may vary from the stated floor area. All renderings are artist's concept.